


FAIRMOUNT LAKE

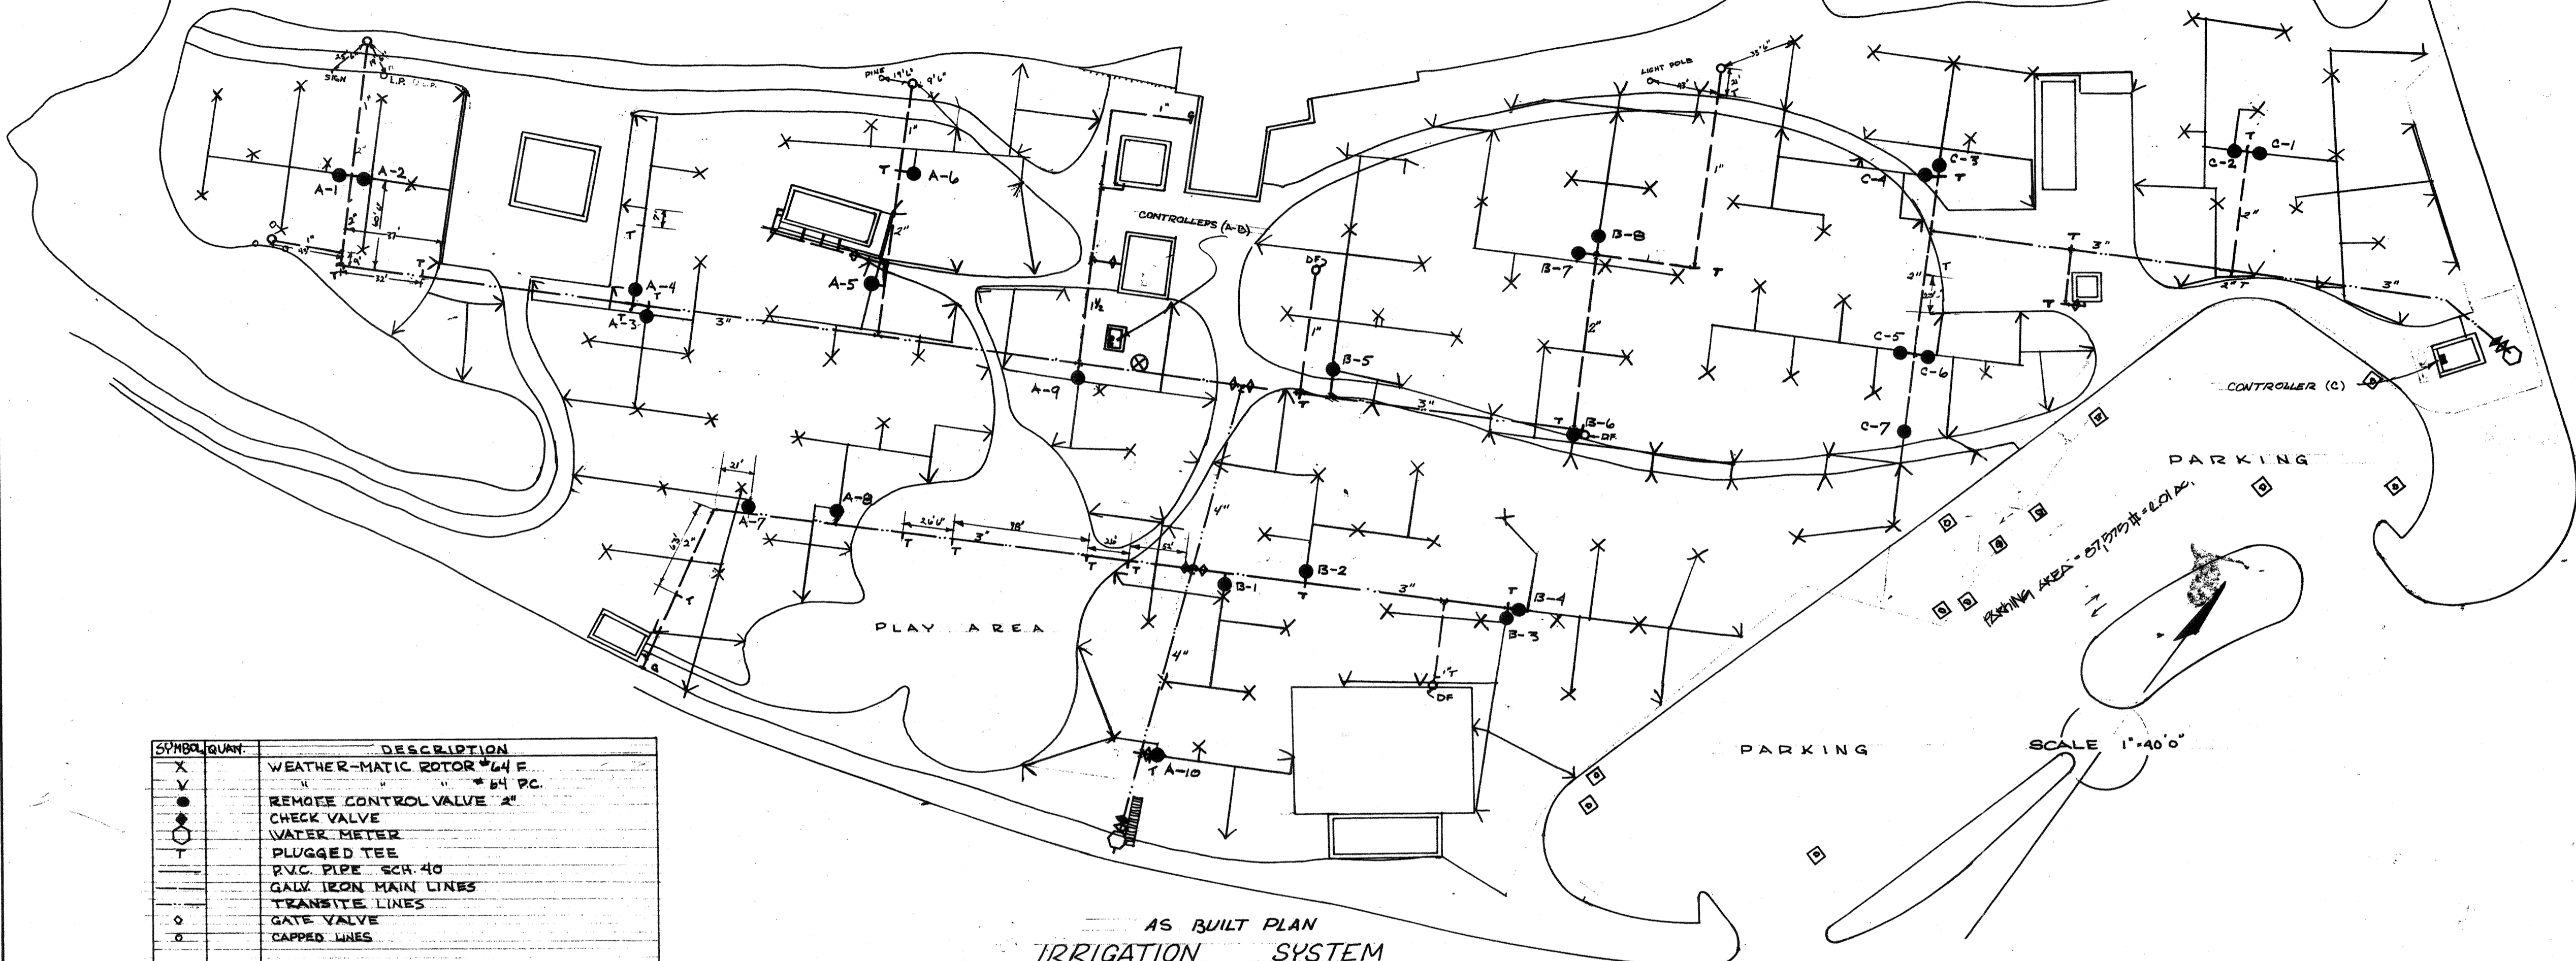

| SYMBOL | QUAN. | DESCRIPTION |
|--------|-------|--------------------------|
| X | | WEATHER-MATIC ROTOR #4 F |
| Y | | " " #4 PC. |
| ● | | REMOTE CONTROL VALVE 2" |
| ○ | | CHECK VALVE |
| ○ | | WATER METER |
| T | | PLUGGED TEE |
| --- | | P.V.C. PIPE SCH. 40 |
| --- | | Galv. IRON MAIN LINES |
| --- | | TRANSITE LINES |
| ○ | | GATE VALVE |
| ○ | | CAPPED LINES |

AS BUILT PLAN
IRRIGATION SYSTEM
FAIRMOUNT PARK
CITY OF RIVERSIDE PARK & RECREATION DEPT.

SCALE 1"=40'

60' SCALE

116 P-88