


AS BUILT

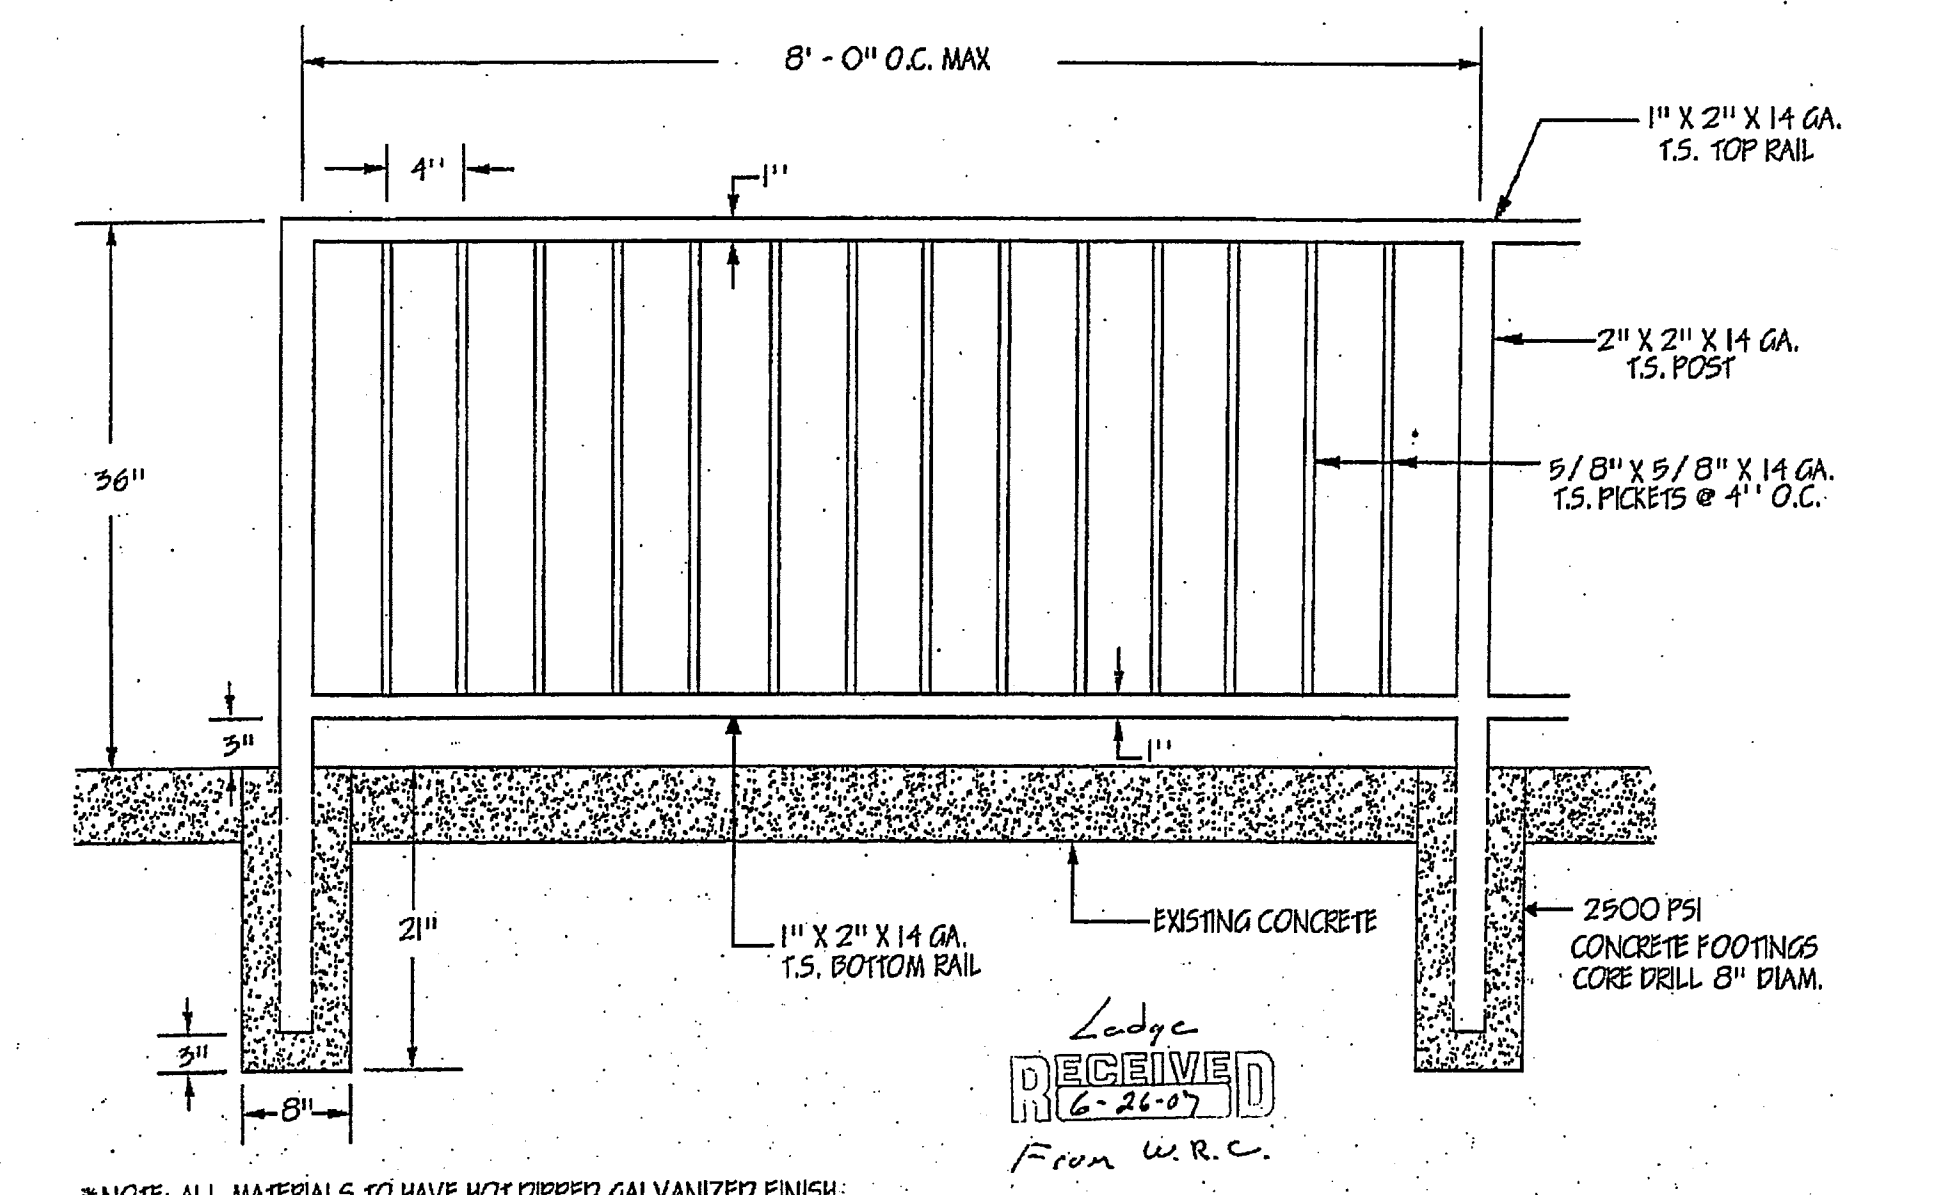

NOTE: ALL MATERIALS TO HAVE HOT DIPPED GALVANIZED FINISH.
 NOTE: CONTINUOUS WELD ALL CONNECTIONS

SUBMITTED BY: LANDMARK FENCE CO.	SUBMITTED TO: WESTERN RIM CONSTRUCTORS	3' HIGH TUBE STEEL FENCE	N.T.S.
PROJECT: ORANGE TERRACE COMMUNITY PARK		DRAWN BY: GABRIEL C.	PAGE: 3/06/07 22 OF 28

David G. Williams
 License No. 62427
 State of California