

CONTROLLER NOTES:

EXISTING CONTROLLER 'E3' SHALL BE REPLACED WITH CALSENSE ET2000. CONTROLLER SHALL BE WALL MOUNTED UTILIZING CALSENSE FACTORY ASSEMBLED 'SSBP' AND CONNECTED TO EXISTING POWER WIRES.

CONTROLLER SHALL BE FURNISHED AS:
Controller E3.....ET2000-24-ML-FL-RR-TPP-SSBP-LRDOMERR


EXISTING CONTROLLERS 'E1' AND 'E2' SHALL BE REPLACED WITH CALSENSE ET2000-32 CONTROLLERS SHALL BE INSTALLED ON PLYWOOD BACKBOARD PER CALSENSE SPECIFICATIONS, AND CONNECTED TO EXISTING POWER WIRES. WIRE CONTROLLER PER DETAIL 'Y', SHEET ID-1.

CONTROLLER SHALL BE FURNISHED AS:
Controller E1.....ET2000-32-MLR-FL-RR-TPP-LRDOMERR
Controller E2.....ET2000-32-ML-FL-RR-TPP-LRDOMERR


CONTROLLER ASSEMBLY IS AVAILABLE FROM 'UNITED GREEN TECH', MARK DELANGE @ 908-794-4511

CONTROLLER SHALL BE MOUNTED, WIRED, AND GROUNDED PER MANUFACTURER'S DIRECTIONS. 120V POWER FOR CONTROLLER TO BE PROVIDED BY OTHERS. CONTRACTOR SHALL MAKE ALL FINAL CONNECTIONS PER LOCAL CODES.


ALL FIVE CONTROLLERS WILL BE CONNECTED (DAISY-CHAINED) WITH Paige P-7171-D CABLING, IN CONDUIT, FOR COMMUNICATIONS PURPOSES.

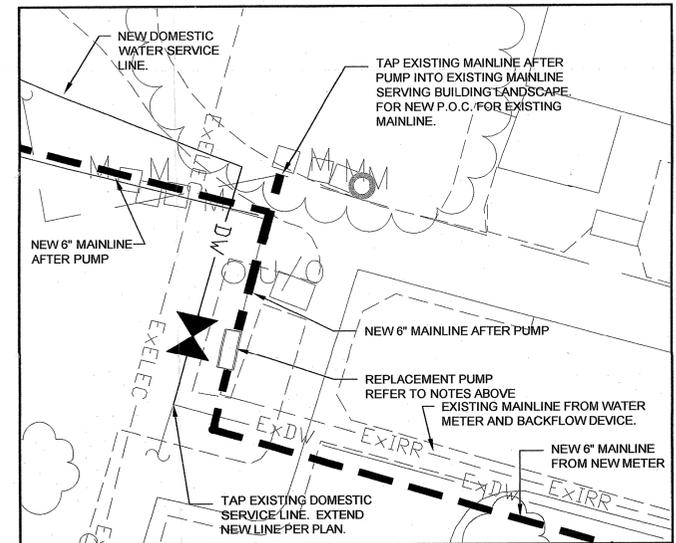

DETAIL 'A' - EX. IRRIGATION NEW P.O.C.

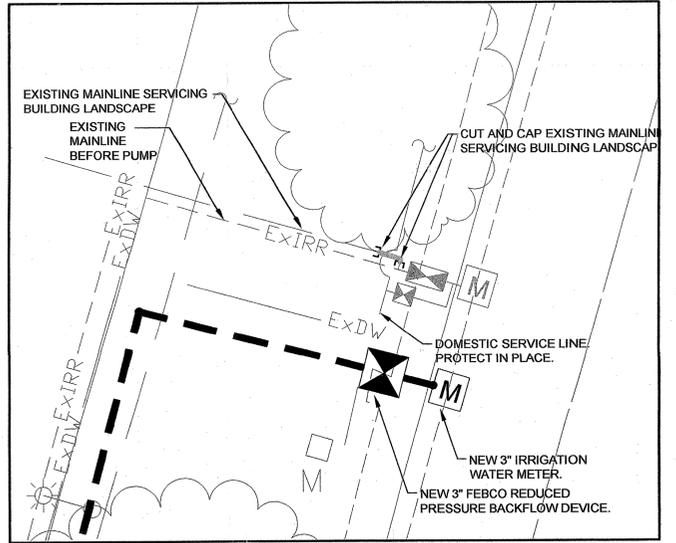

DETAIL 'B' - CUT AND CAP EX. IRRIGATION

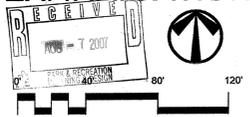

RA LANDSCAPE ARCHITECTS PLANNERS, INC.

3612 MISSION INN AVE
RIVERSIDE, CALIFORNIA 92501
LIC. #1512
PH. (951) 781-1930
FAX (951) 686-8091

CLIENT:
**THE CITY OF RIVERSIDE
PARK AND RECREATION DEPT.**
3900 Main Street
Riverside, California 92522

PROJECT:
**Reid Park
Expansion**
Orange St. and Garner Rd.

REVISIONS	DATE	BY
CONFORMED SET	9/5/06	MH



SHEET TITLE
IRRIGATION PLAN

DESIGNED	MH
DRAWN	MH
CHECKED	DG
DATE	11-9-05
SCALE	PER PLAN
JOB NO.	03111

SHEET
IP-2
15 OF 19 SHEETS