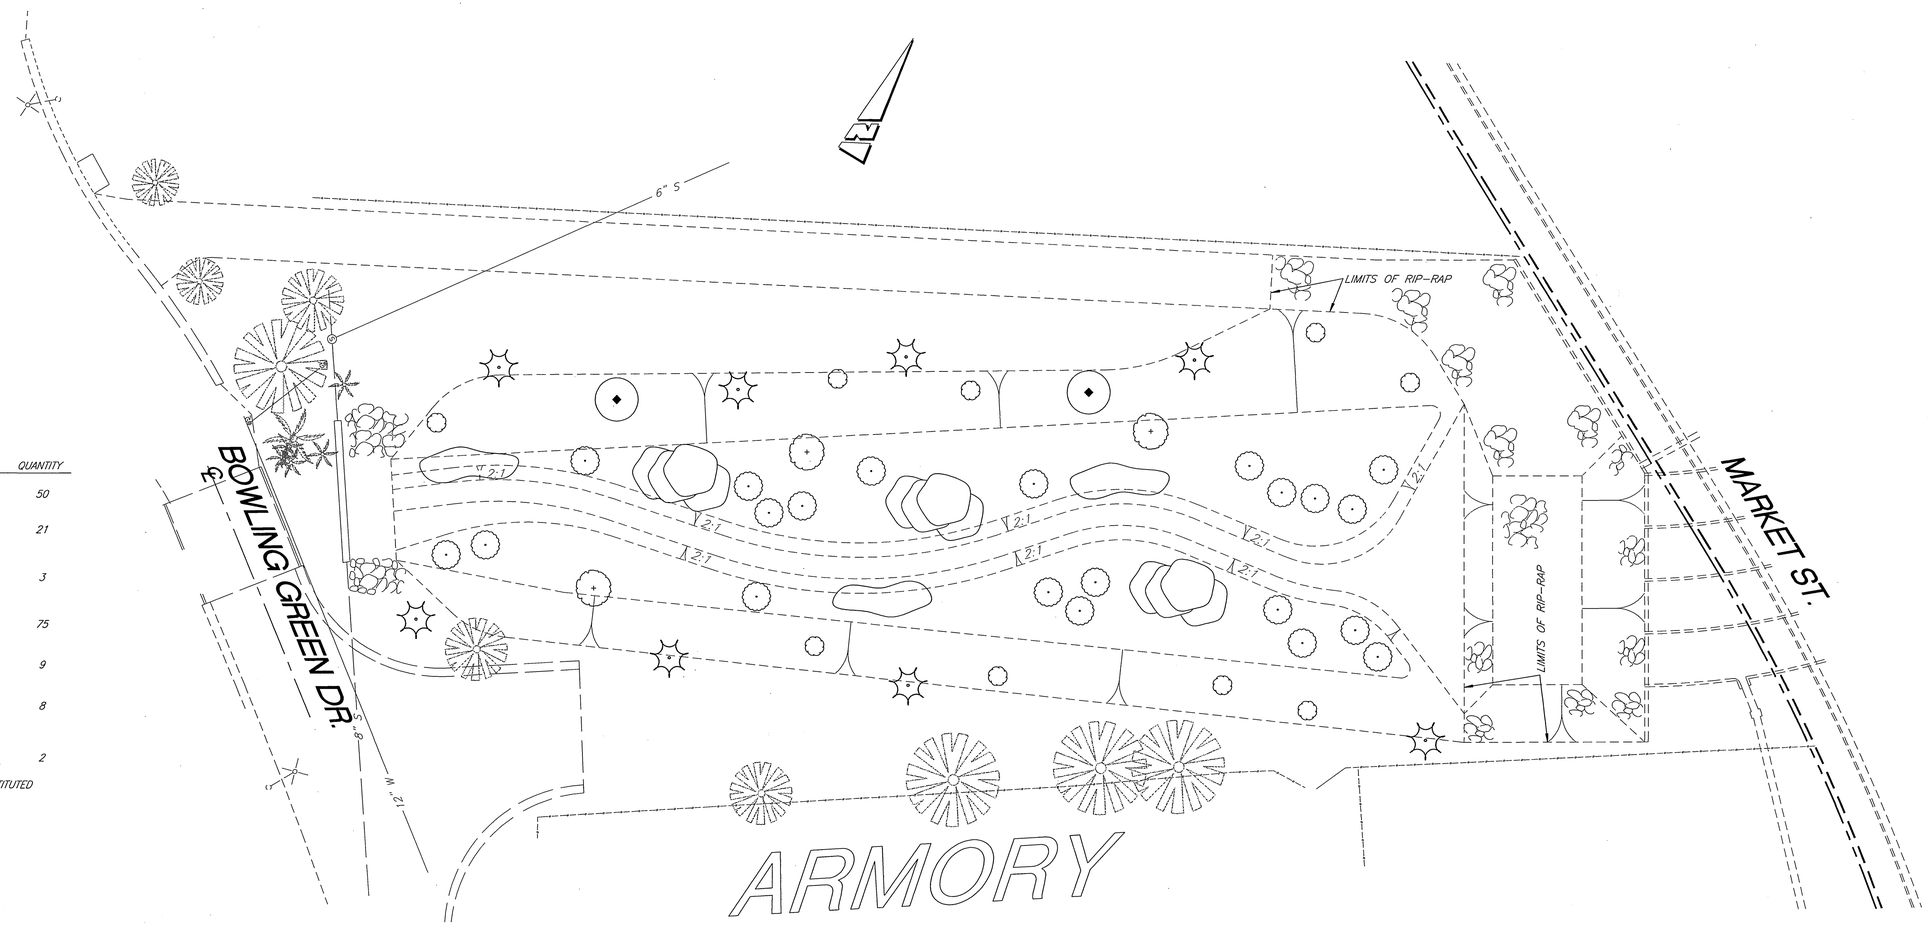

PLANT LEGEND

SYMBOL	BOTANICAL NAME/COMMON NAME	SIZE	QUANTITY
	JUNCUS PACIFICUS/RUSH GRASS	1 GAL.	50
	SALIX GOODINGII/BLACK WILLOW	*1 GAL.	21
	POPULUS FREMONTII/FREMONT COTTONWOOD	5 GAL.	3
	CALMAGROSTIS PURPURASCENS/PURPLE REED GRASS	1 GAL.	75
	RHUS OVATA/SUGARBUSH	5 GAL.	9
	HETEROMELES ARBUTIFOLIA/TOYON	5 GAL.	8
	ACACIA LATIFOLIA/GOLDEN WATTLE	5 GAL.	2

* CUTTINGS MAY BE SUBSTITUTED

PARK AND RECREATION NOTES:

1. ALL RELATED WORK SHALL CONFORM TO THE CITY OF RIVERSIDE PARK AND RECREATION DEPT. STANDARDS FOR PLANTING AND IRRIGATION WORK.
2. WHEN CALLING FOR INSPECTIONS NOTIFY THE ENGINEER A MIN. OF TWO WORKING DAYS IN ADVANCE TO SCHEDULE AN INSPECTION. A FIELD NOTICE WILL BE ISSUED AS WRITTEN APPROVAL FOR EACH STAGE OF INSPECTION. A VERBAL APPROVAL WILL NOT BE ACCEPTABLE. INSPECTIONS ARE REQUIRED:
   - A. AFTER COMPLETION OF THE FINAL GRADING OF THE CHANNEL FOR SPOTTING PLANTING PITS.
   - B. WHILE DIGGING PLANT PITS AND PLANTING TREES.
   - C. AFTER PLANTING AND ALL OTHER INDICATED OR SPECIFIED WORK HAS BEEN COMPLETED, FOR START OF MAINTENANCE.
   - D. AT END OF MAINTENANCE PERIOD, THE CONTRACTOR SHALL CALL THE ENGINEER AT (909) 826-5671 FOR A FINAL ACCEPTANCE INSPECTION IN ORDER TO BE RELEASED FROM MAINTENANCE. CONTRACTOR'S BONDS WILL NOT BE RELEASED UNTIL AFTER RECEIPT OF WRITTEN NOTIFICATION FROM THE CITY THAT THE TREES PASS FINAL INSPECTION AND THE CITY IS ASSUMING MAINTENANCE RESPONSIBILITY.
3. PLANTING LOCATIONS SHOWN ON THE PLAN ARE APPROXIMATE.
4. THE CONTRACTOR SHALL BE RESPONSIBLE FOR MAINTENANCE OF ALL PLANTINGS, EXCEPT TREES, FOR A MINIMUM PERIOD OF NINETY (90) CALENDAR DAYS.

* AS-BUILT PER PLANS 9-30-05 4H

ENGINEER IN RESPONSIBLE CHARGE
PHILIP L. HANNAWI
R.C.E. No. 44747 expires 3/31/06
DATE 3/20/03

REGISTERED PROFESSIONAL ENGINEER PHILIP L. HANNAWI No. 44747 Exp. 3-31-2006 CIVIL STATE OF CALIFORNIA

MARK	REVISIONS	APPR.	DATE

DESIGNED BY KARL DRAWN BY KARL CHECKED BY

CITY OF RIVERSIDE, CALIFORNIA
PUBLIC WORKS DEPARTMENT

APPROVED BY	BY	DATE
PRINCIPAL ENGINEER PARK & REC. DEPT.		3/14/03

APPROVED BY
CITY ENGINEER
DATE 3/24/03

UNIVERSITY WASH CHANNEL STAGE 4
WETLANDS PLANTING
MARKET ST. TO BOWLING GREEN DR.

HORIZ. SCALE: 1" = 20'

ACCT. NO.: 9217200601-440446xx

D-693-L

SHEET 1 OF 2

INDEXED 8-05-04 4H

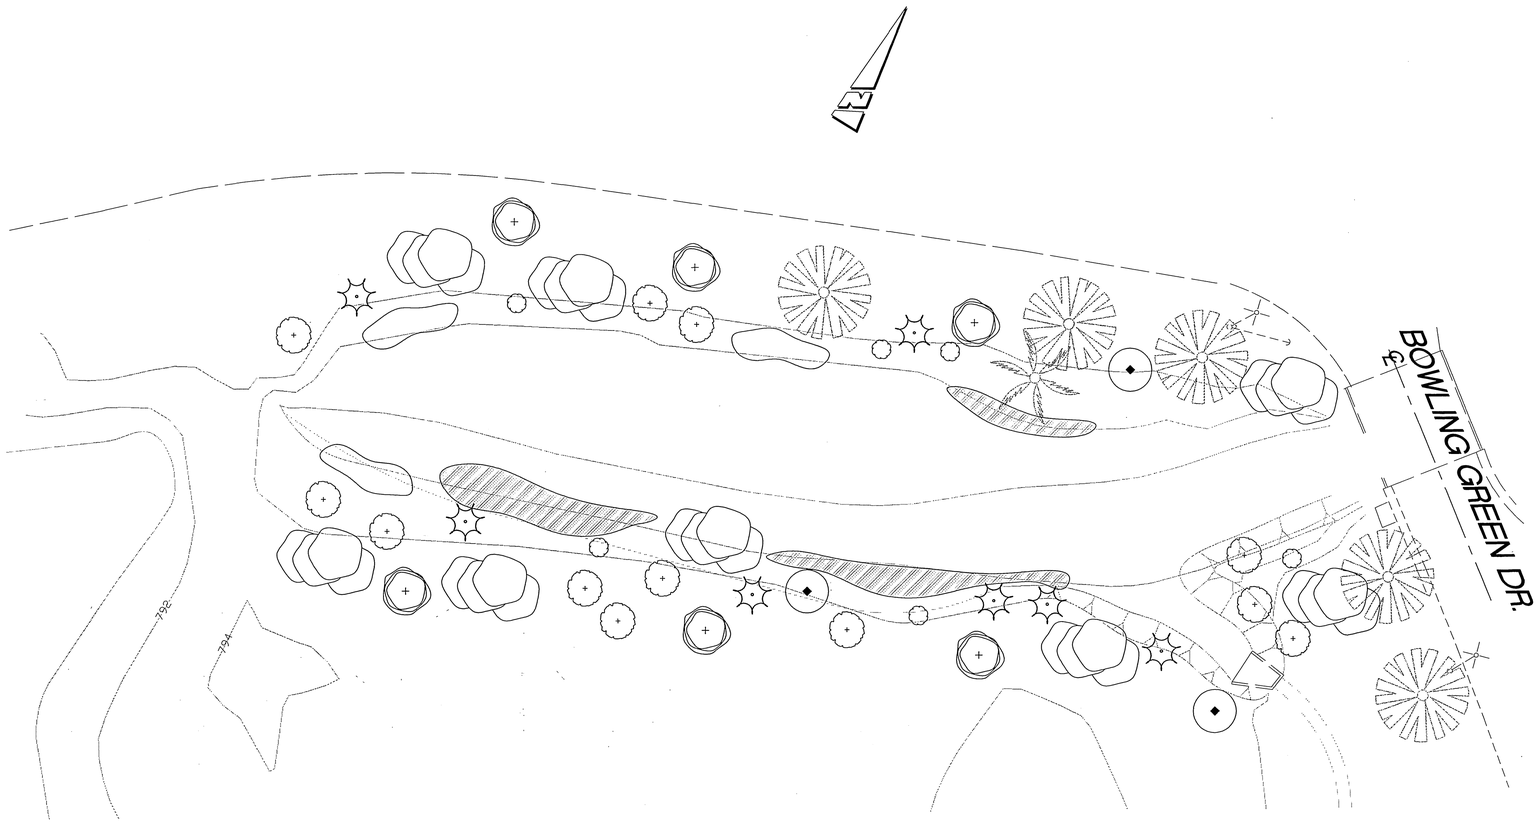

PLANT LEGEND

SYMBOL	BOTANICAL NAME/COMMON NAME	SIZE	QUANTITY
	JUNCUS PACIFICUS/RUSH GRASS	1 GAL.	50
	TYHPA SSP./CATTAIL	1 GAL.	200
	POPULUS FREMONTII/FREMONT COTTONWOOD	5 GAL.	12
	CALMAGROSTIS PURPURASCENS/PURPLE REED GRASS	1 GAL.	125
	RHUS OVATA/SUGARBUSH	5 GAL.	6
	HETEROMELES ARBUTIFOLIA/TOYON	5 GAL.	7
	ACACIA LATIFOLIA/GOLDEN WATTLE	5 GAL.	3
	BACCHARIS SALICIFOLIA/MULE FAT	TREE BAND	150

*AS-BUILT PER PLANS 9-30-05 FH

ENGINEER IN RESPONSIBLE CHARGE
PHILIP L. HANNAWI
R.C.E. No. 44747 expires 3/31/06
DATE 3/20/03

REGISTERED PROFESSIONAL ENGINEER
PHILIP L. HANNAWI
No. 44747
Exp. 3-31-2006
CIVIL
STATE OF CALIFORNIA

MARK	REVISIONS	APPR.	DATE

DESIGNED BY KARL DRAWN BY KARL CHECKED BY

CITY OF RIVERSIDE, CALIFORNIA
PUBLIC WORKS DEPARTMENT

APPROVED BY	BY	DATE
PRINCIPAL ENGINEER PARKS DEPARTMENT		

APPROVED BY
CITY ENGINEER
DATE 3/24/03

UNIVERSITY WASH CHANNEL STAGE 4
WETLANDS PLANTING
MARKET ST. TO BOWLING GREEN DR.

ACCT. NO.: 9217200601-440446xx

D-693-L

SHEET 2 OF 2

HORIZ. SCALE: 1" = 20'

INDEXED 8-05-04 FH