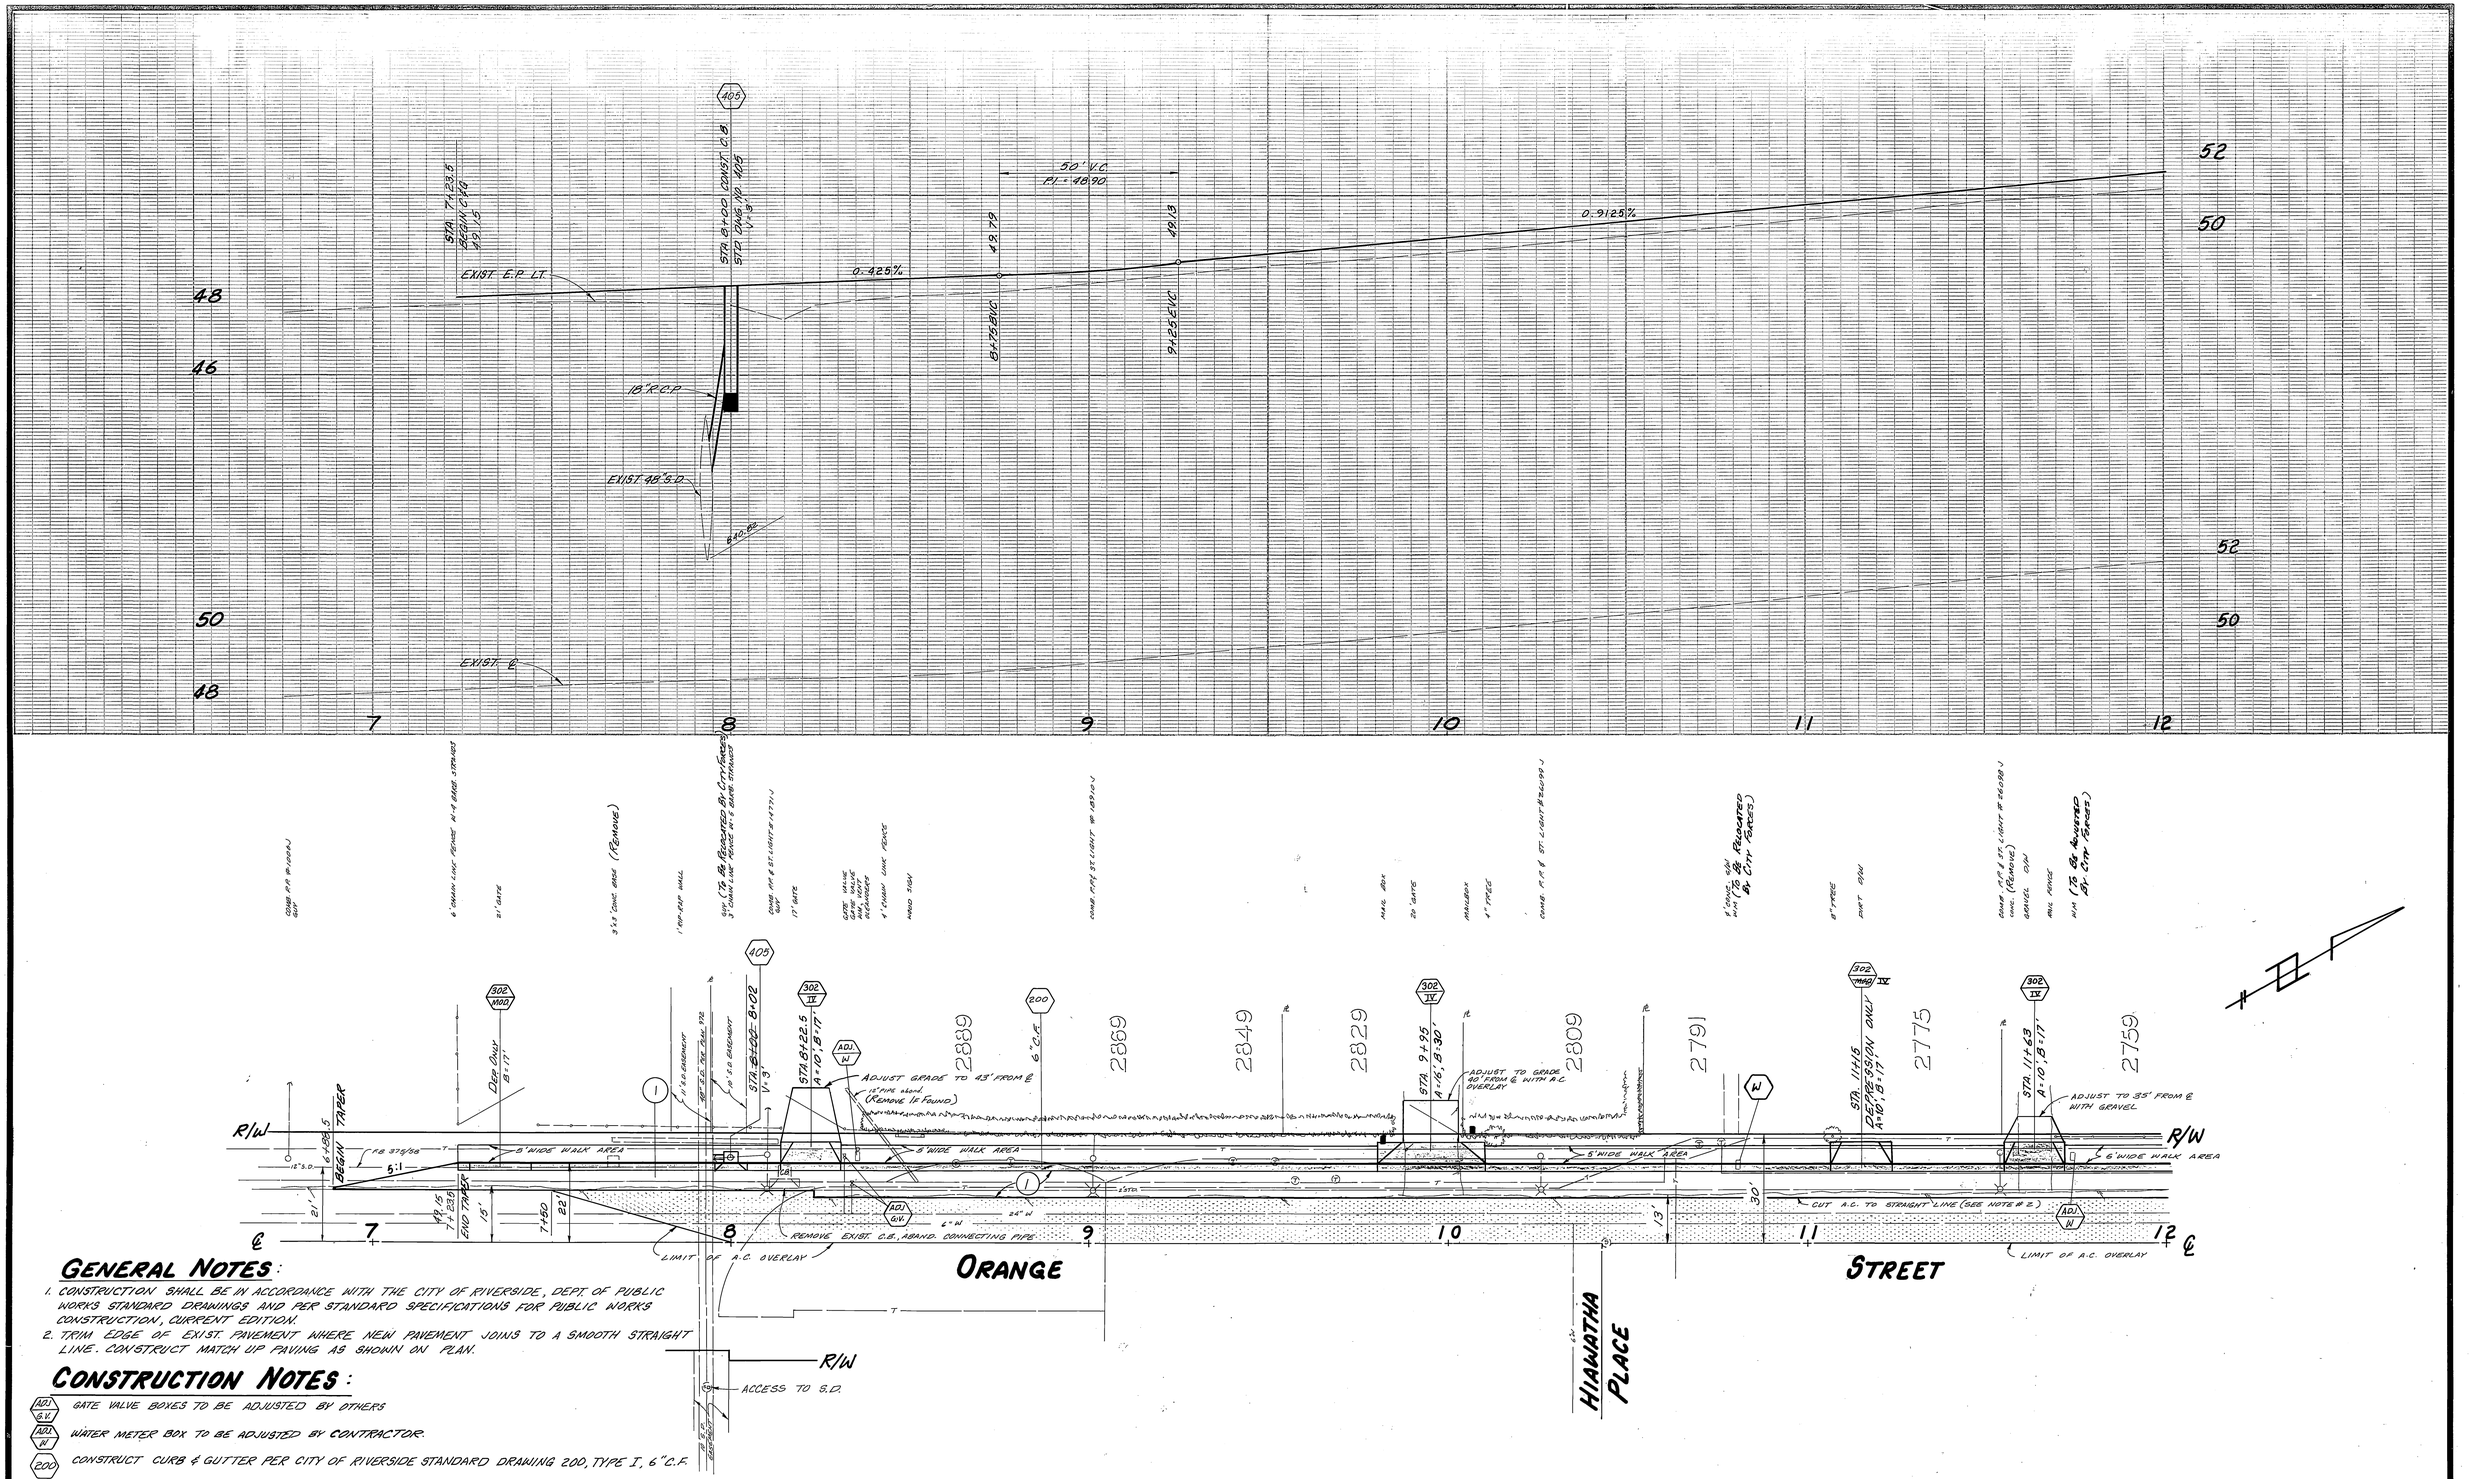

GENERAL NOTES:

1. CONSTRUCTION SHALL BE IN ACCORDANCE WITH THE CITY OF RIVERSIDE, DEPT. OF PUBLIC WORKS STANDARD DRAWINGS AND PER STANDARD SPECIFICATIONS FOR PUBLIC WORKS CONSTRUCTION, CURRENT EDITION.
2. TRIM EDGE OF EXIST. PAVEMENT WHERE NEW PAVEMENT JOINS TO A SMOOTH STRAIGHT LINE. CONSTRUCT MATCH UP PAVING AS SHOWN ON PLAN.

CONSTRUCTION NOTES:

- (ADJ G.V.) GATE VALVE BOXES TO BE ADJUSTED BY OTHERS
- (ADJ W) WATER METER BOX TO BE ADJUSTED BY CONTRACTOR.
- (200) CONSTRUCT CURB & GUTTER PER CITY OF RIVERSIDE STANDARD DRAWING 200, TYPE I, 6" C.F.
- (302 IV) CONSTRUCT D/W APPROACH PER CITY OF RIVERSIDE STANDARD DRAWING 302, TYPE IV, A & B AS NOTED.
- (405) CONSTRUCT CATCH BASIN PER CITY OF RIVERSIDE STANDARD DRAWING 405, V = 3'
- (304) CONSTRUCT WHEELCHAIR RAMP PER CITY OF RIVERSIDE STANDARD DRAWING 304.
- (1) CONSTRUCT .25' PAVING OVER .65' C.A.B.
- (W) TO BE RELOCATED BY CITY FORCES.

* AS BUILT 2-28-90 BH

ENGINEER IN RESPONSIBLE CHARGE
HANS J. KAMRATH
R.C.E. 14712 expires 3/31/89
DATE 7/26/1988

REGISTERED PROFESSIONAL ENGINEER HANS J. KAMRATH NO: 14712 CIVIL STATE OF CALIFORNIA

MARK	REVISIONS	APPR.	DATE

DESIGNED BY DH DRAWN BY ZE CHECKED BY

CITY OF RIVERSIDE
PUBLIC WORKS DEPARTMENT

APPROVED BY	DATE	BY
PRINCIPAL ENGINEER	9-12-88	
PARK DEPARTMENT		
TRAFFIC DIVISION	7-26-88	
CHIEF P. W. ENGINEER	9.16	
SURVEY	7-28-88	

APPROVED BY
PUBLIC WORKS DIRECTOR
DATE 9/16/88

ORANGE STREET WIDENING
POPLAR STREET TO 600' S'LY

HUD FUNDED

HORIZ. SCALE: 1" = 20' VERT. SCALE: 1" = 2'

ACCOUNT NO. 15-550-597-30

R-2961

SHEET 1 OF 2

INDEXED 10-3-88 [illegible]

81630

OZALID- NO.1

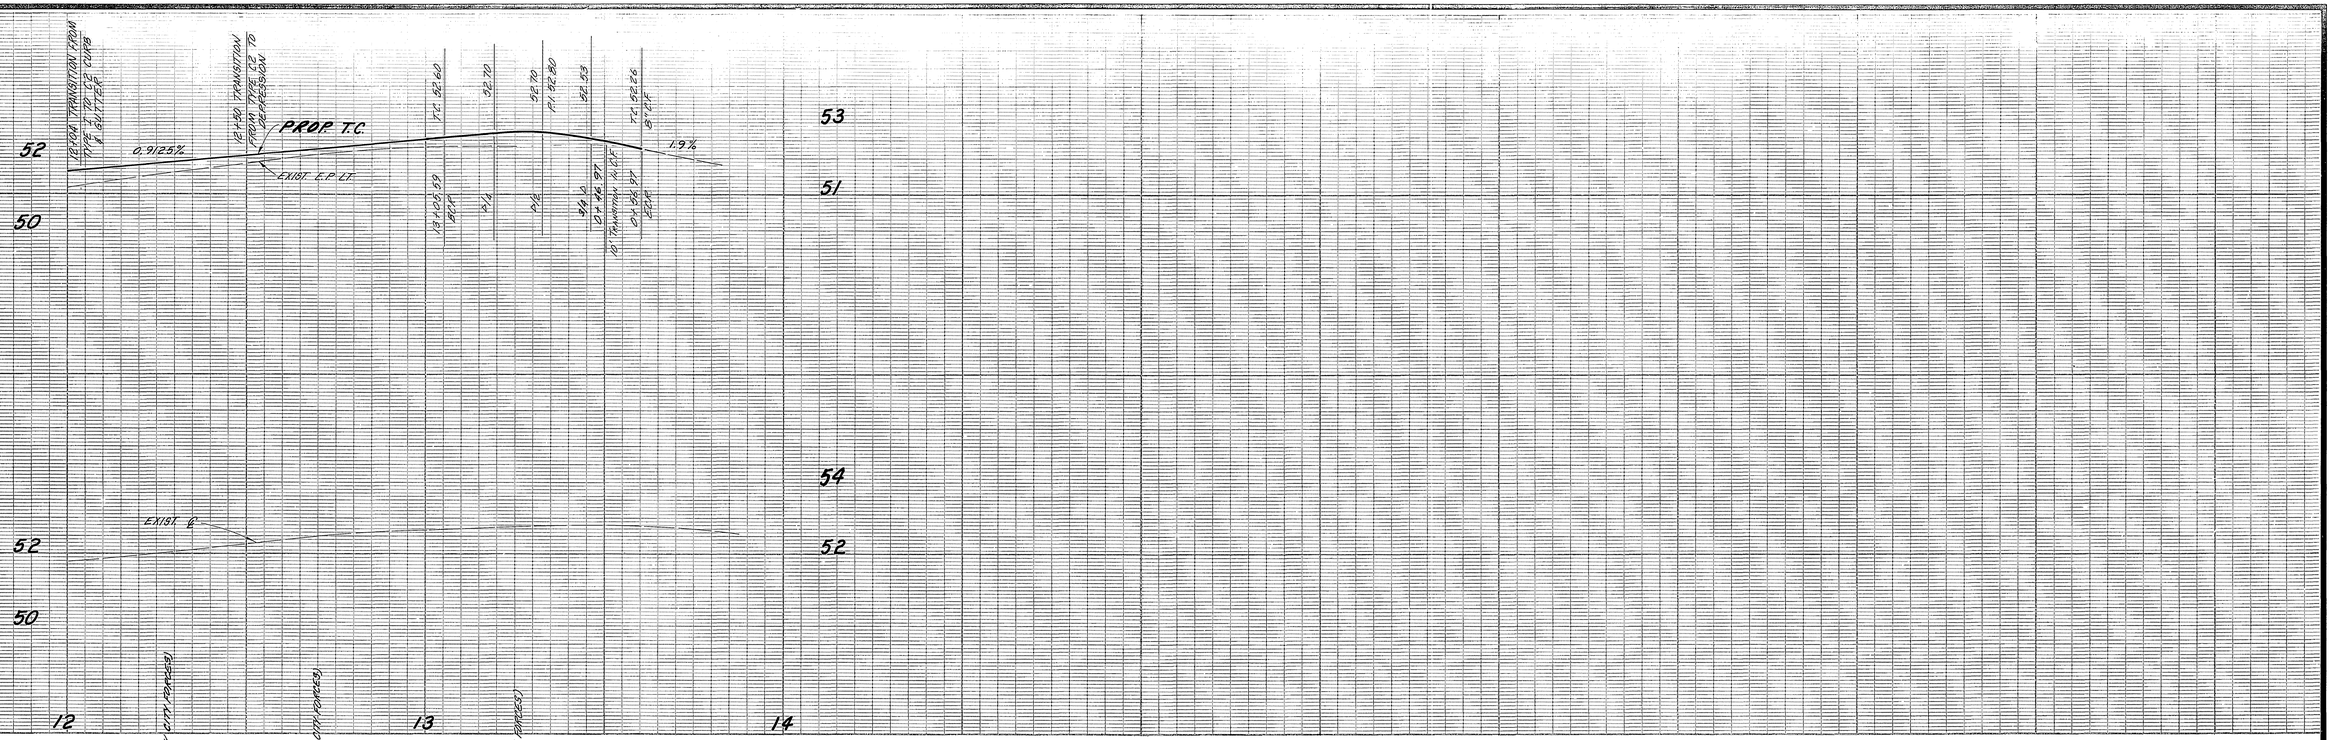

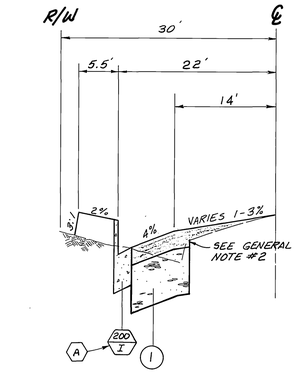

TYPICAL SECTION

SCALE: VERT. 1" = 1' HORIZ. 1" = 10'

(A) AT #2743 ORANGE STREET CONSTRUCT TYPE C2 CURB & GUTTER.

* AS BUILT 2-28-90 Bri

MARK	REVISIONS	APPR.	DATE

DESIGNED BY DWF DRAWN BY SE CHECKED BY

CITY OF RIVERSIDE
PUBLIC WORKS DEPARTMENT

APPROVED BY	DATE	BY
PRINCIPAL ENGINEER	7-12-88	SHC
PARK DEPARTMENT	—	—
TRAFFIC DIVISION	7-14-88	BRD
CHIEF P. W. ENGINEER	9-16	[illegible]
SURVEY 9/15/88	DRAFTING 7-22-88	EZC

APPROVED BY [signature]
PUBLIC WORKS DIRECTOR
DATE 9/16/88

ORANGE STREET WIDENING
POPLAR STREET TO 600' S'LY

HUD FUNDED

HORIZ. SCALE: 1" = 20' VERT. SCALE: 1" = 2'

ACCOUNT NO. 15-550-597-30

R-2961

SHEET 2 OF 2

81630

OZALID- NO.1

INDEXED 10-3-88 GH