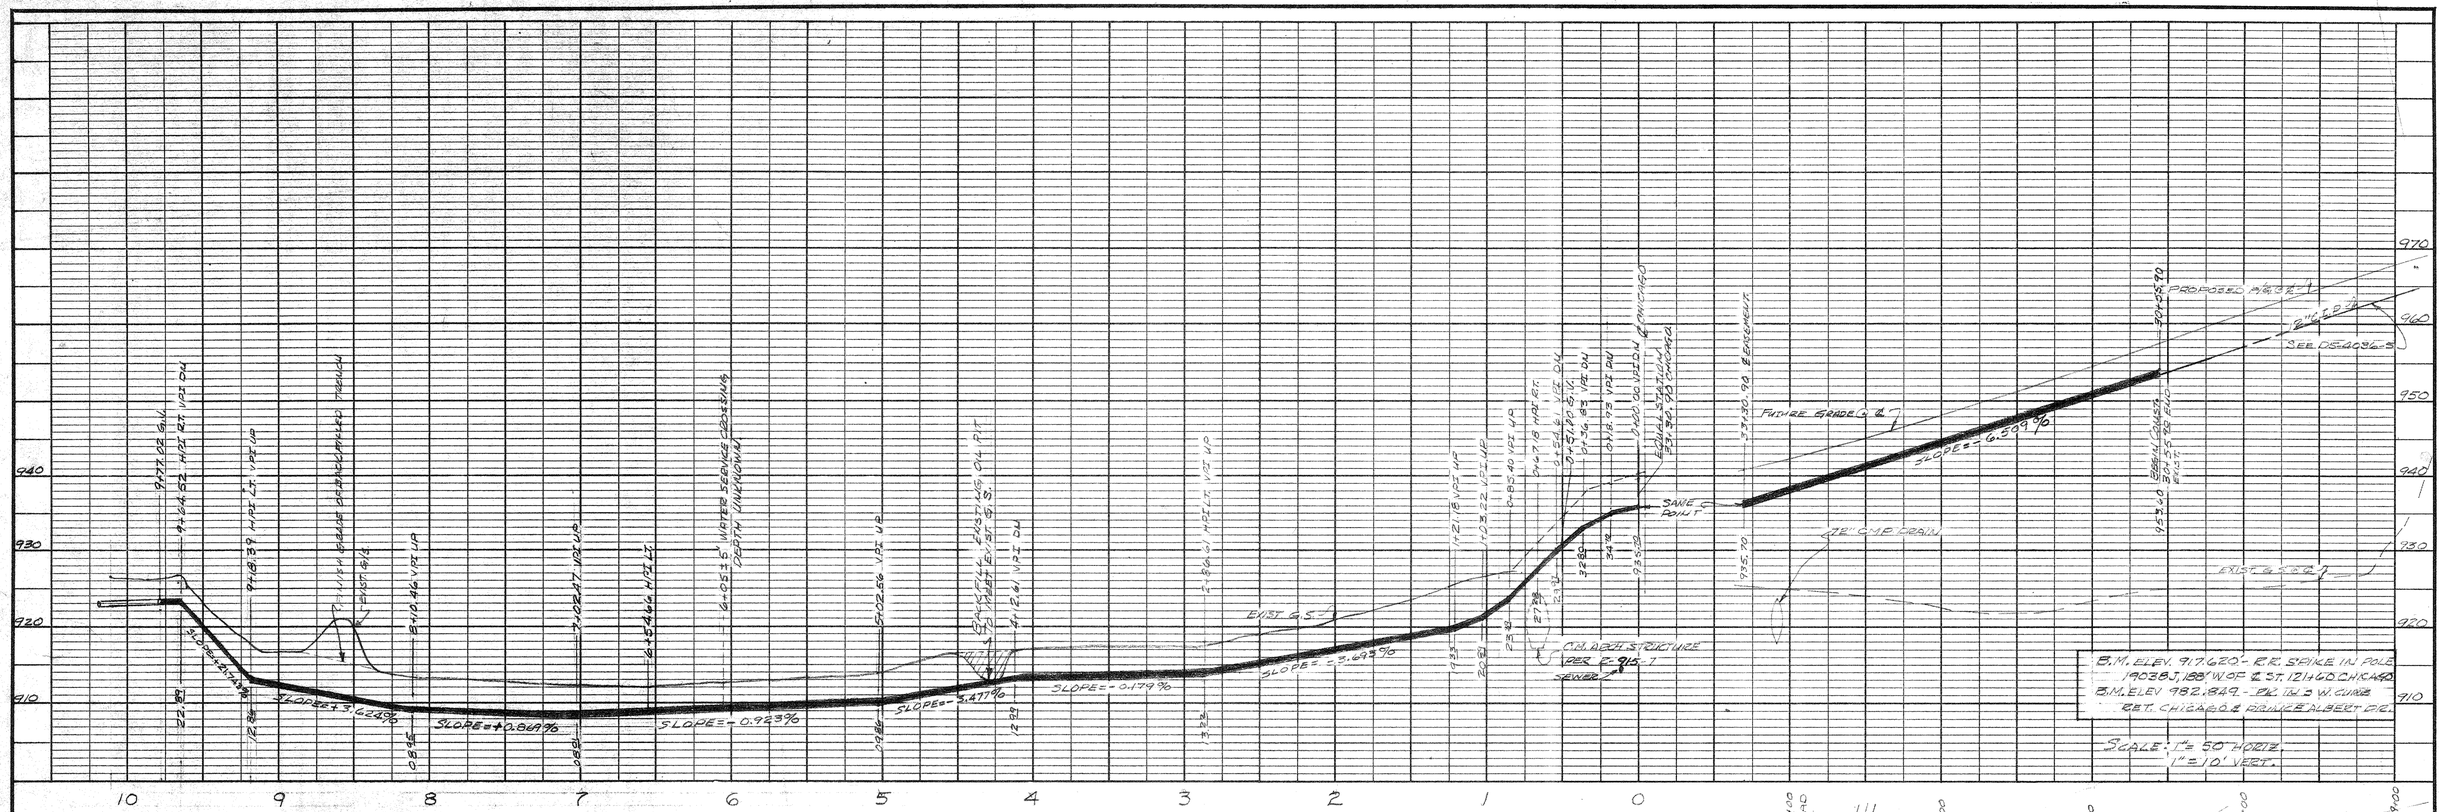

NOTE: ELEV. GIVEN ON PIPE LINE PROFILE ARE TO BOTTOM OF TRENCH.

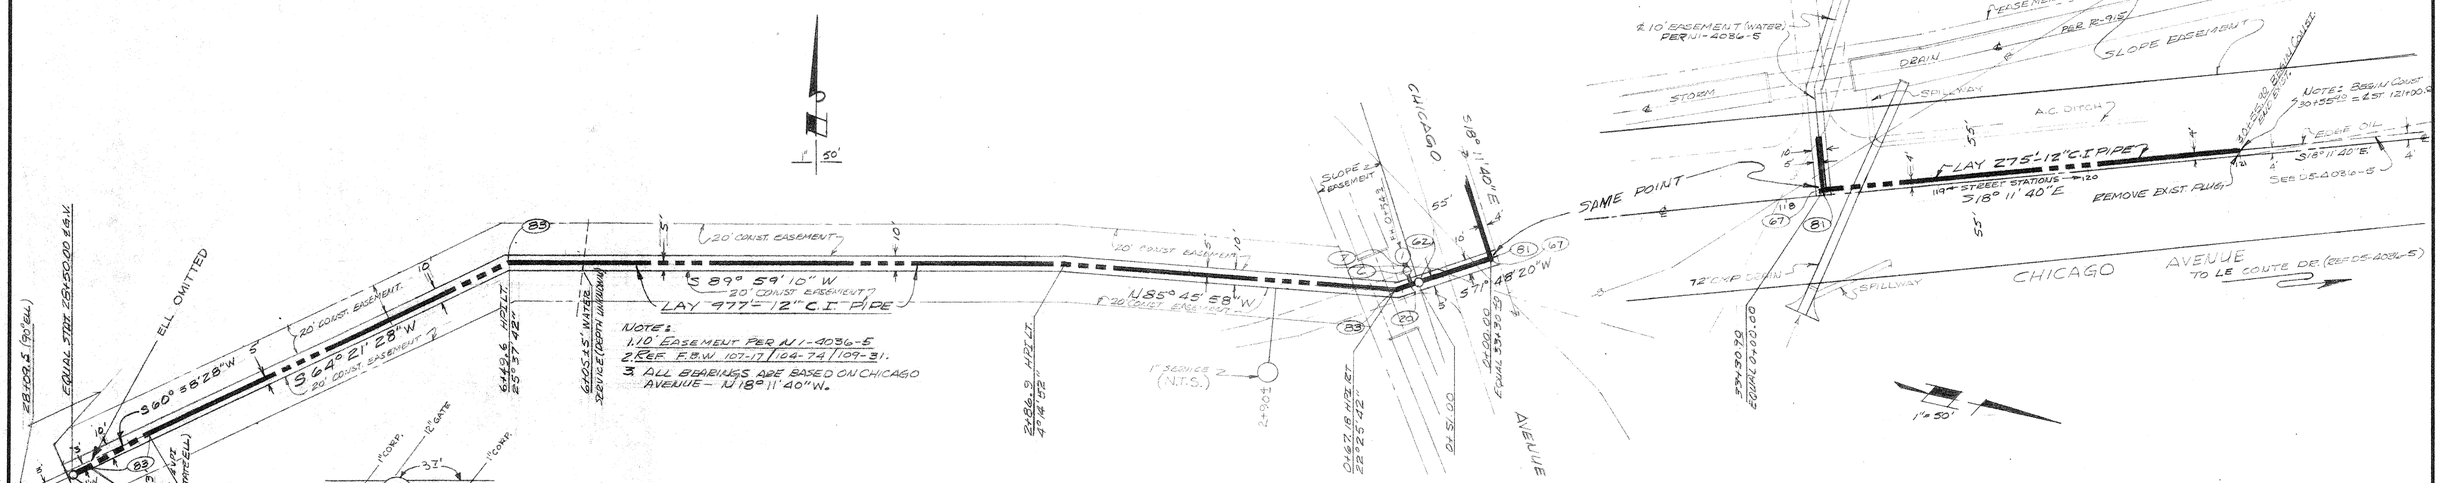

BILL OF MATERIALS

ITEM	DESCRIPTION	QTY MAIN	F.H.	TOTAL	STOCK NO
	12" CAST IRON PIPE	1252'		1252'	4-5031
62	12" G.V.	1 ea.		1	4-4214
81	12"x12" TEE	1 ea.		1	4-6355
83	12"x 22½° ELL	4 ea.		4	4- 2673
67	12" PLUG	1 ea.		1	4- 5725
20	12"x6" TEE	0	1 ea.	1	4- 6355
	GATE BOX	1 ea.	1 ea.	2	STOCK
	6" C.I. PIPE	—	10'	10'	4-6028

ITEM	DESCRIPTION	MAIN	F.H.	TOTAL	STOCK Nº
1	FIRE HYDT	—	1 ea.	1 ea.	4-3002
7	6" GATE	—	1 ea.	1 ea.	4-2028
6	6" G.V.	—	1 ea.	1 ea.	4-4211

INSTALL 1-1" COPPER SERVICE.

APPRD	AS BUILT REVISIONS	DATE
K.S.		June 2, 1967

General Notes:
1. ALL STATIONS HEREON ARE HORIZ. DISTANCE ONLY.
2. ALL STREET DATA SHOWN HEREON PER R-915.

12,00 ft. ZONE TIE LINE
CHICAGO AVENUE
TO
ELSINORE ROAD

CITY OF RIVERSIDE
DEPT. OF PUBLIC UTILITIES

SCALE 1"=50'/1"=10'	F. B. NO. 109/31-34	WATER DEPT.
DATE 11/1/65	CHKD. BY K.S.	DWG. NO.
DWG. BY EH	APPRVD. BY K.S. Burns	DS-4036-6
TRCD. BY	C. O. NO. SHEET 1 OF 1	

DIETERICH-POST CLEARPRINT 1000H