Printed in U.S.A.
On IMPERIAL Tracing Cloth

PLATE 1 PLAN-PROFILE B P R STANDARD
EUGENE DIETZGEN CO. CHICAGO - NEW YORK

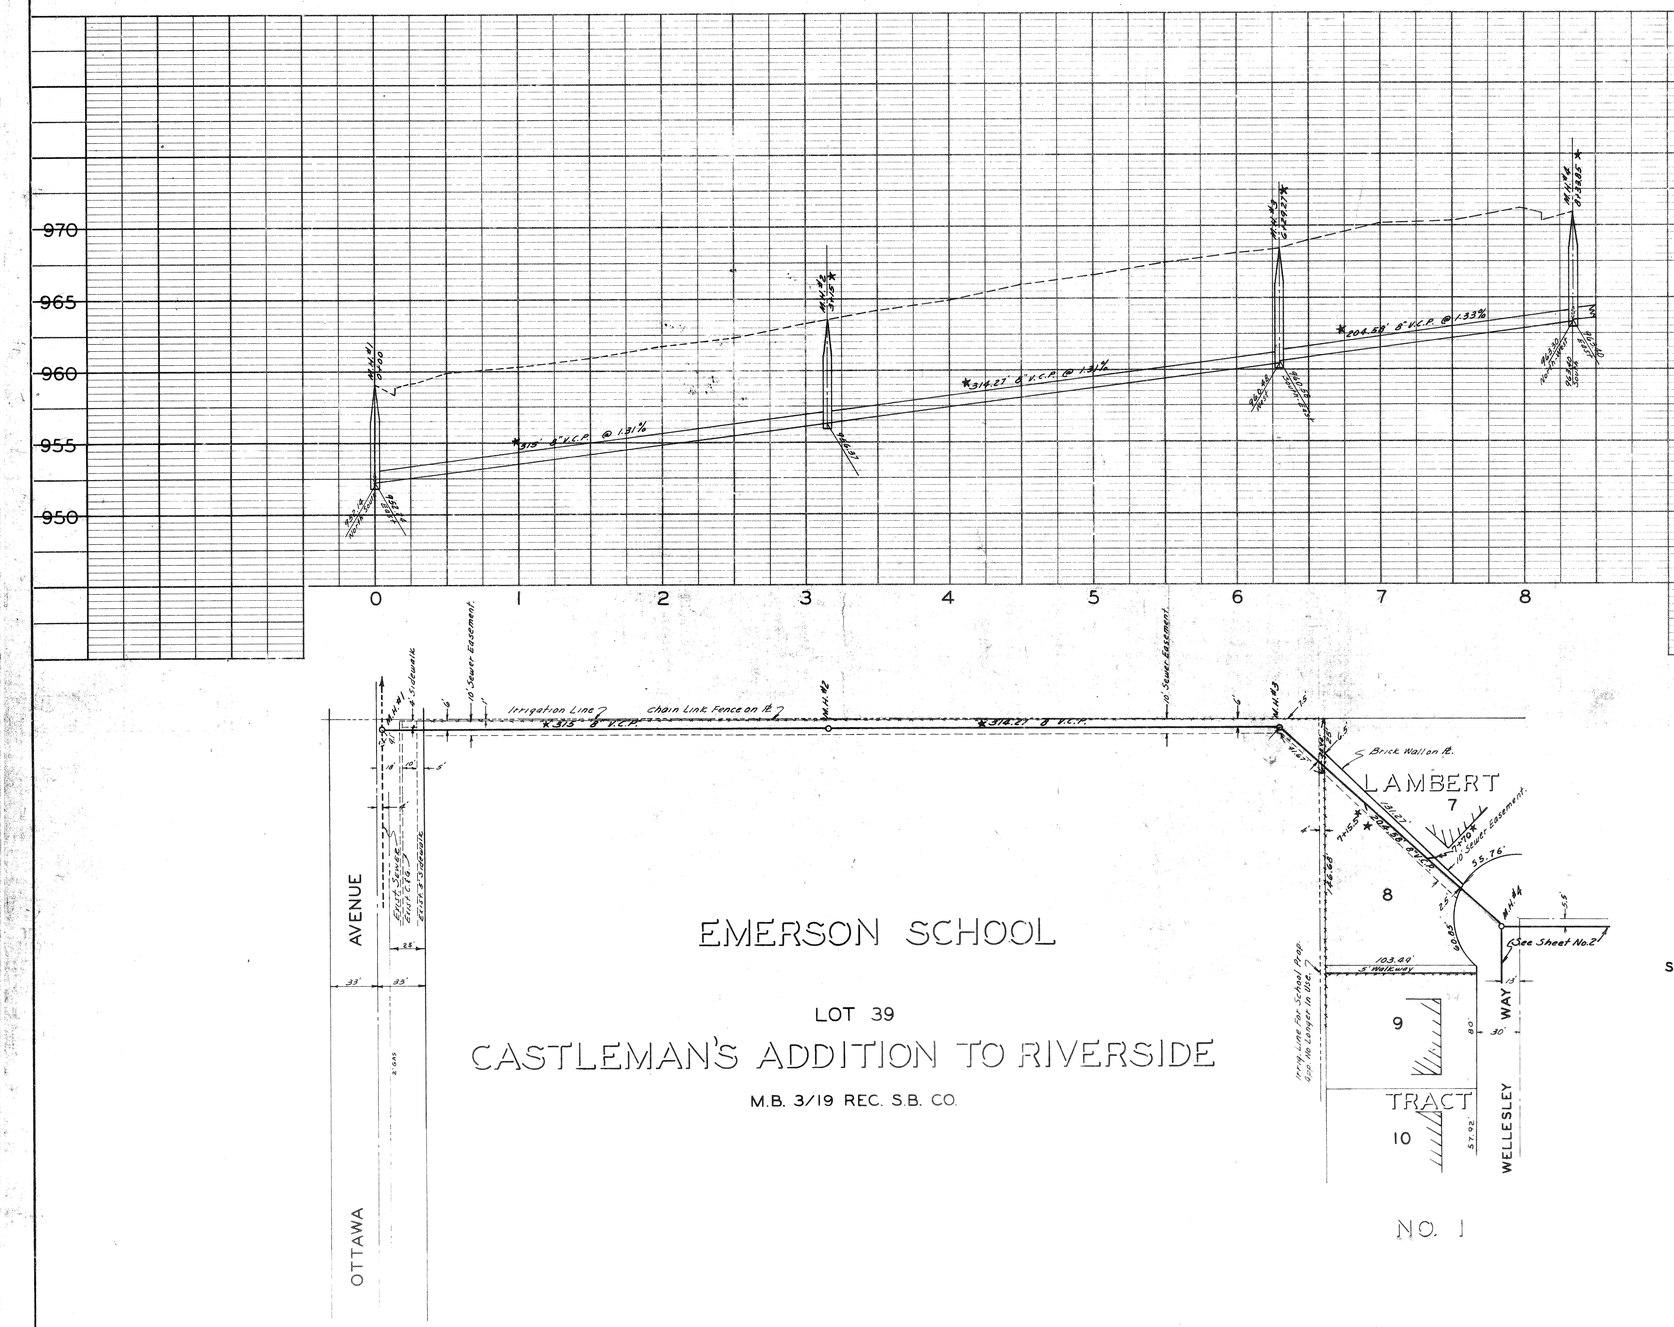


B.M. ELEV. 977.47 P.K. NAIL IN N. CURB VASSAR DR. 38'± W. OF C.L. CHICAGO.

B.M. ELEV. 958.86 P.K. NAIL IN E. CURB OTTAWA 2' S. OF N.P.L. EMERSON SCHOOL PROPERTY.

F.B. 641/1

SCALES: HOR. 1"=50'
VERT. 1"=5'

SCALE: 1"= 50'

NOTE:
LOCATE WYES IN FIELD.

| PROFILE | | | |
|---|---|---|---|
| NO. | NOTE BOOK | SURVEYED | |
| | | PLOTTED | |
| | | GRADES CHECKED | |
| | | B.M. NOTED | |
| | | STRUCTURE NOTATIONS CHKD | |
| | | | BY |
| | | | DATE |

| PLAN | | | |
|---|---|---|---|
| NO. | NOTE BOOK | SURVEYED | |
| | | PLOTTED | |
| | | ALIGNMENT CHECKED | |
| | | RT. OF WAY CHECKED | |
| | | | BY |
| | | | DATE |

| REVISIONS | | |
|---|---|---|
| MARK | DATE | DESCRIPTION |
| ★ | 5-18-59 | "As Built", H. Ball |

CITY OF RIVERSIDE CALIFORNIA
DEPARTMENT OF PUBLIC WORKS

LAMBERT TRACT NO. 1
SANITARY SEWER DISTRICT

INCLUDES
WELLESLEY WAY, VASSAR DRIVE
HOLYOKE PLACE & CHICAGO AVE.

DESIGNED BY
DRAWN BY
CHECKED BY
RECOMMENDED BY ASSISTANT CITY ENGINEER
APPROVED BY DIRECTOR OF PUBLIC WORKS
DATE Dec 5, 1958

**S-118**
SHEET 1 OF 2