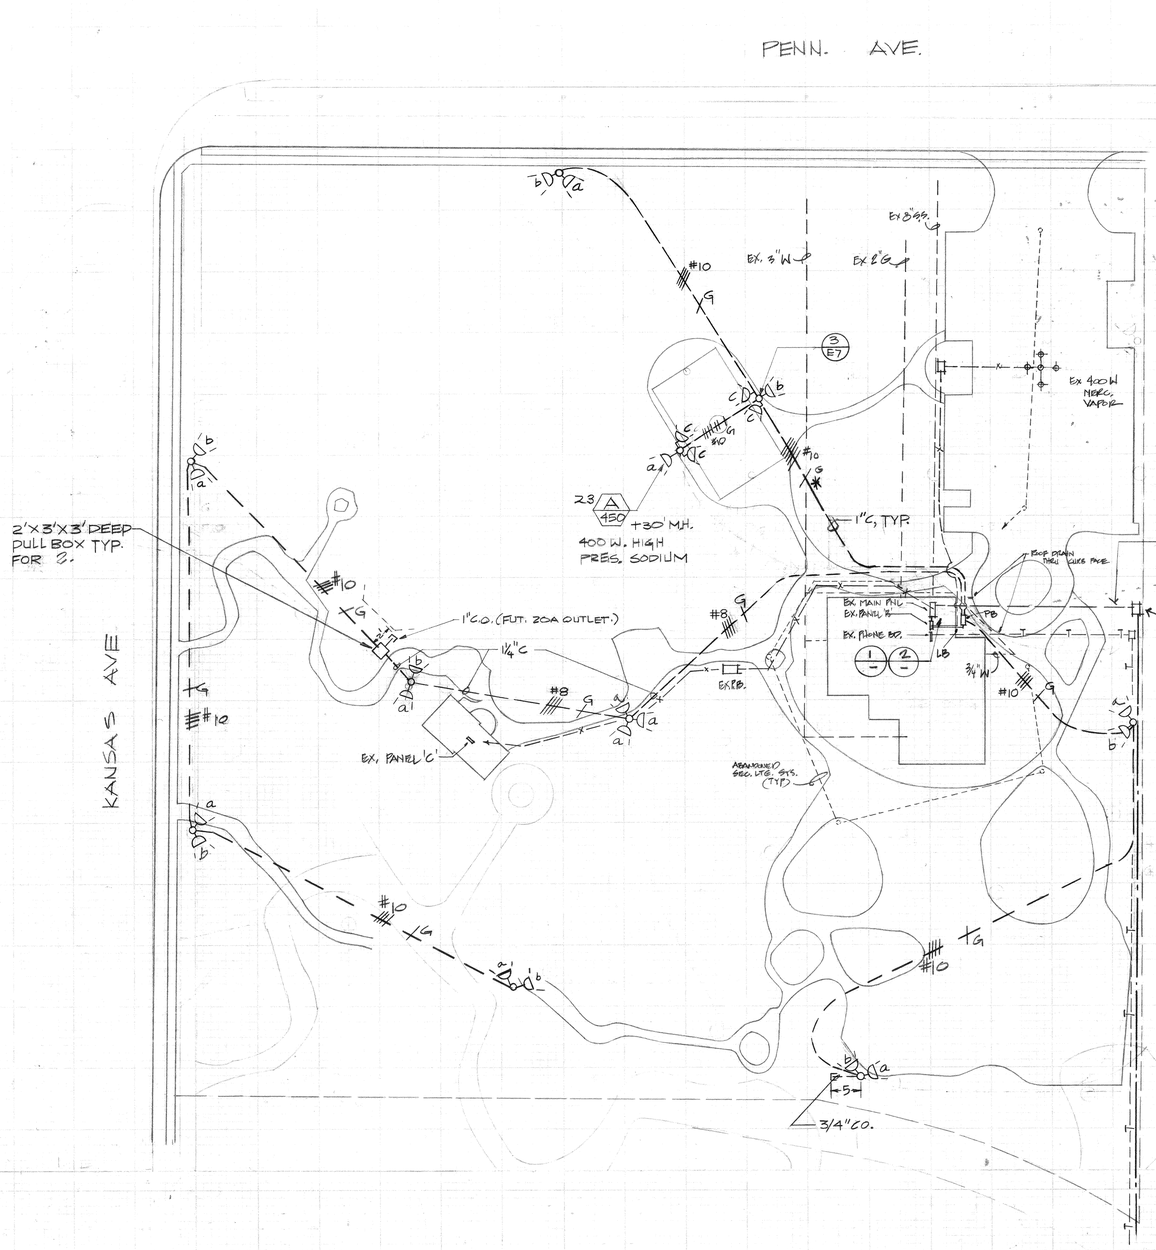

A ELECTRICAL SITE PLAN
SCALE: 1"=40'-0"

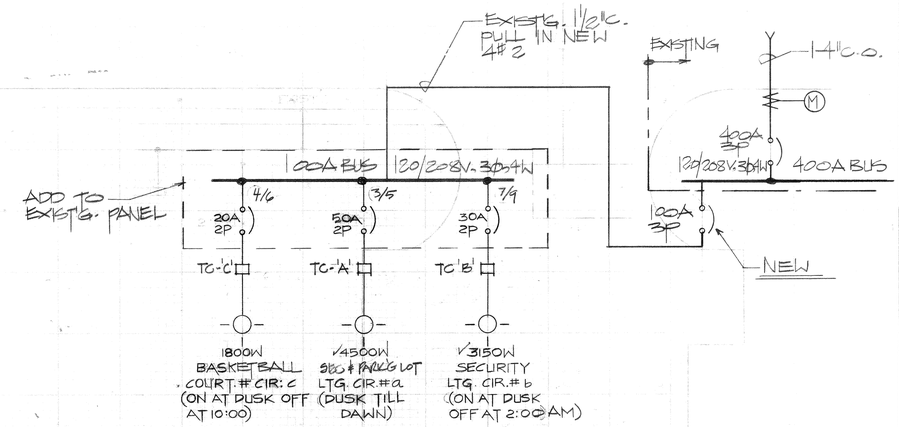

1 E6 SINGLE LINE DIAGRAM
NO SCALE

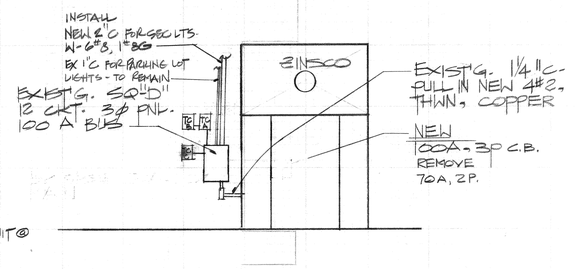

CAUTION:
EXIST'G. HIGH VOLTAGE CONDUIT @ 36" BELOW FIN GR. PROTECT

2 E6 ELECT. EQUIP. ELEVATION
NOT TO SCALE

NOTES:

1. FINAL LIGHT STANDARD LOCATIONS TO BE VERIFIED AND APPROVED IN THE FIELD BY THE PARKS DEPT. REPRESENTATIVE PRIOR TO INSTALLATION/DIGGING FOR FOOTINGS.
2. CONDUIT ROUTING IN PROXIMITY TO EXISTING TREES SHALL BE AS APPROVED BY THE CITY.

"AS-BUILT" (AS OF 9-29-88 BD.)

MULLEN & ASSOCIATES INC.
CONSULTING ENGINEERS
1940 N. TUSTIN AVE., SUITE 113
ORANGE, CALIFORNIA 92665/714-637-6621

REGISTERED PROFESSIONAL ENGINEER 3-25-81 LARRY D. MULLEN E 8279 ELECTRICAL STATE OF CALIFORNIA

RIVERSIDE PARK LIGHTING
CITY OF RIVERSIDE

BORDWELL PARK
ELECTRICAL PLAN JOB# 8072

REVISIONS

DATE: 1982

SHEET E1 OF 2

PLAN #P1010

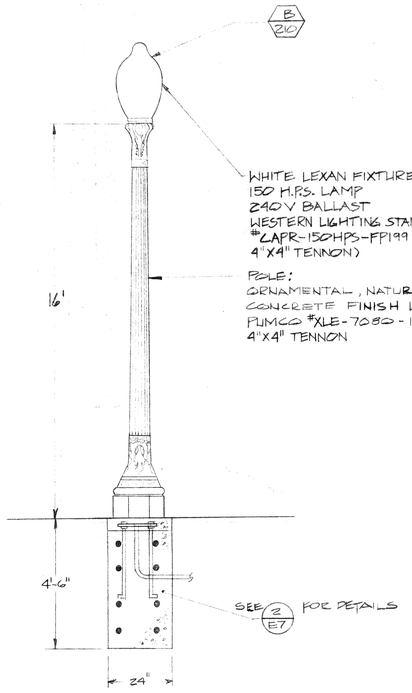

1/E7 SECURITY LIGHT DETAIL
N.T.S.

NOTES:

1. FINAL LIGHT STANDARD LOCATIONS TO BE VERIFIED AND APPROVED IN THE FIELD BY THE PARKS DEPT. REPRESENTATIVE PRIOR TO INSTALLATION/DIGGING FOR FOOTINGS.
2. CONDUIT ROUTING IN PROXIMITY TO EXISTING TREES SHALL BE AS APPROVED BY THE CITY.

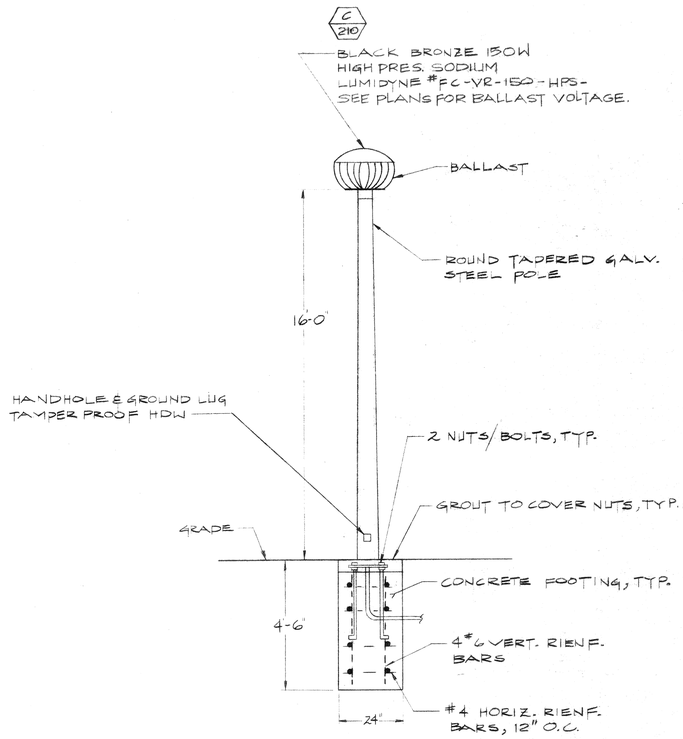

2/E7 PARKING/WALKWAY LIGHT DETAIL
N.T.S.

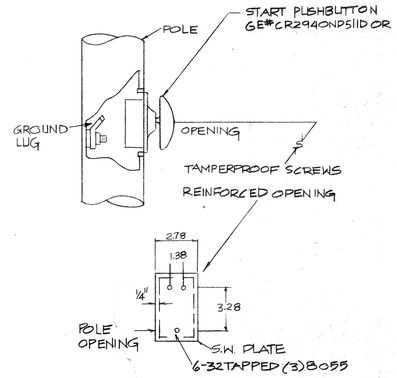

1/E5 HARD COURT PUSHBUTTON DETAIL
N.T.S.

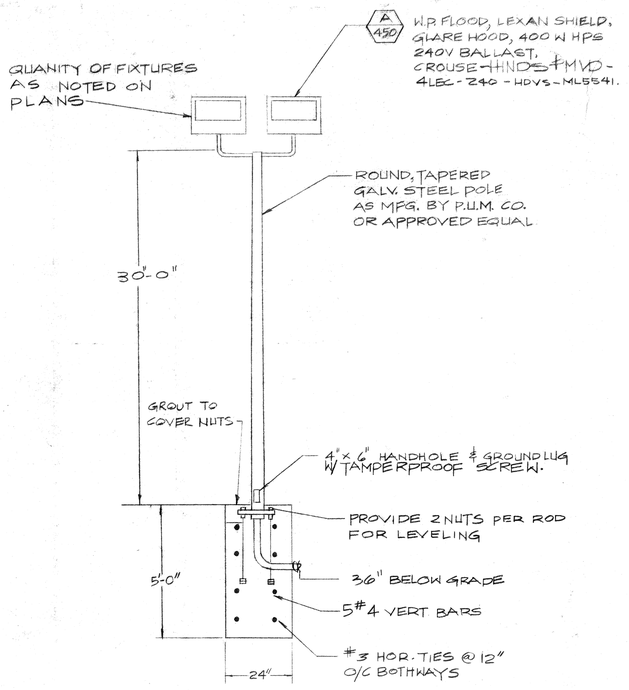

2/B4 FLOODLIGHT/HARD COURT LIGHTING DETAIL
NTS

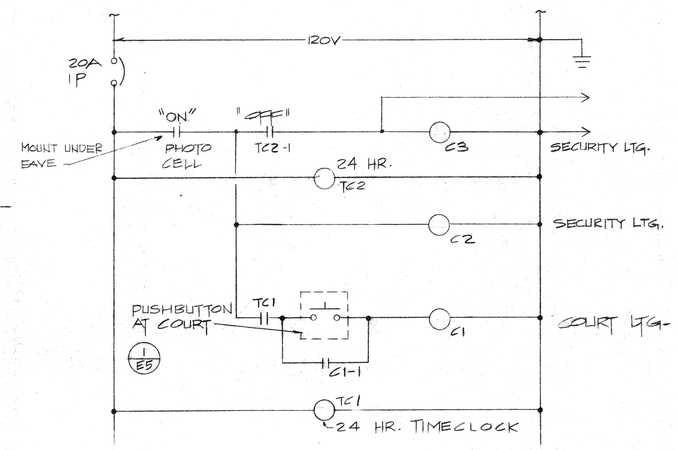

3/E4 LIGHT CONTROL DIAGRAM (BORDWELL PARK)
NO SCALE (TYP. FOR WHITE, REID, SHAMEL)

FOR REPRODUCIBLE OF THIS SHEET SEE WHITE PARK FILE.

MULLEN & ASSOCIATES INC.
CONSULTING ENGINEERS
1940 N. TUSTIN AVE., SUITE 113
ORANGE, CALIFORNIA 92665/714-637-6621

REGISTERED PROFESSIONAL ENGINEER LARRY D. MULLEN E 8279 ELECTRICAL STATE OF CALIFORNIA

RIVERSIDE PARK LIGHTING
CITY OF RIVERSIDE

ELECTRICAL PLAN JOB# 8072
BORDWELL PARK FILE

REVISIONS

DATE:

SHEET E 2 OF 8 2

PLAN # P-1010