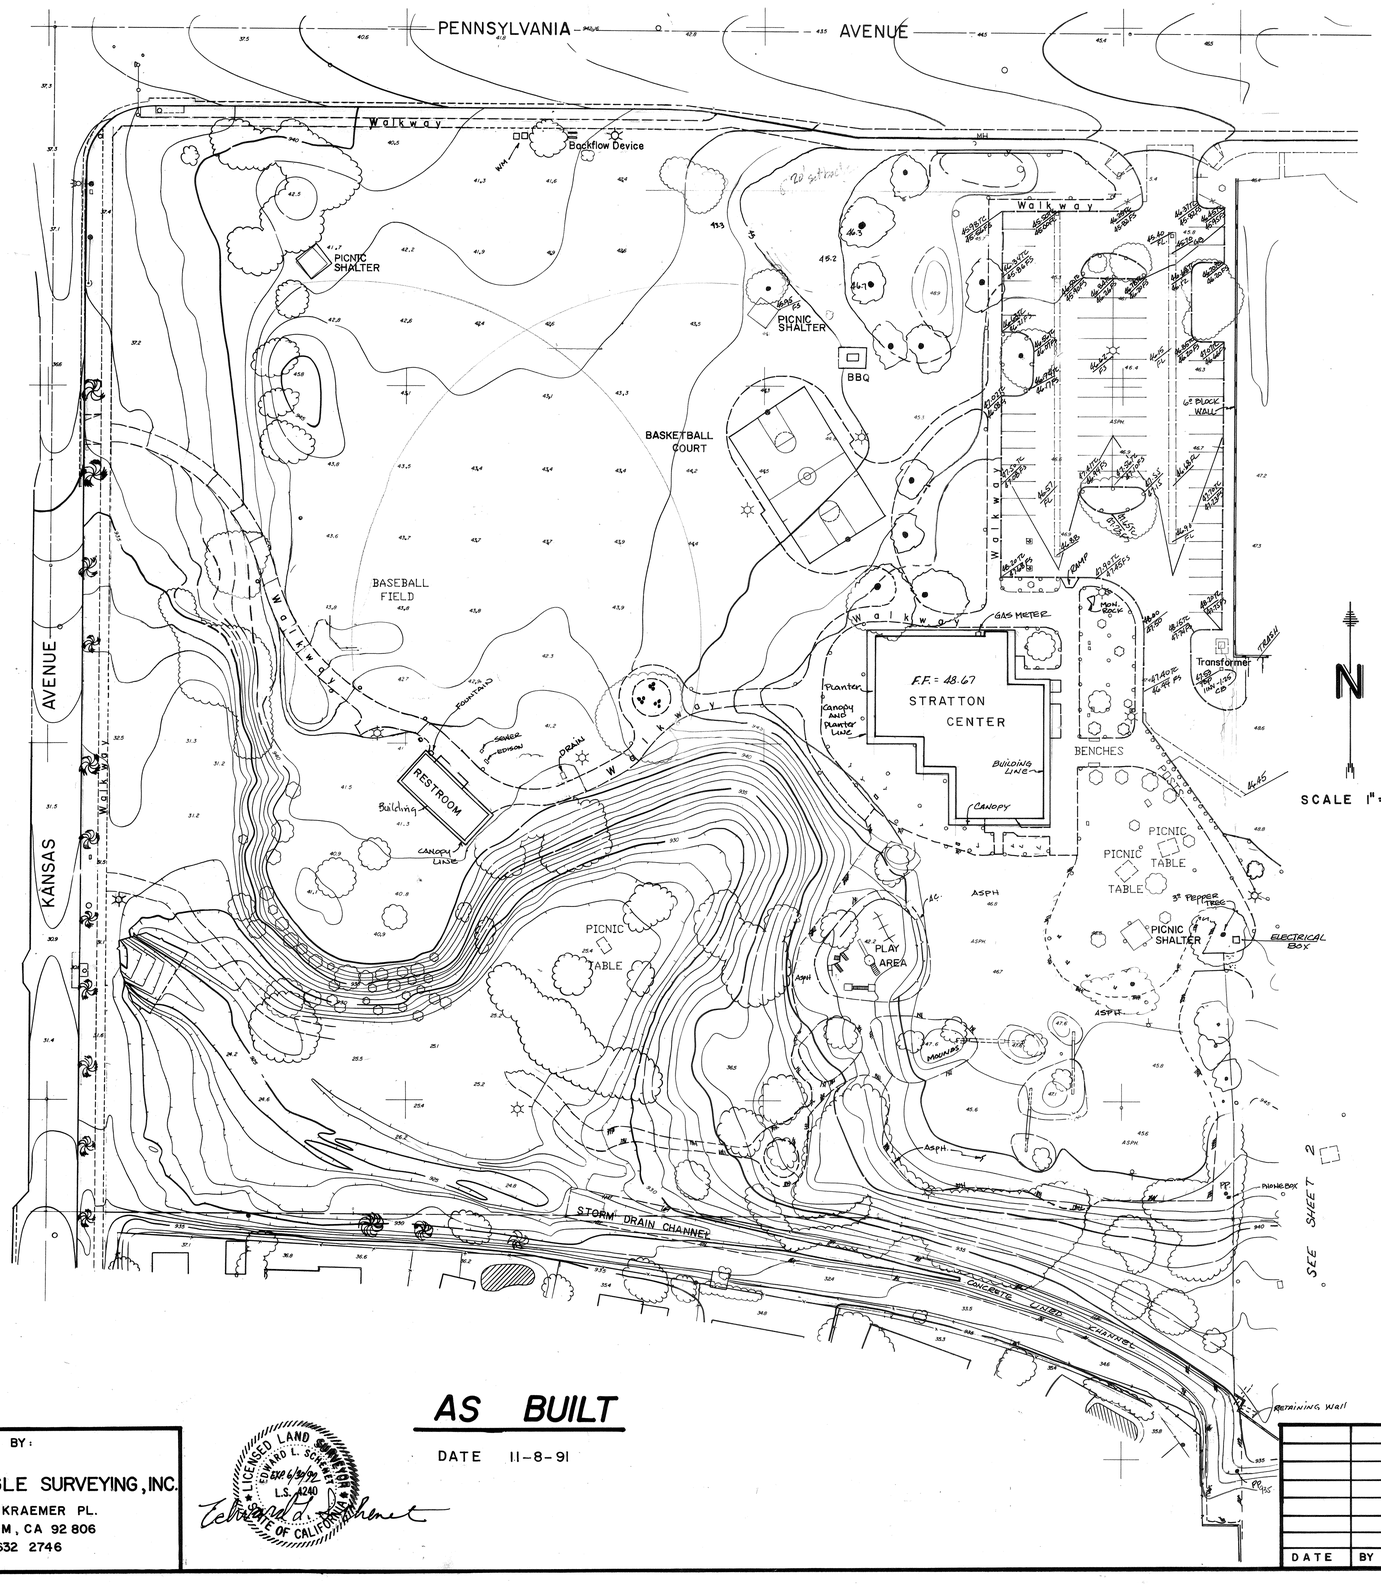

LEGEND

- R.C. GATE VALVE
- SPRINKLERS
- TREE, OTHER THAN PALM
- TREE, PALM
- ELECTROLIER ON POWER POLE, CANTILEVER ARM

AS BUILT

DATE 11-8-91

PREPARED BY:

TRIANGLE SURVEYING, INC.
1162 N. KRAEMER PL.
ANAHEIM, CA 92806
(714) 632 2746

LICENSED LAND SURVEYOR
EDWARD L. SCHENEK
EXP. 6/30/92
L.S. 4240
STATE OF CALIFORNIA

DATE	BY	REVISIONS	APP'D

CITY OF RIVERSIDE

BORDWELL PARK

DRAWING NO.

SHEET 1 OF 2 SHEETS

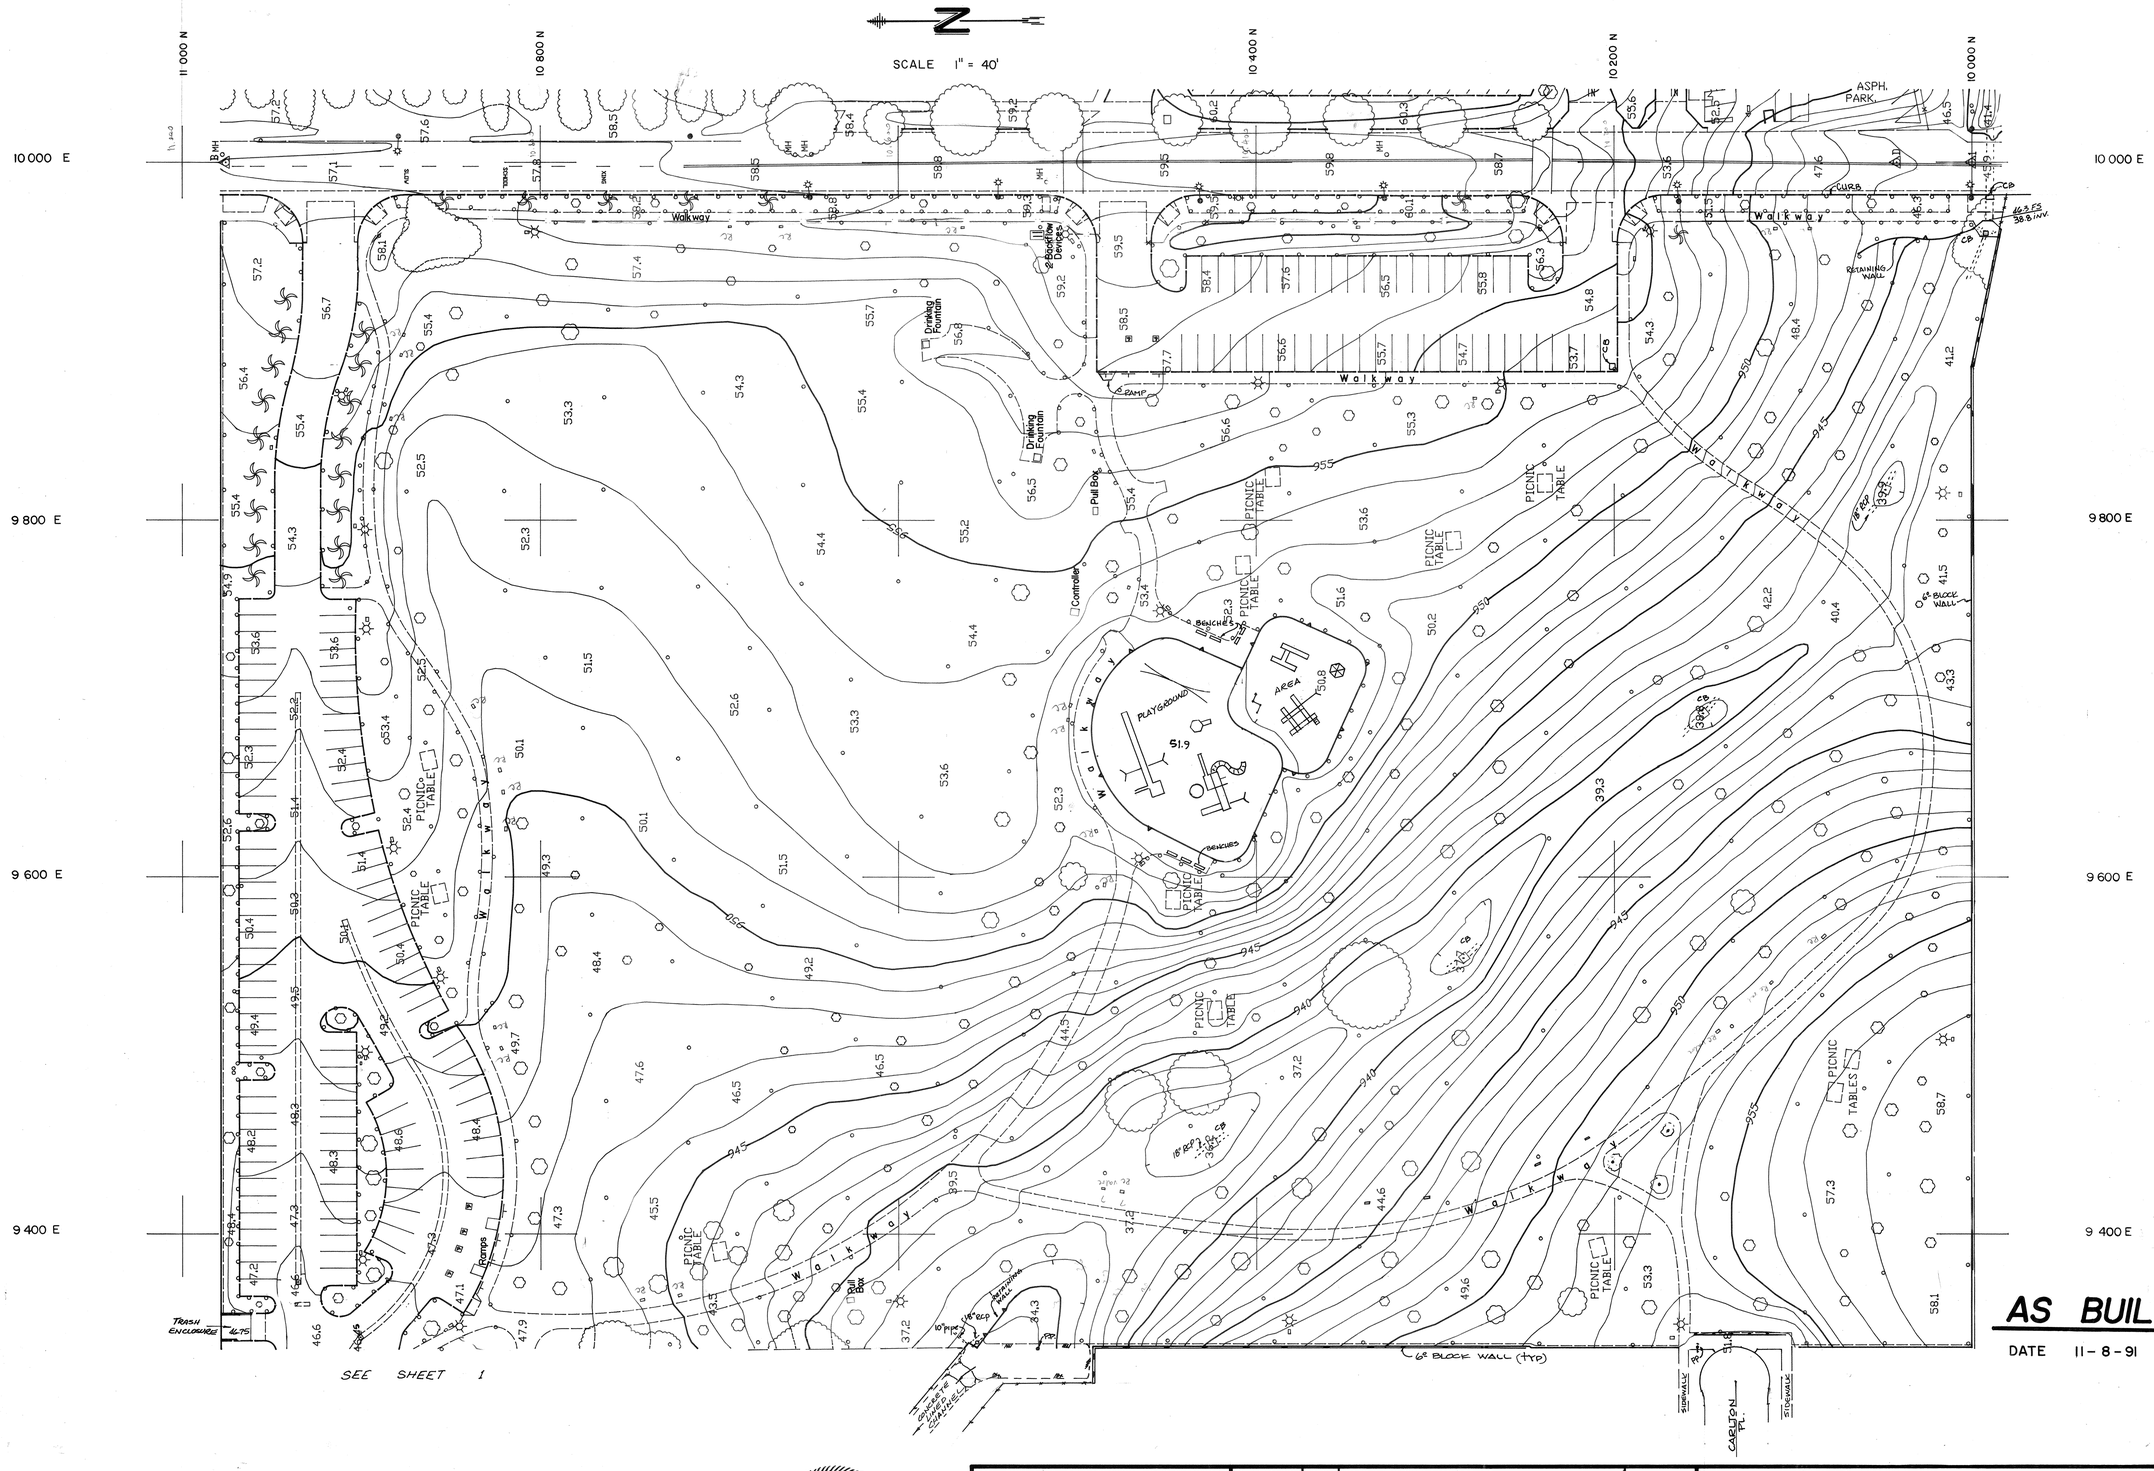

AS BUILT

DATE 11-8-91

LICENSED LAND SURVEYOR
EDWARD L. SCHENET
EXP. 6/30/92
L.S. 4240
STATE OF CALIFORNIA

Edward L. Schenet

PREPARED BY:
TRIANGLE SURVEYING, INC.
1162 N. KRAEMER PL.
ANAHEIM, CA 92806
(714) 632 2746

DATE	BY	REVISIONS	APP'D

CITY OF RIVERSIDE

BORDWELL PARK

DRAWING NO.

SHEET 2 OF 2 SHEETS