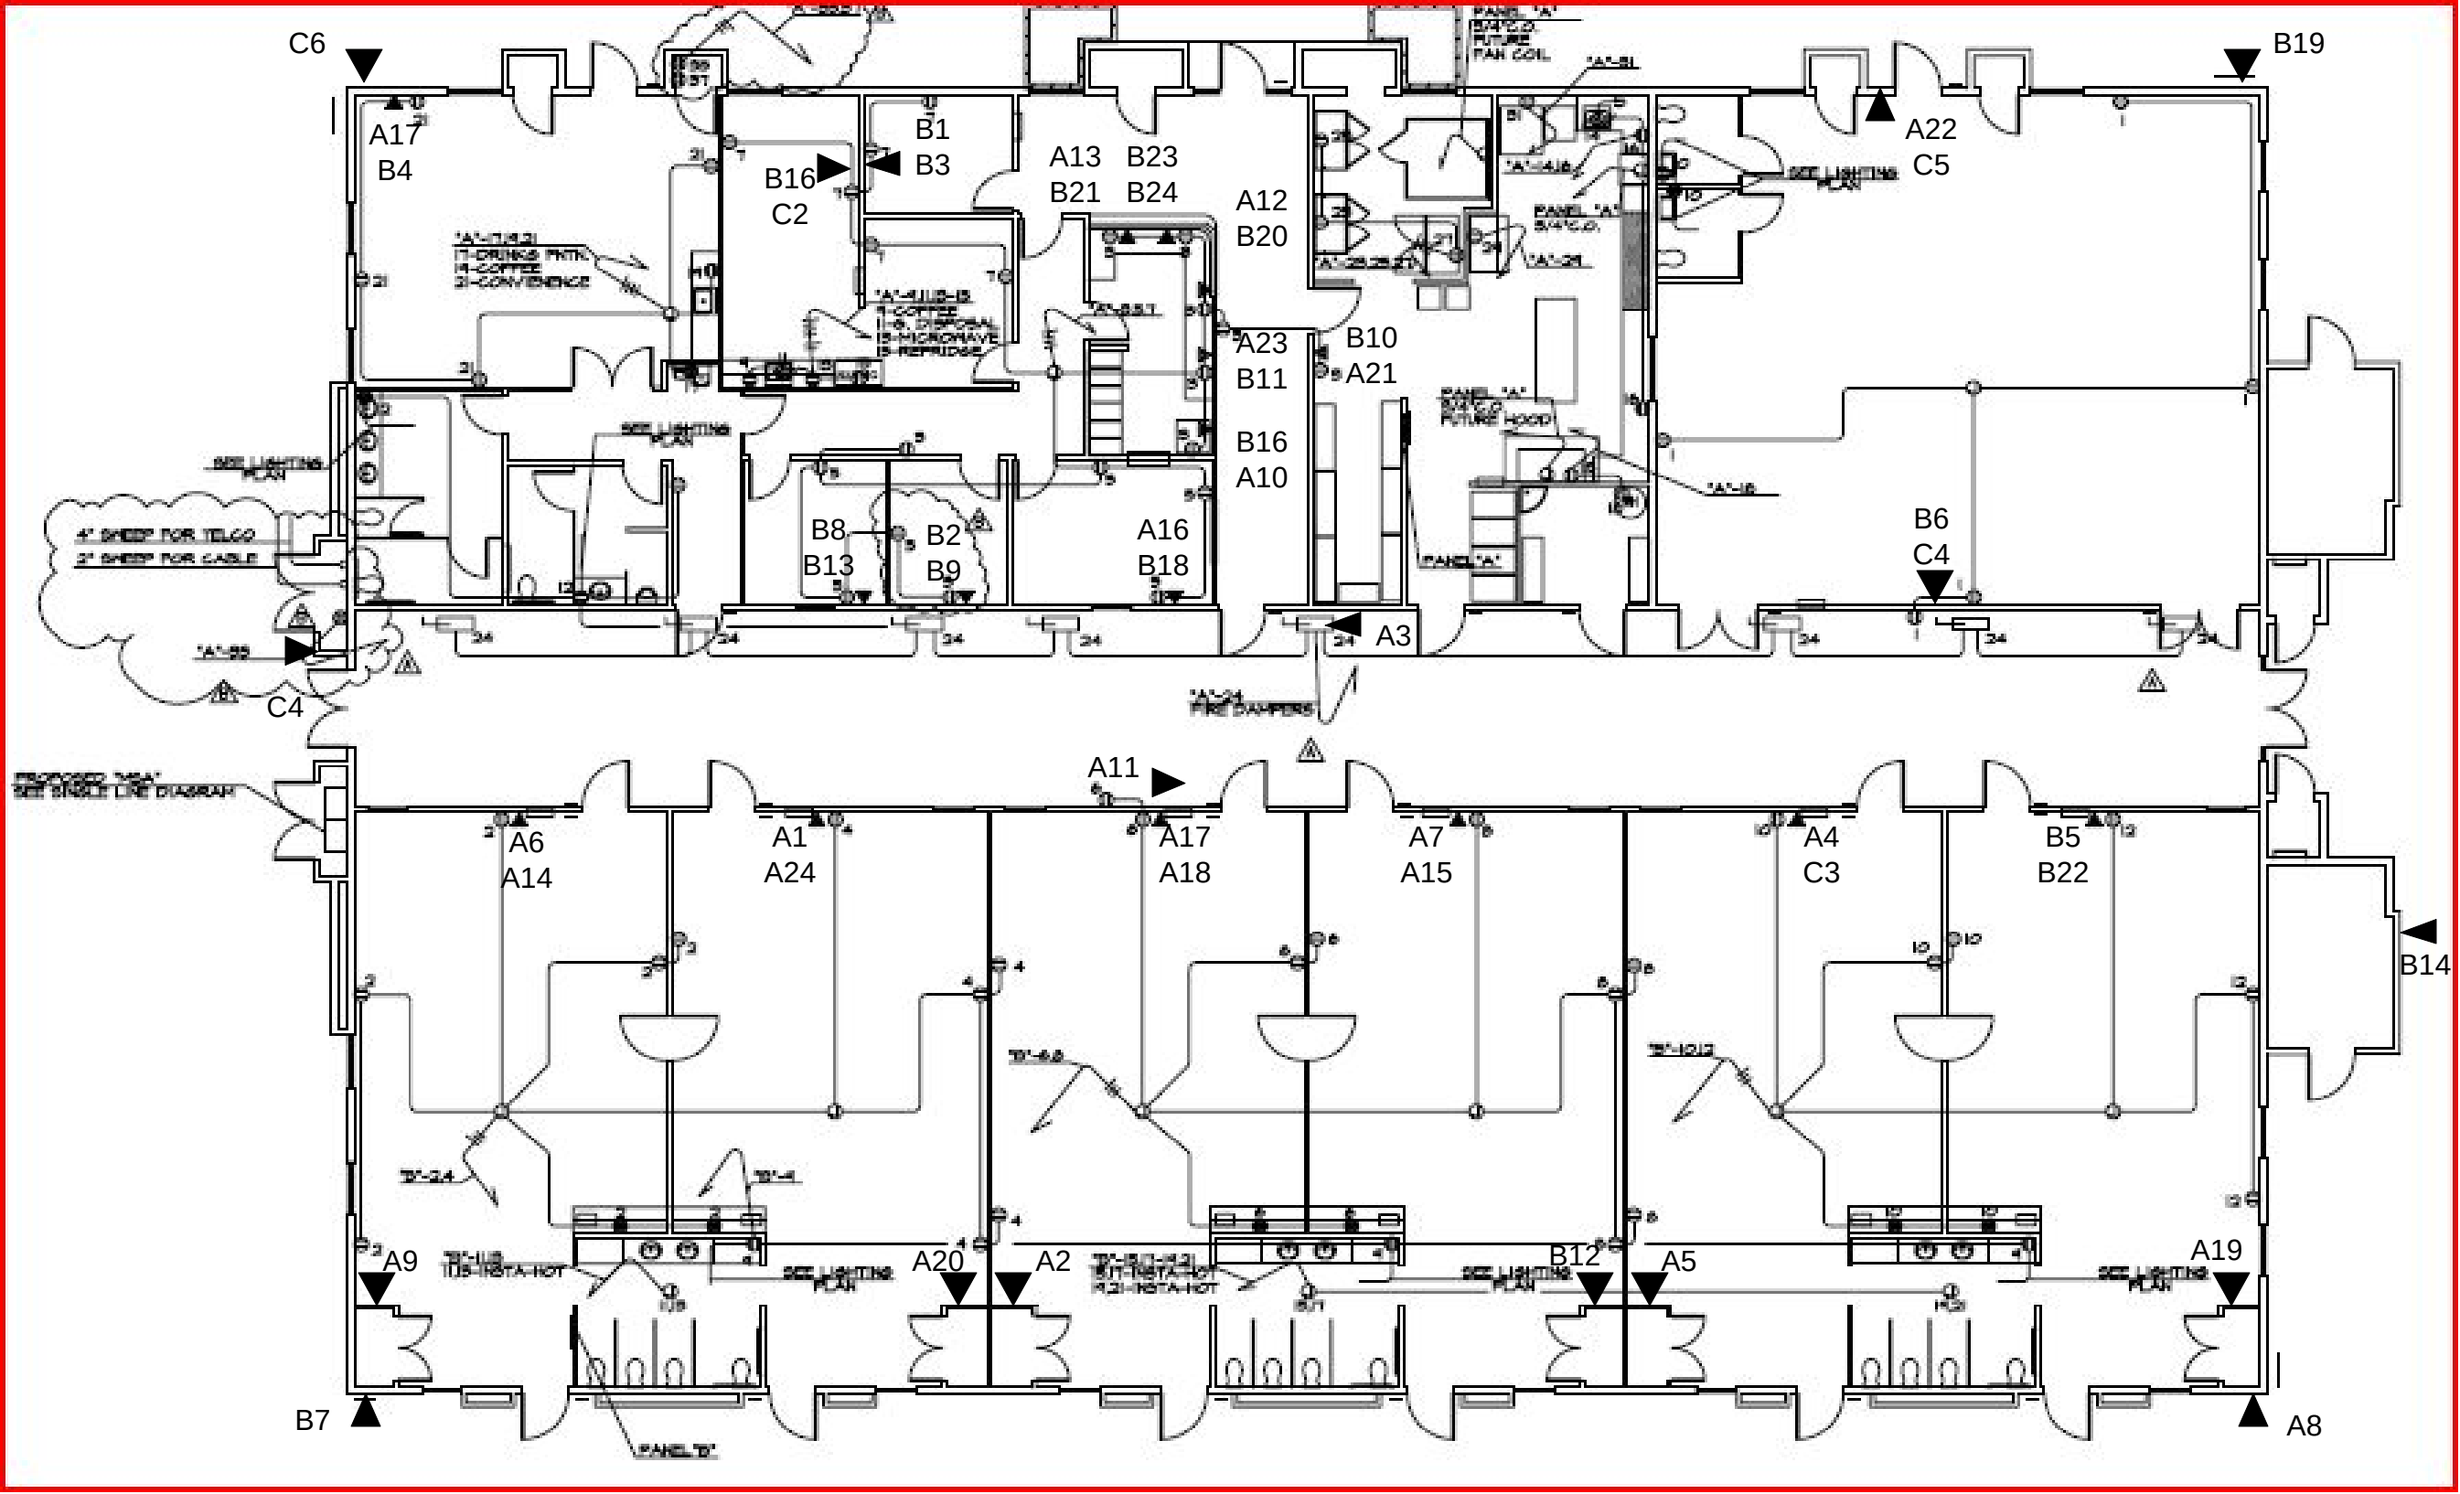
C6
B19
A17
B4
B1
B3
B16
C2
A13
B21
B23
B24
A12
B20
A22
C5
A23
B11
B10
A21
B16
A10
B8
B13
B2
B9
A16
B18
B6
C4
A3
C4
A11
A6
A14
A1
A24
A17
A18
A7
A15
A4
C3
B5
B22
B14
A9
A20
A2
B12
A5
A19
B7
A8