150023

PLANTING LEGEND

ABBREV.	BOTANICAL NAME	COMMON NAME	QTY.	SIZE
SHRUBS:				
CAL HAE	CALLIANDRA HAEMATOCEPHALA	PINK POWDER PUFF	1	5 GAL.
ESC NEW	ESCALLONIA 'NEWPORT DWARF'	DWARF ESCALLONIA	7	5 GAL.
GRE NOE	GREVILLEA 'NOELLII'	N.C.N.	4	5 GAL.
HEM HYB	HEMEROCALLIS HYBRID	YELLOW DAYLILY	19	1 GAL.

GROUNDCOVER:

- AREA TO RECEIVE NEW HYDROSEEDED TURF PER SPECIFICATIONS.
- FRAGARIA CHILOENSIS (FROM FLATS @ 12" O.C.) — WILD STRAWBERRY

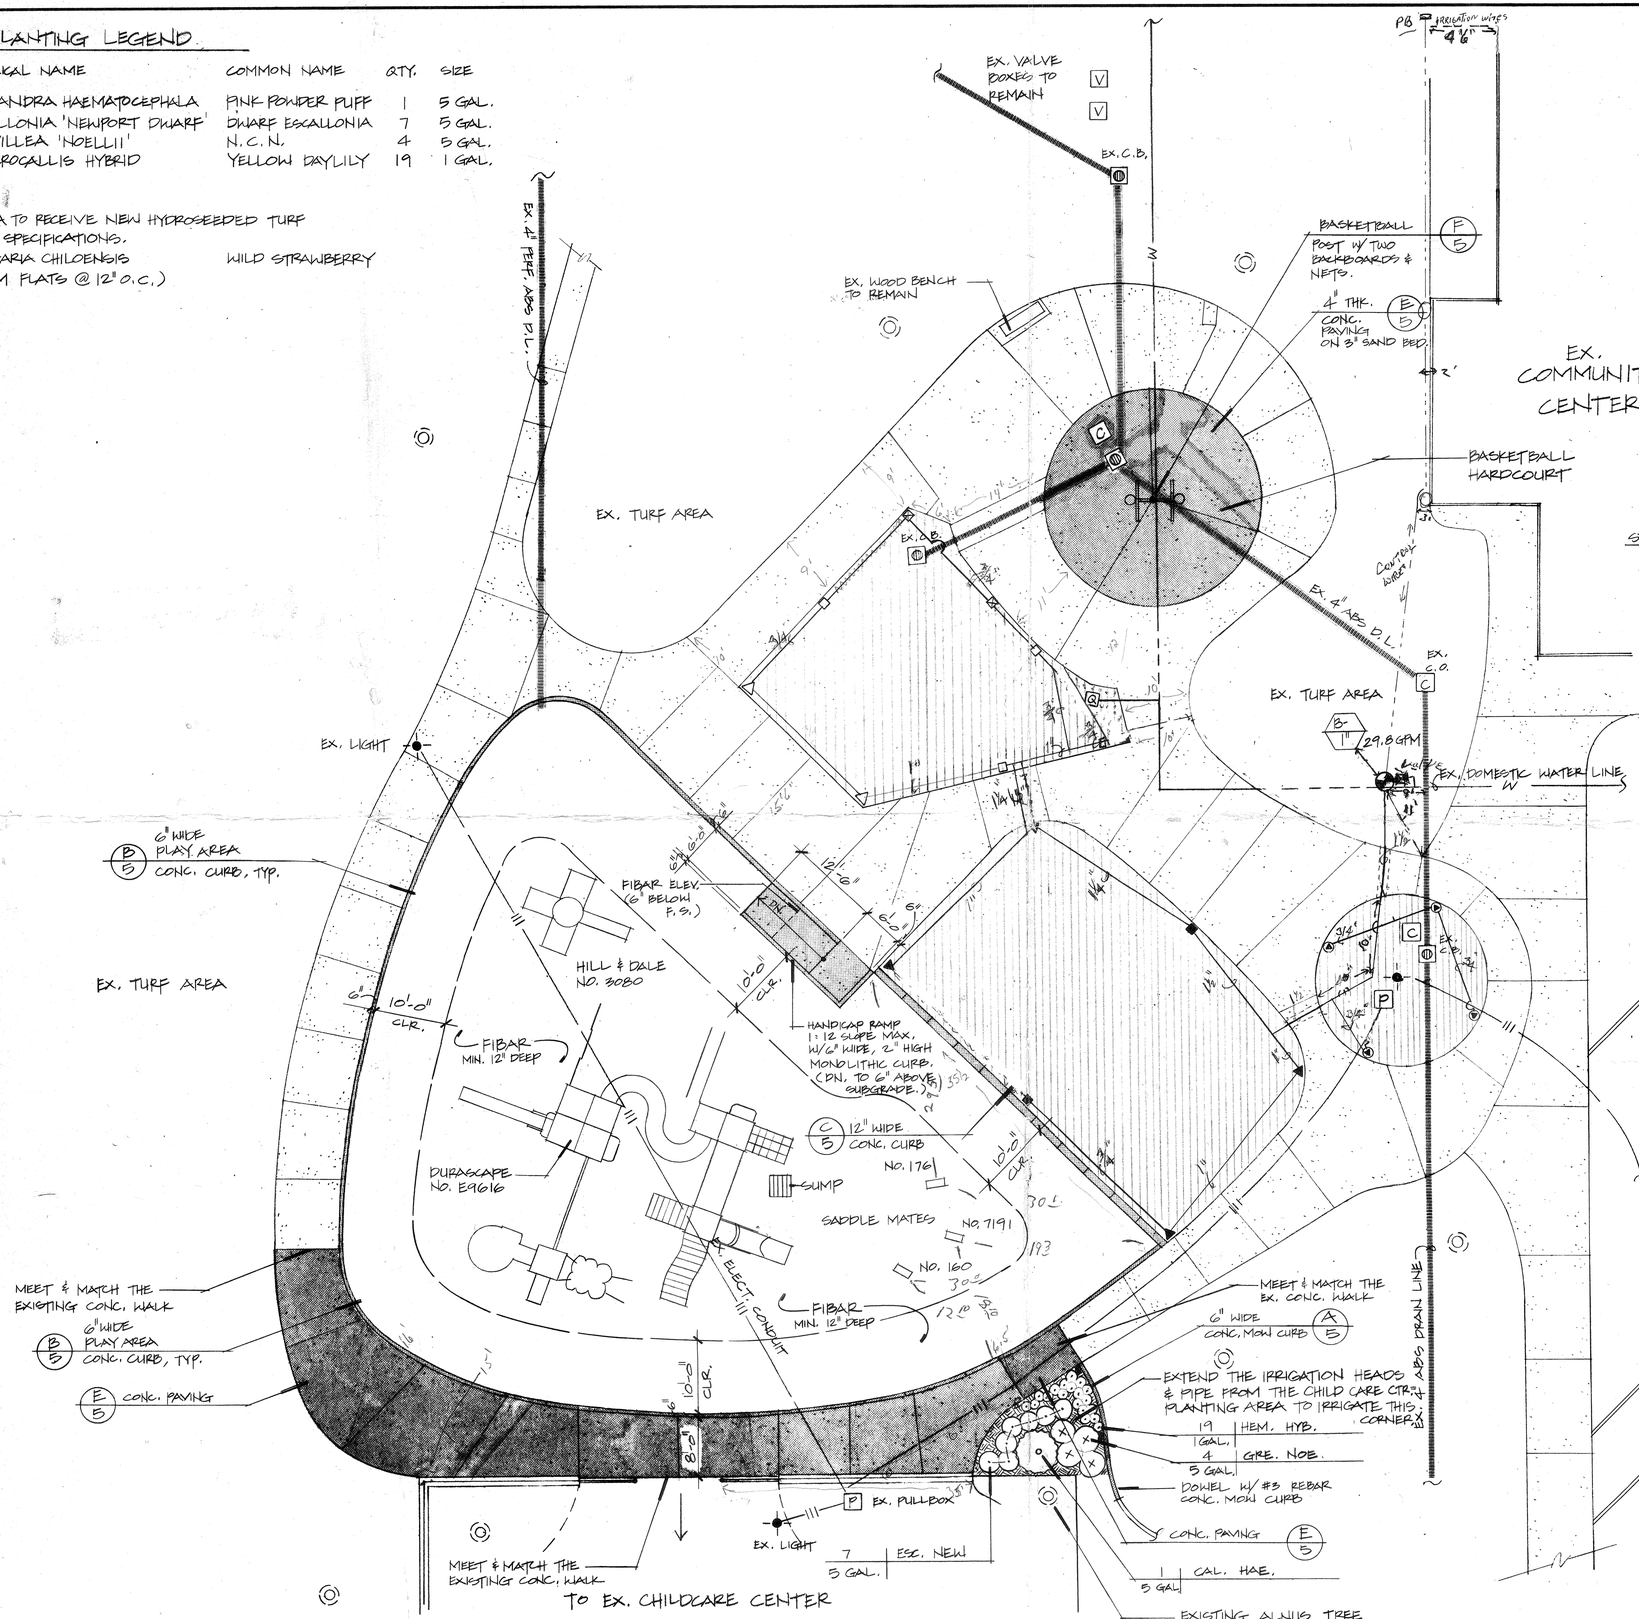

CONSTRUCTION LEGEND

- EXISTING CONCRETE TO REMAIN.
- NEW CONCRETE
- EXISTING CATCH BASIN TO REMAIN, ADJUST TO GRADE.
- EXISTING CLEAN-OUT TO REMAIN, ADJUST TO GRADE.
- EXISTING LIGHT TO REMAIN.
- EXISTING TREE TO REMAIN.
- EXISTING DRAIN LINE TO REMAIN.
- EXISTING ELECT. CONDUIT TO REMAIN.
- EXISTING PULLBOX TO REMAIN.
- EXISTING QUICK COUPLER TO REMAIN.

IRRIGATION LEGEND

SYMBOL	MANUFACTURER/ MODEL	DESCRIPTION	NOZZLE	PSI	RADIUS	GPM
	TORO					
▲	XP-300P-Q	TURF POP-UP	07	35	36'	1.43
■	XP-300P-H		07	35	36'	2.85
△	304-00-05(Q)		ADJ.	35	24'	1.29
□	308-00-05(H)		ADJ.	35	18'	2.00
⊠	304-00-05(Q)		ADJ.	35	18'	1.00
◐	306-00-05(135°)		ADJ.	35	15'	1.70
✚	216-26-04	1" ELECTRIC VALVE	(BRASS)			

CLASS 200 PVC LATERAL LINE SIZE TO BE MIN. 3/4" OR OTHERWISE NOTED ON PLAN.

NOTE: CONTRACTOR SHALL TRENCH AND BRING THE ELECTRIC WIRES BACK TO THE EXISTING CONTROLLER LOCATED NEXT TO THE PARKING LOT IN THE EAST SIDE OF THE PARK, APPROXIMATELY 800 FEET.

AS BUILT 7-14-93

SCALE: 1" = 10'-0"

P- 0015

CONSTRUCTION SET

BRYANT PARK – TOT LOT REHABILITATION

CONSTRUCTION PLAN

city of riverside
park & recreation department
(714) 782-5223
3900 MAIN ST RIVERSIDE, CALIFORNIA 92522

revisions	by

date	OCT., 1992
design	EL
drawn	EL
check	
acc't. no.	
SHEET	4 of 5