NOTE: CONTRACTOR SHALL PROTECT EXIST. SPRINKLER HEADS ON CARLSON PARK. DISTURBED LANDSCAPING SHALL BE RESTORED IN KIND.

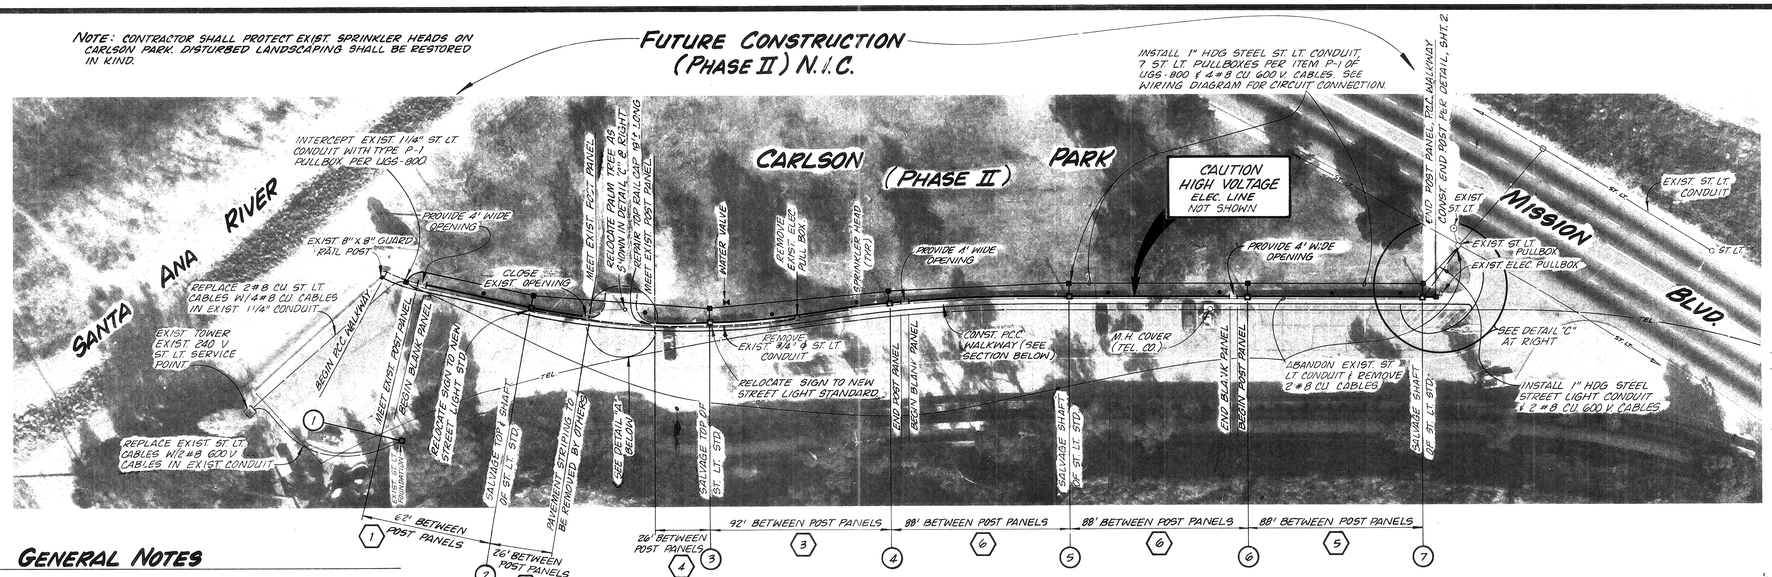

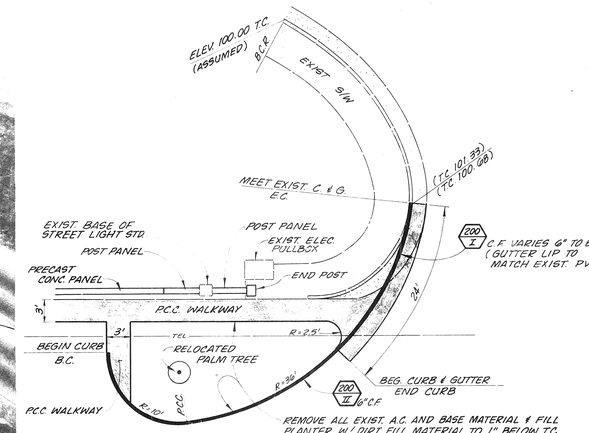

DETAIL "C"

SCALE: 1" = 10'

GENERAL NOTES

1. CONSTRUCTION SHALL BE IN ACCORDANCE WITH THE CITY OF RIVERSIDE STANDARD DRAWINGS AND STANDARD SPECIFICATIONS FOR PUBLIC WORKS CONSTRUCTION 1985 EDITION.

CONSTRUCTION NOTES

(2) — REMOVE & REPLACE EXIST. ST. LT. STANDARDS. NUMBER INDICATES THE LOCATION OF STREET LIGHT. LIGHT STANDARD @ LOCATION (1) IS NOT EXISTING. EXACT LOCATION OF REPLACEMENT WILL BE DETERMINED IN THE FIELD DURING CONSTRUCTION.

(1) — 2 SECTIONS OF 4 RAINCROSS PANELS.
2 SECTIONS OF 5 RAINCROSS PANELS.
1 SECTION OF 6 RAINCROSS PANELS.
5 BLANK PANELS

(2) — 2 SECTIONS OF 6 RAINCROSS PANELS.
1 BLANK PANEL

(3) — 2 SECTIONS OF 4 RAINCROSS PANELS.
2 SECTIONS OF 5 RAINCROSS PANELS.
2 SECTIONS OF 7 RAINCROSS PANELS.
1 SECTIONS OF 8 RAINCROSS PANELS.
6 BLANK PANELS.

(4) — 1 SECTION OF 7 RAINCROSS PANELS.
1 SECTION OF 5 RAINCROSS PANELS.
1 BLANK PANEL.

(5) — 5 SECTIONS OF 6 RAINCROSS PANELS.
2 SECTIONS OF 4 RAINCROSS PANELS.
6 BLANK PANELS.

(6) — 2 SECTIONS OF 6 RAINCROSS PANELS.
3 SECTIONS OF 5 RAINCROSS PANELS.
2 SECTIONS OF 4 RAINCROSS PANELS.
7 BLANK PANELS.

(R/T) — REMOVE TREE. SEE SPECIAL PROVISIONS FOR TREE DIA. & CLASS INVOLVED (PHASE I ONLY)

(7) SALVAGE SHAFT OF ST. LT. STANDARD

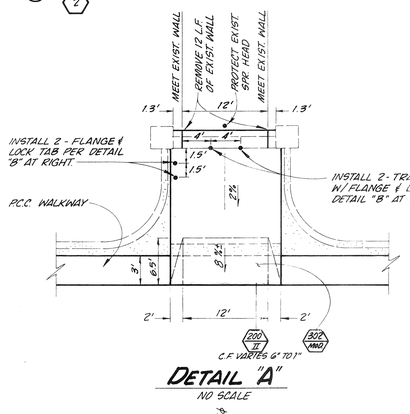

DETAIL "A"

NO SCALE

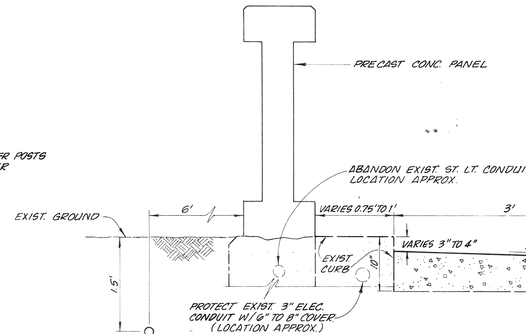

SECTION OF P.C.C. WALKWAY

NO SCALE

LIMITS AS SHOWN ON PLAN

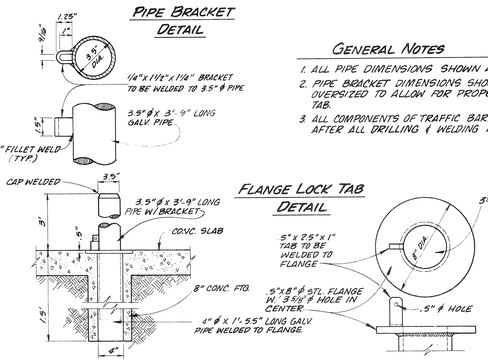

PIPE BRACKET DETAIL

GENERAL NOTES

1. ALL PIPE DIMENSIONS SHOWN ARE OUTSIDE DIA.
2. PIPE BRACKET DIMENSIONS SHOULD BE SLIGHTLY OVERSIZED TO ALLOW FOR PROPER FIT W/ LOCK TAB.
3. ALL COMPONENTS OF TRAFFIC BARRIER TO BE GALV. AFTER ALL DRILLING & WELDING IS COMPLETED.

FLANGE LOCK TAB DETAIL

TRAFFIC BARRIER POST DETAIL "B"

NO SCALE

CAUTION: EXIST. 6.6 AMP. 5 kV. HIGH VOLTAGE SERVICE ST. LIGHT CONDUIT - NOT SHOWN

CAUTION HIGH VOLTAGE ELEC. LINE NOT SHOWN

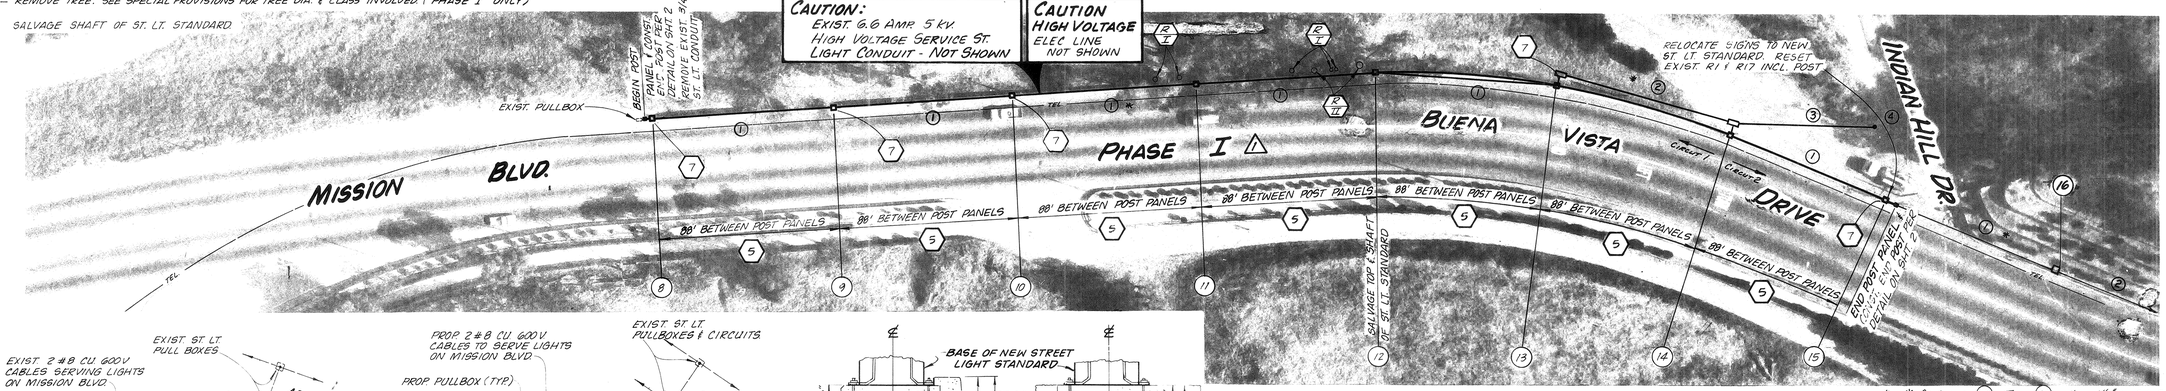

* (1) EXIST. 1 1/2"C - 2 #8.
* * (2) NEW 1 1/2"C - 2 #8
* (3) NEW 1 1/2"C - 4 #8
* (4) RISER UP POLE SERVICE BY OTHERS

* * ST. LIGHT (17) THRU (20) NEW 1 1/2"C - 2 #8

NOTES:
1. SEE MAP IN SPEC. PROVISIONS FOR LIGHTS NO. (16) THROUGH (21)
2. SALVAGE SHAFT OF STREET LIGHT STD. NO. (19)
3. SALVAGE TOP OF STREET LIGHT STD. NO. (21)
4. SALVAGE ALL FIXTURES INCLUDING GLOBES WHICH ARE IN GOOD CONDITION.

* As built 11/86 TE

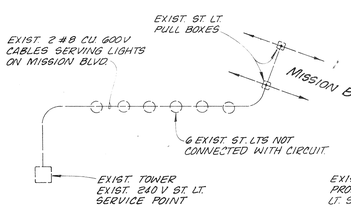

EXIST. ST. LT. CIRCUIT

NO SCALE

(CARLSON PARK)

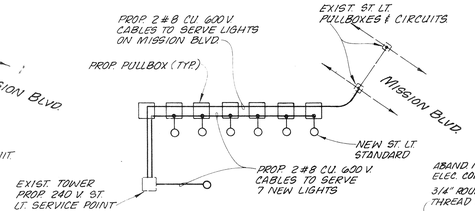

PROP. ST. LT. CIRCUIT

NO SCALE

(CARLSON PARK)

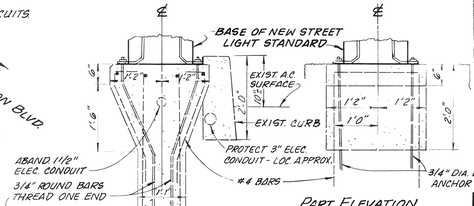

SECTION

PART ELEVATION

NOTE: REPAIR AS NECESSARY EXIST. 3/4" DIA. ANCHOR BOLTS AS PROVIDED IN SECTION 313 OF SPECIAL PROVISIONS.

DETAILS OF RETAINING WALL

SHOWING METHOD OF SUPPORTING LIGHT STANDARD @ BUENA VISTA DRIVE LOCATION

NO SCALE

MARK	REVISIONS	APPR.	DATE
1	CONSTRUCTION TO BE DONE ALONG BUENA VISTA DR. LOCATION UNDER PHASE I. Bid! 1-9-86		1/10/86

DESIGNED BY [illegible] DRAWN BY [illegible] CHECKED BY [illegible]

CITY OF RIVERSIDE
PUBLIC WORKS DEPARTMENT

APPROVED BY	DATE	BY
PRINCIPAL ENGINEER	[illegible]	[illegible]
PARK DEPARTMENT	6-25-86	[illegible]
TRAFFIC DIVISION	6/24/86	[illegible]
CHIEF P.W. ENGINEER	6/25/86	[illegible]

APPROVED BY [illegible]
PUBLIC WORKS DIRECTOR
DATE June 16, 1986

EMERGENCY JOBS BILL - 1983

BUENA VISTA DRIVE - CARLSON PARK

MT. RUBIDOUX BRIDGE TO SANTA ANA RIVER

HORIZ. SCALE: 1" = 40'

ACCOUNT NO. 15-551-458

R-2582

SHEET 1 OF 2