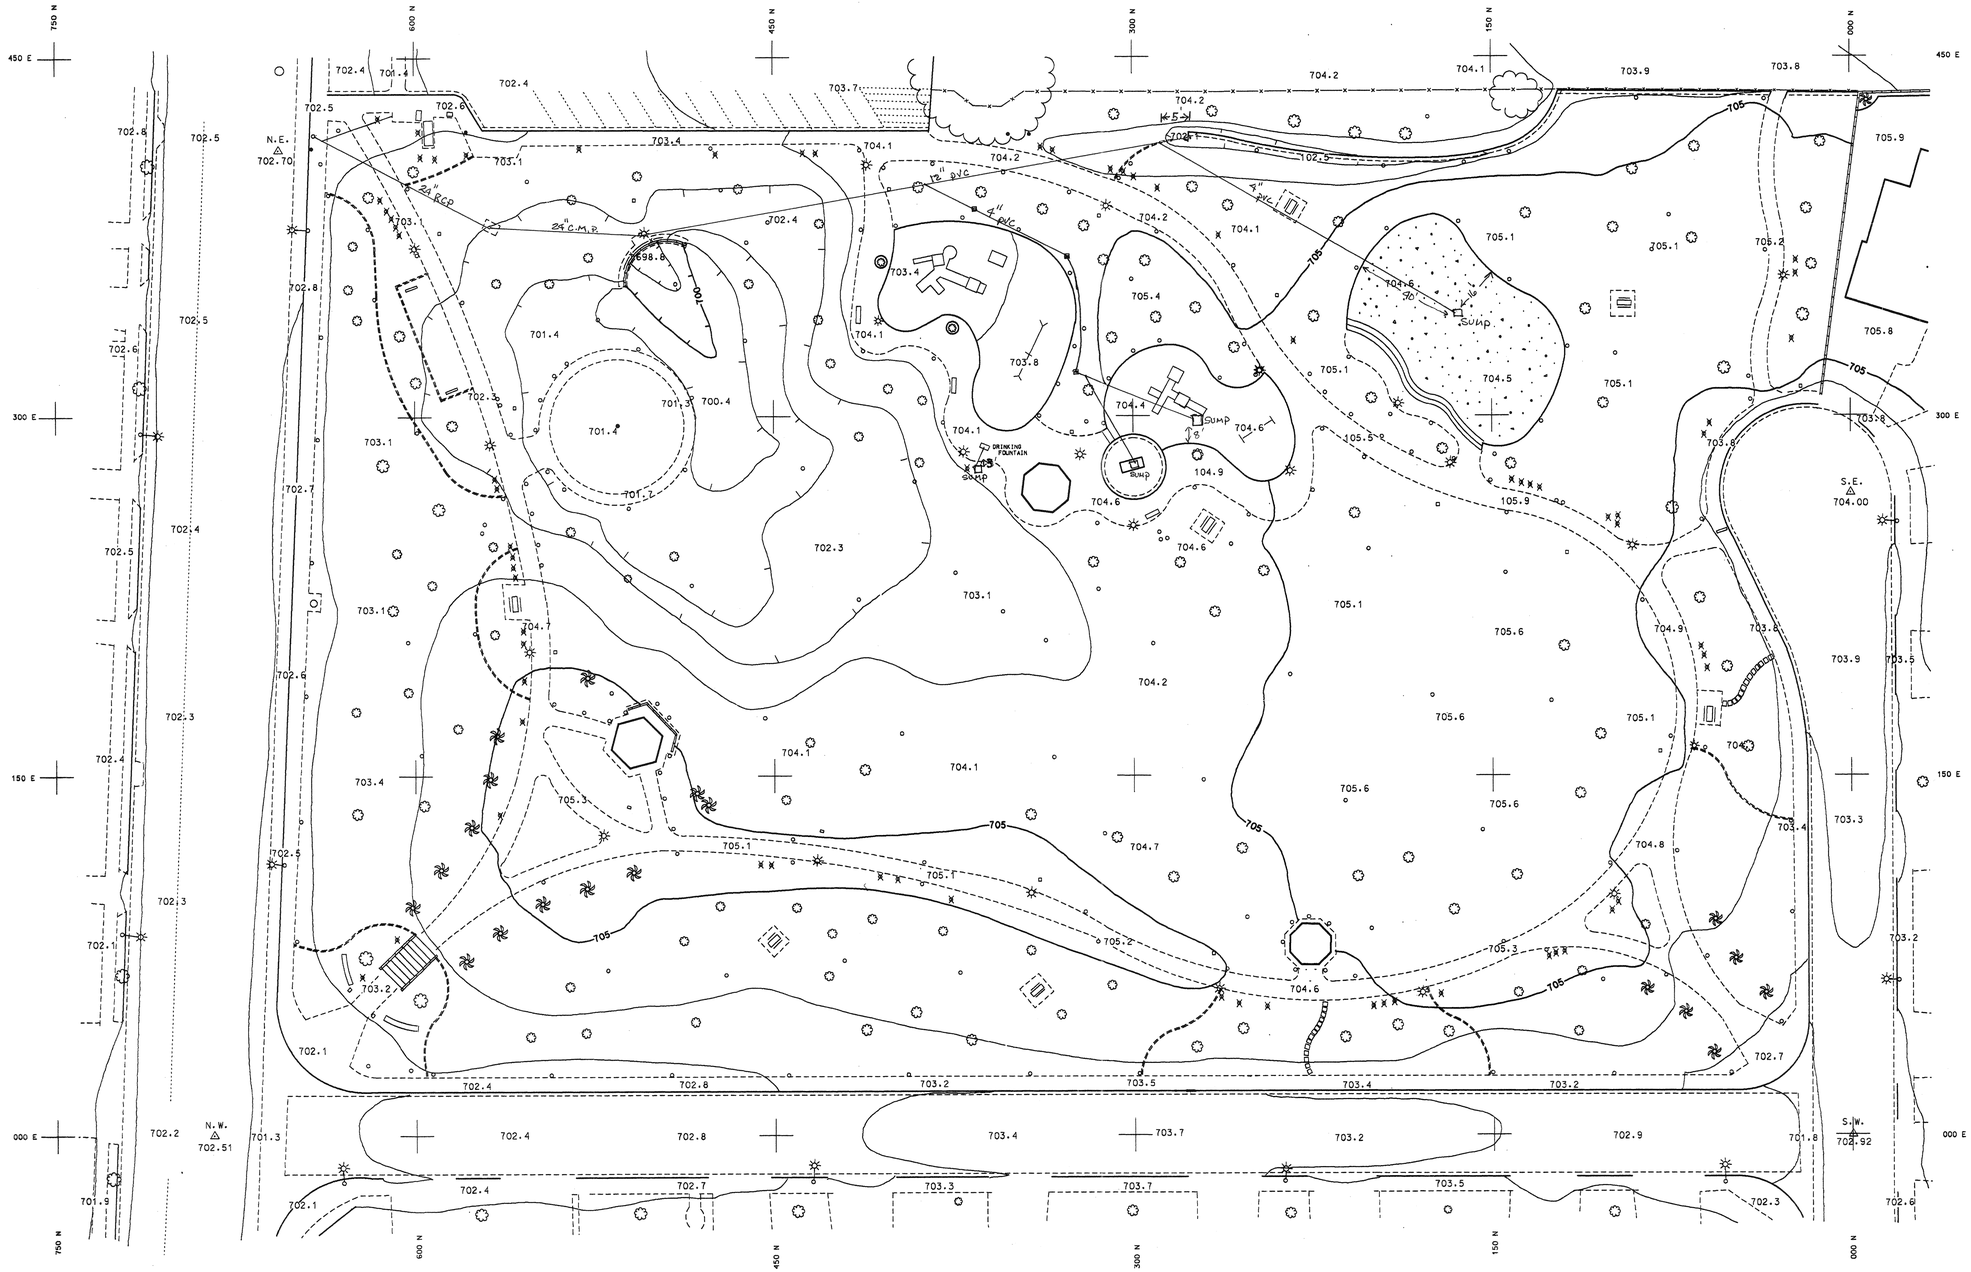


AS-BUILT DRAINAGE 2-1-96

# COLLETT PARK

COMPILED BY PHOTOGRAMMETRIC METHODS

FROM PHOTOGRAPHY DATED JAN. 5,1996

NORTH

PLAN NORTH

SCALE IN FEET

0 10 20 30 40 50 60 70 80 90 100

## LEGEND

- 705 — INDEX CONTOUR
- INTERMEDIATE CONTOUR
- 702.4 — SPOT ELEVATION
- CURB AND GUTTER
- EDGE OF CONCRETE
- FENCE
- WALL
- PAINTED LINE
- STRUCTURE
- LIGHT STANDARD
- LIGHT
- TREE
- PALM TREE
- BENCH
- ELECTRIC BOX
- SPRINKLER VALVE
- SPRINKLER
- DRAIN
- POLE
- SURVEY POINT
- PICNIC TABLE

WESTERN AERIAL SURVEYS

RIVERSIDE VENTURA