FA1
PLAN HOLD CORPORATION • IRVINE, CALIFORNIA
REORDER BY NUMBER 075AR
POSITION EDGE OF PRINT ON THIS LINE

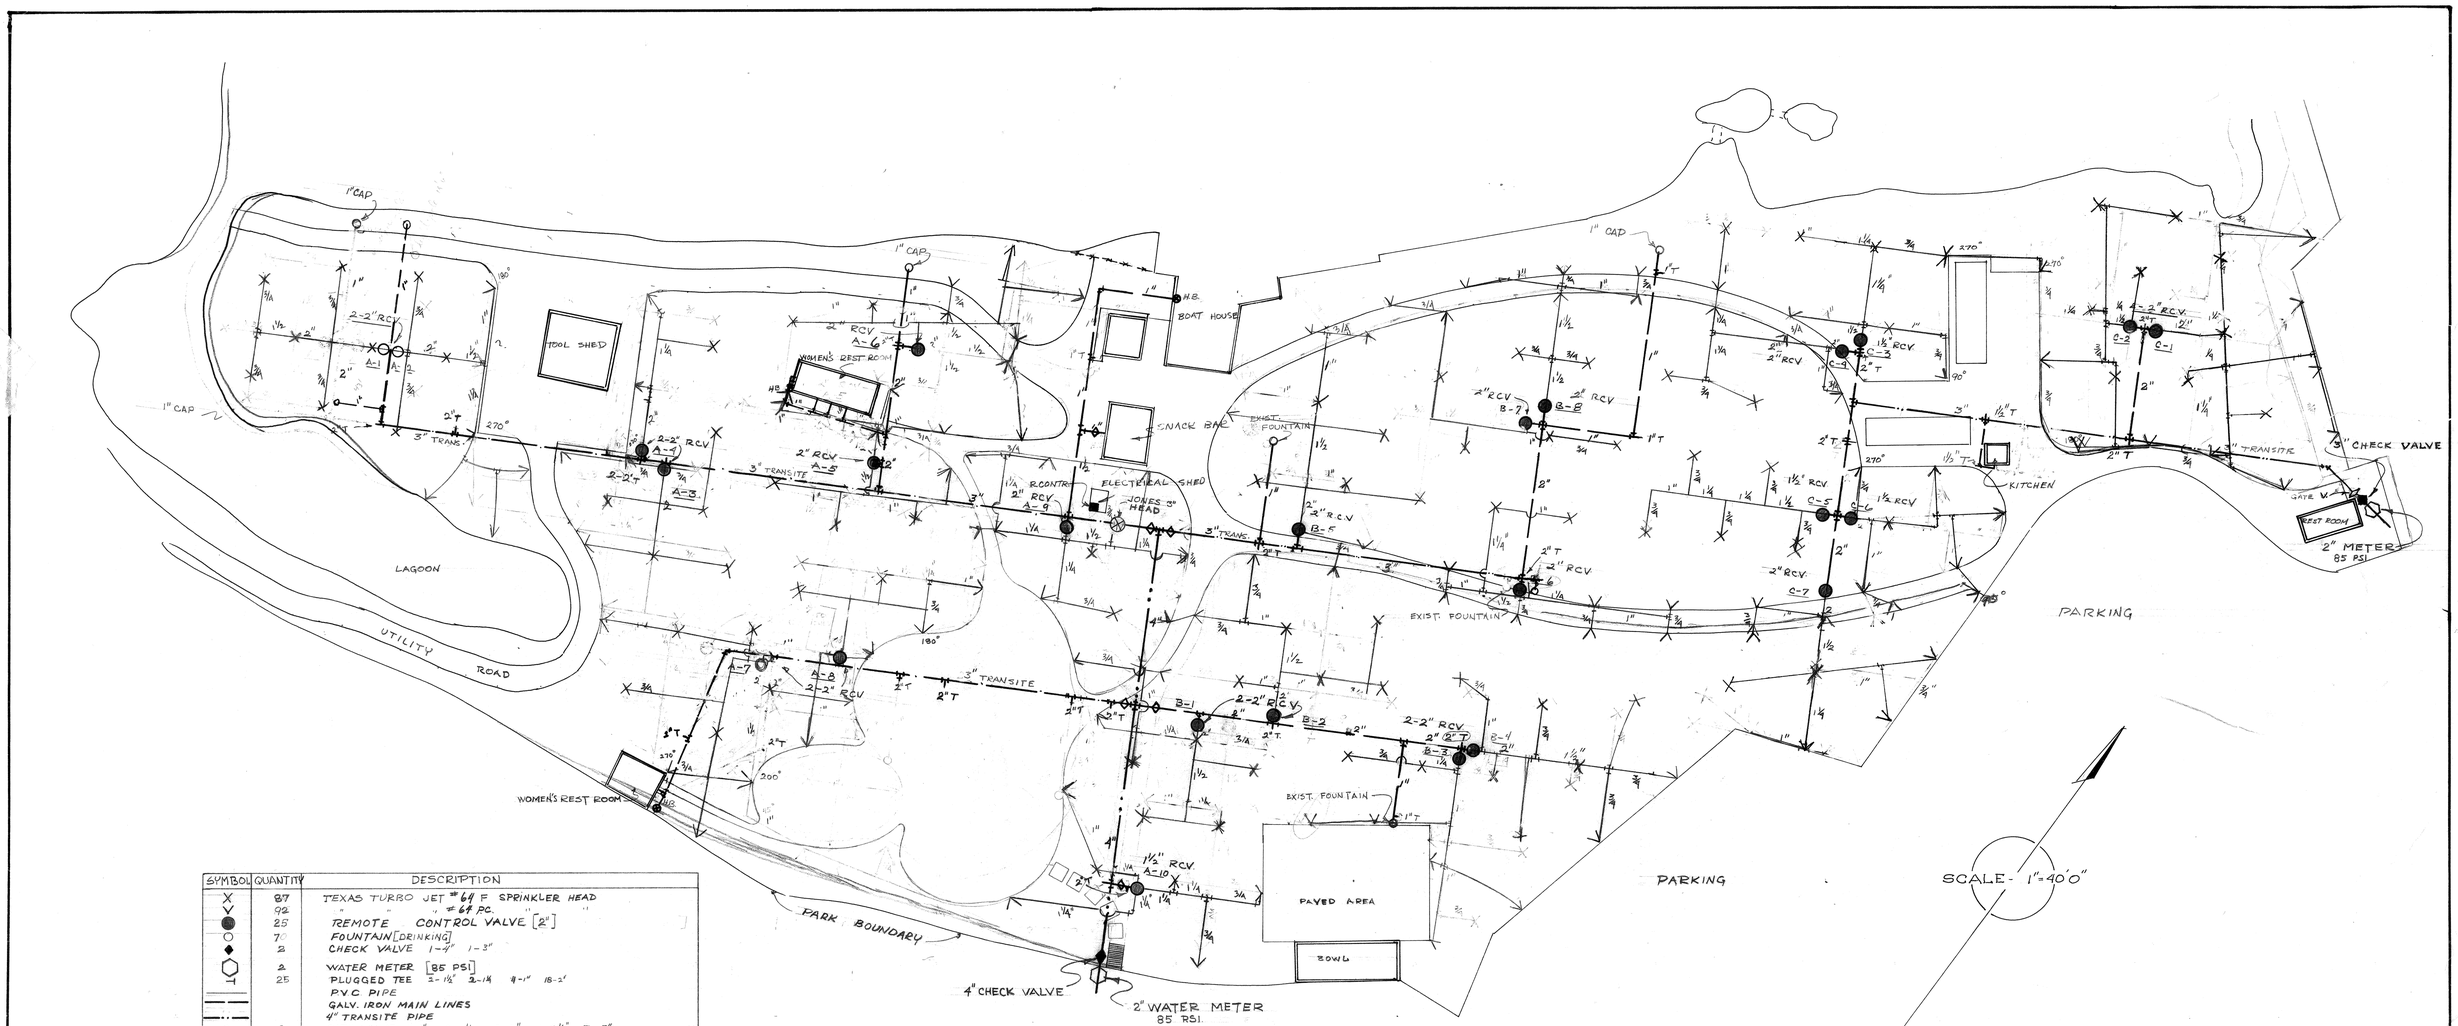

SYMBOL	QUANTITY	DESCRIPTION
X	87	TEXAS TURBO JET #69 F SPRINKLER HEAD
V	92	" " " #69 PC. "
●	25	REMOTE CONTROL VALVE [2"]
○	7	FOUNTAIN [DRINKING]
◆	2	CHECK VALVE 1-4" 1-3"
⬡	2	WATER METER [85 PSI]
T	25	PLUGGED TEE 2-1½" 2-1¼ 9-1" 18-¾"
		P.V.C. PIPE
		GALV. IRON MAIN LINES
		4" TRANSITE PIPE
◇	9	GATE VALVE 1-1", 2-1½", 2-2", 1-2½", 3-3"
●	3	HOSE BIB ¾" BENT NOSE GARDEN VALVE

SCALE - 1"-40'0"

IRRIGATION SYSTEM
FAIRMOUNT PARK
CITY of RIVERSIDE - PARK & RECREATION DEPT.
1-7-60

0 20' 40' 60' 80'

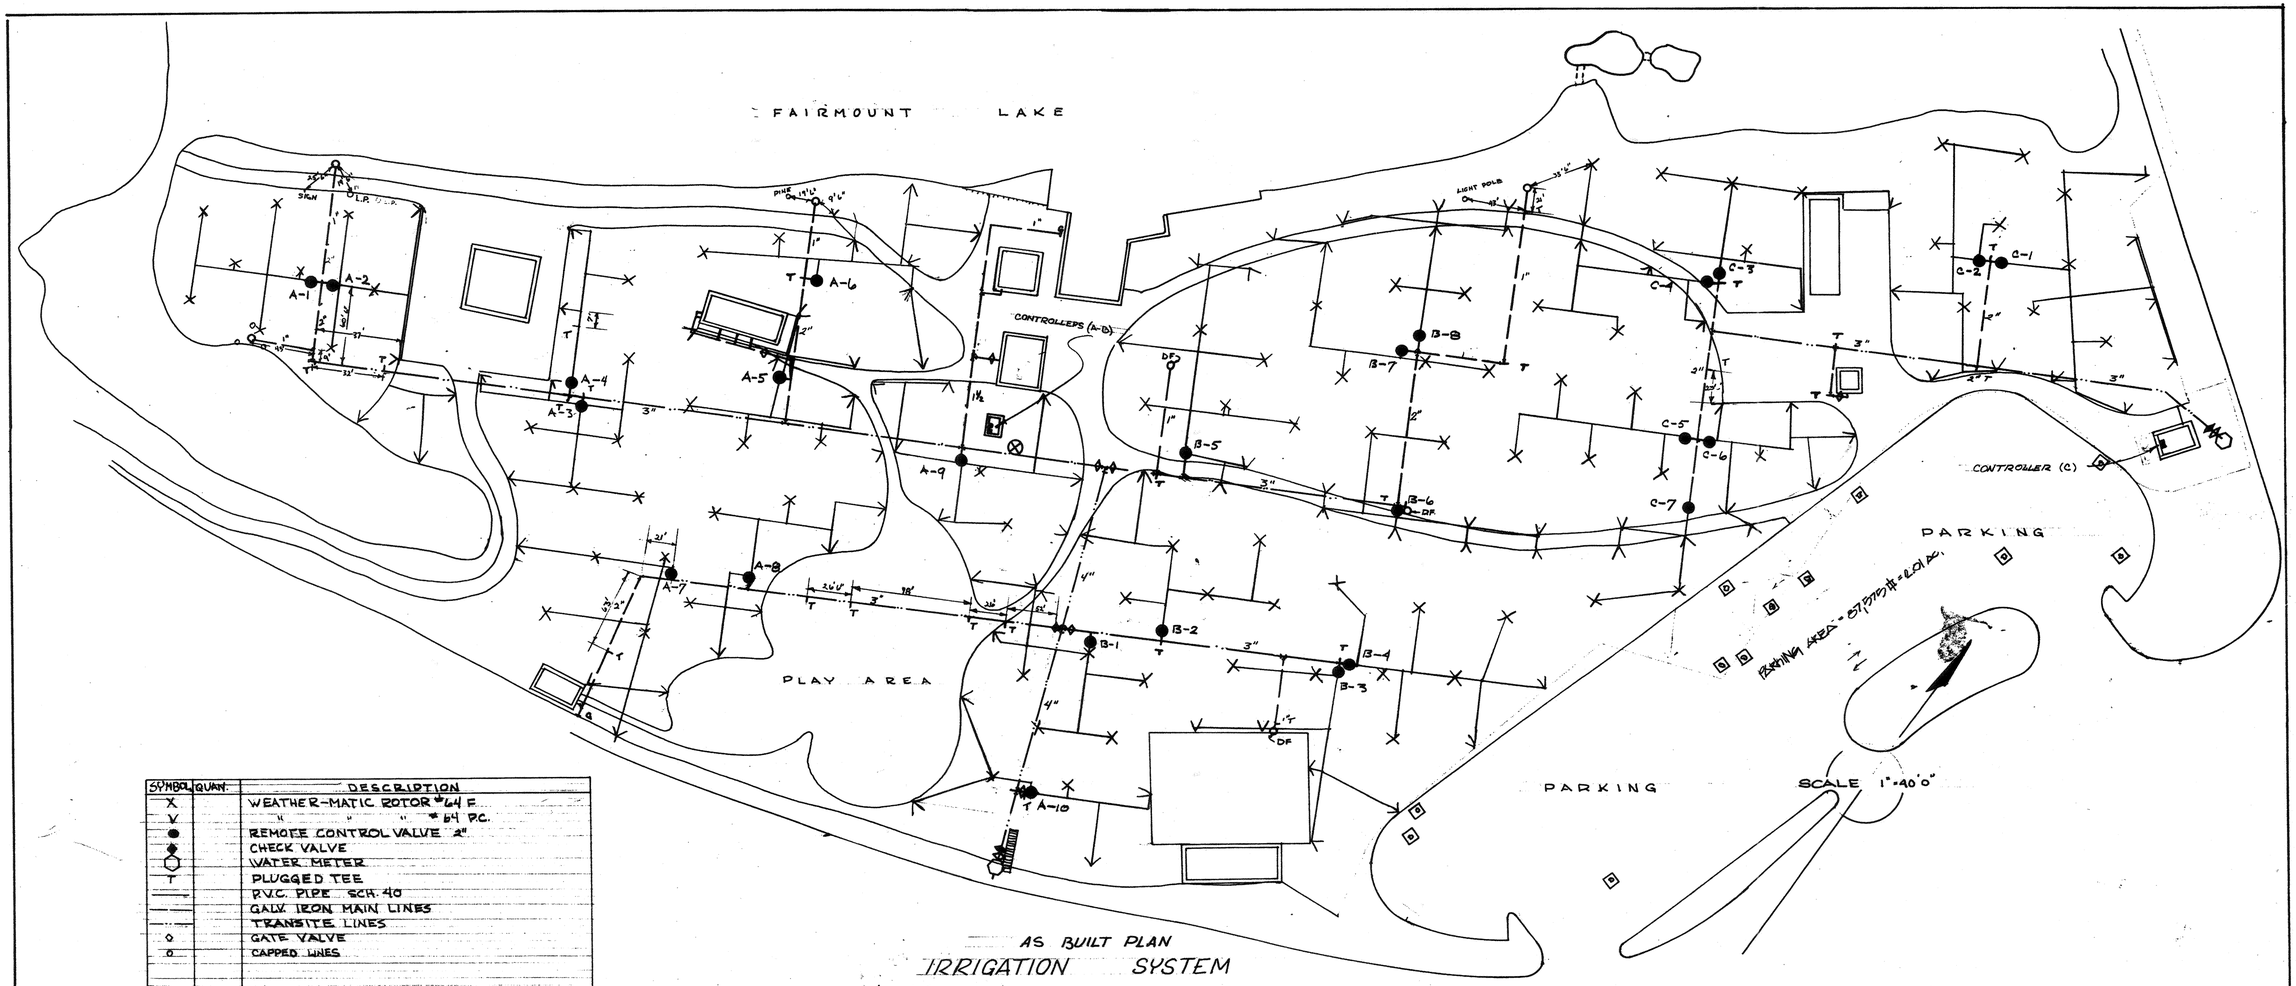

SYMBOL	QUAN.	DESCRIPTION
X		WEATHER-MATIC ROTOR #64 F.
V		" " " #64 P.C.
●		REMOTE CONTROL VALVE 2"
◆		CHECK VALVE
⬡		WATER METER
T		PLUGGED TEE
——		P.V.C. PIPE SCH. 40
——		GALV. IRON MAIN LINES
- - -		TRANSITE LINES
◇		GATE VALVE
o		CAPPED LINES

AS BUILT PLAN

IRRIGATION SYSTEM

FAIRMOUNT PARK

CITY of RIVERSIDE PARK & RECREATION DEPT.

60' SCALE

P-88

-116

DRAWING NUMBER FA 30

PLAN HOLD CORPORATION • IRVINE, CALIFORNIA
REORDER BY NUMBER 075AR

FAIRMOUNT PARKING LOT

SPRINKLER SYSTEM

CITY OF RIVERSIDE - PARK DEPT.

8/25/61

SCALE — 1" = 20'

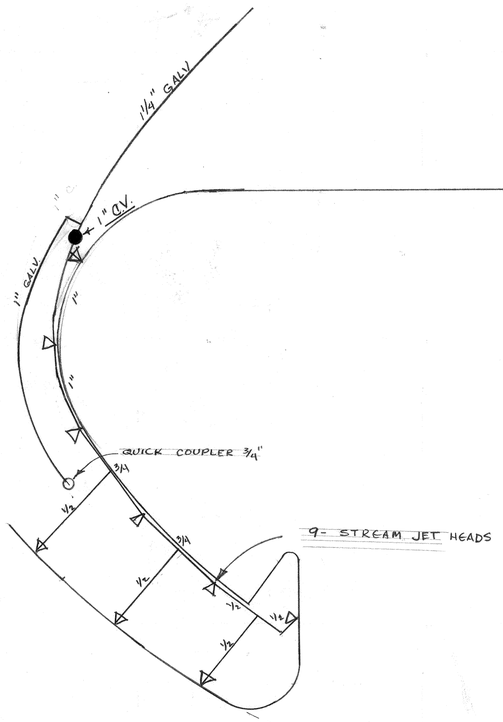

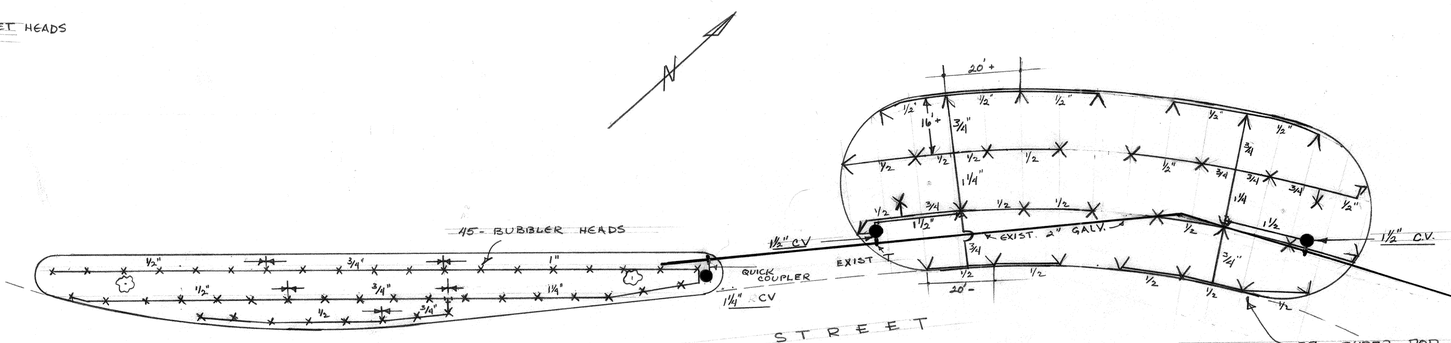

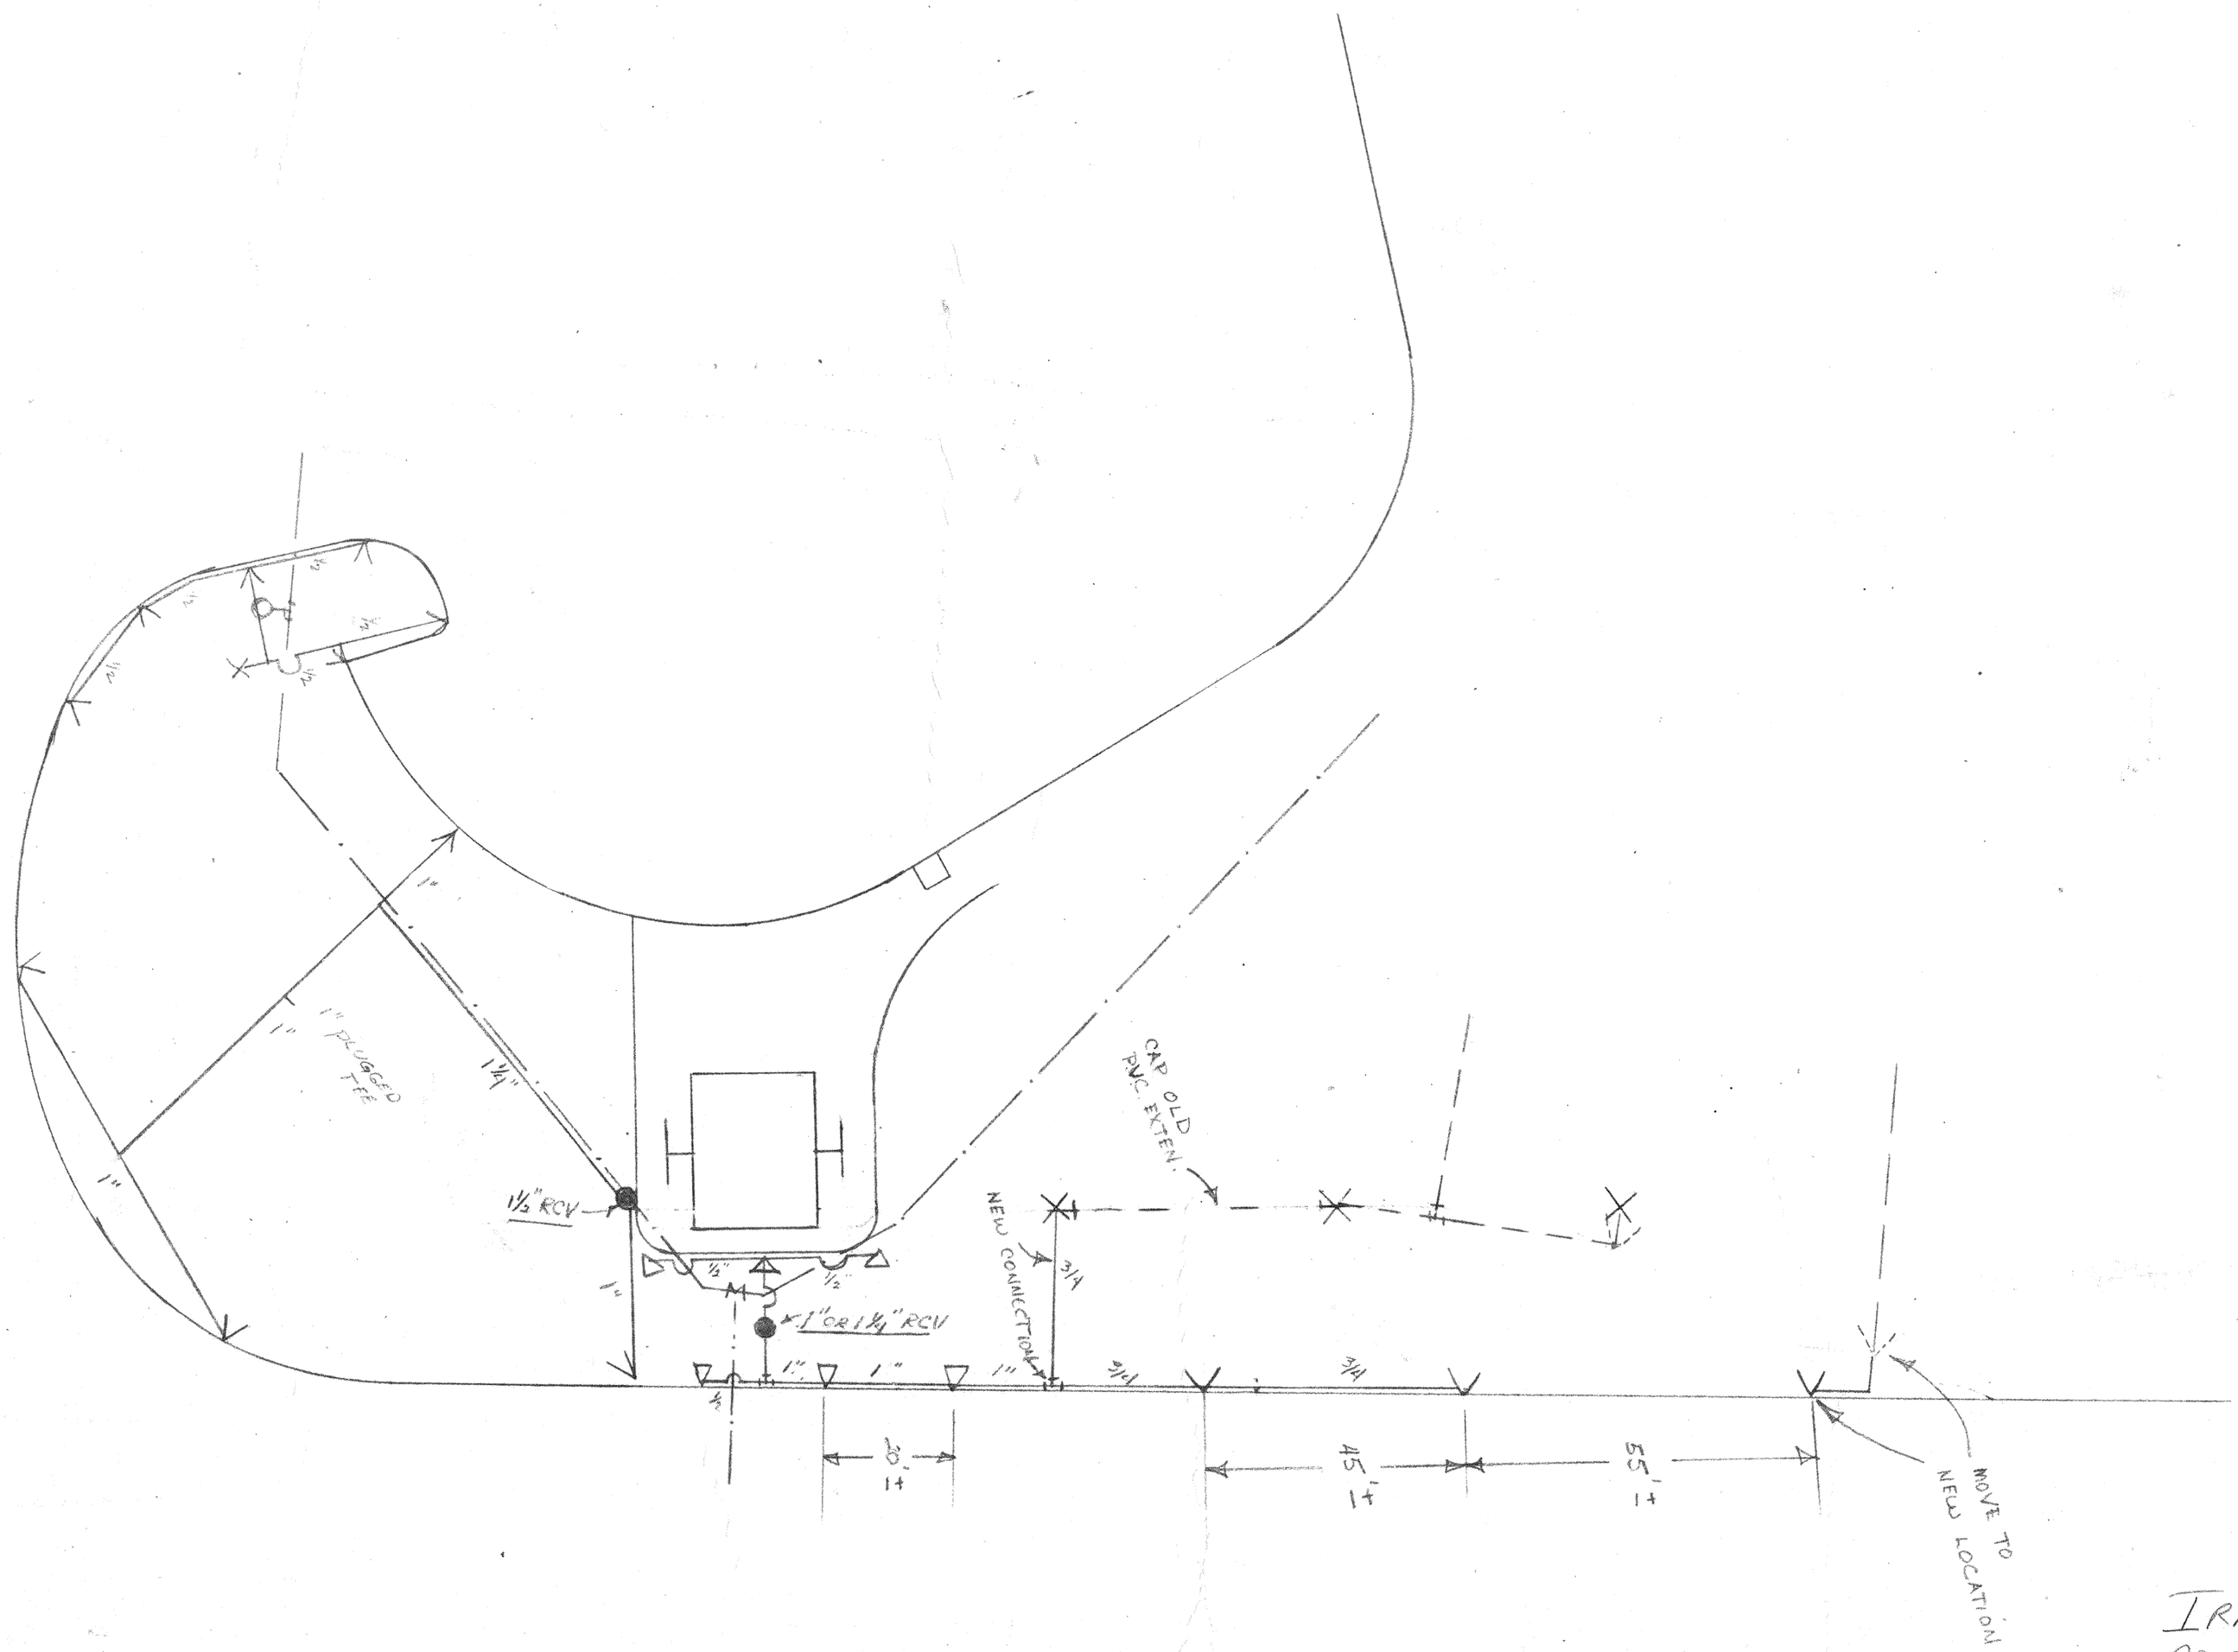

IRRIGATION PLAN
BOWLING GREEN DR

P-116-75

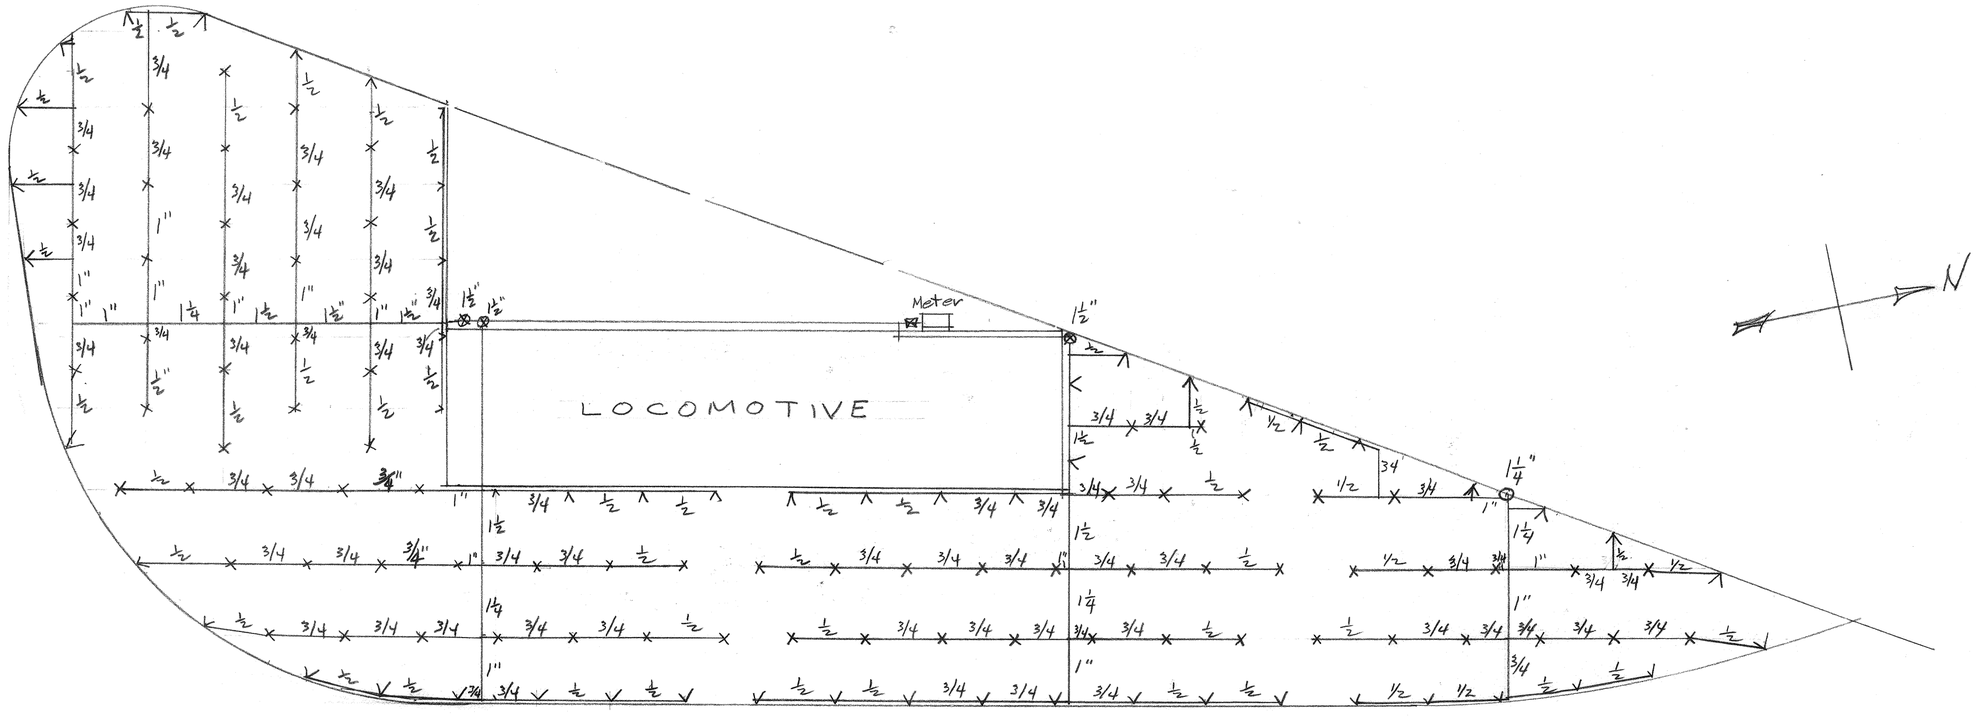

FAIRMOUNT PARK
SPRINKLER SYSTEM
AT LOCOMOTIVE
SCALE 1" = 20'
ELK 3-23-55

3
Mar
55

DRAWING NUMBER
FA1
PLAN HOLD CORPORATION • IRVINE, CALIFORNIA
REORDER BY NUMBER 075AR

DRAWING NUMBER
FA-16
PLAN HOLD CORPORATION • IRVINE, CALIFORNIA
REORDER BY NUMBER 075AR

P-116-8

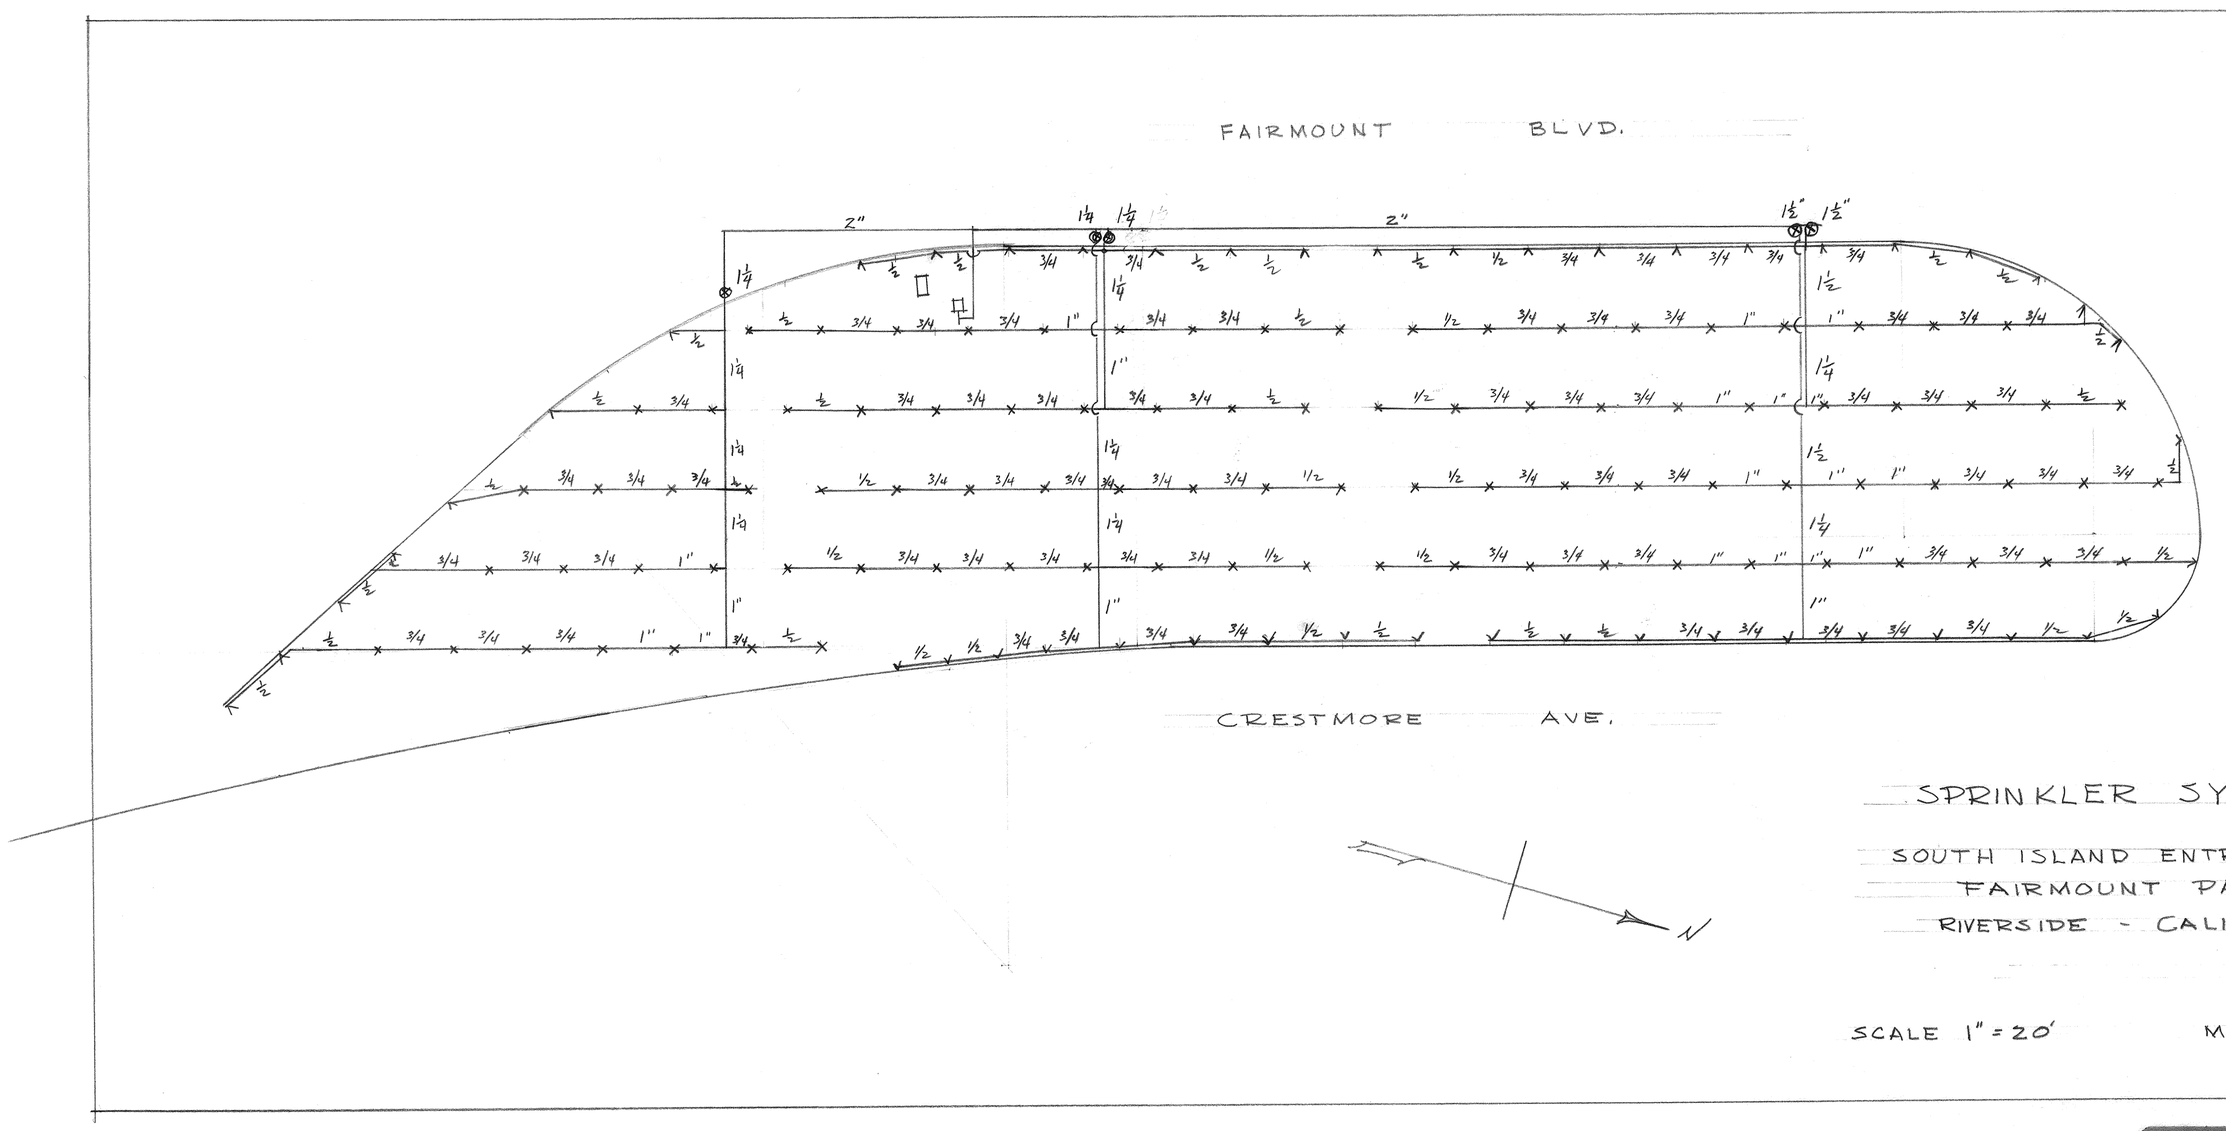

SPRINKLER SYSTEM

SOUTH ISLAND ENTRANCE TO
FAIRMOUNT PARK
RIVERSIDE - CALIFORNIA

SCALE 1" = 20'

MAY 3, 1955

3 MAY 55

P-116-9

PLAN HOLD CORPORATION • IRVINE, CALIFORNIA
REORDER BY NUMBER 075AR