SPRINKLER LEGEND

X	400 GP. WEATHERMATIC TURBO-JET
V	400TPG. WEATHERMATIC TURBO-JET 180° UNLESS OTHERWISE INDICATED
V	#18-412 THOMPSON
FG	#1004-12 THOMPSON
X	2" PRESSURE VACUUM BREAKER

NOTE:
WALKS, COURTS, PARKING LOT, AND PLAY AREAS ARE ═══ INSTALLED. ------

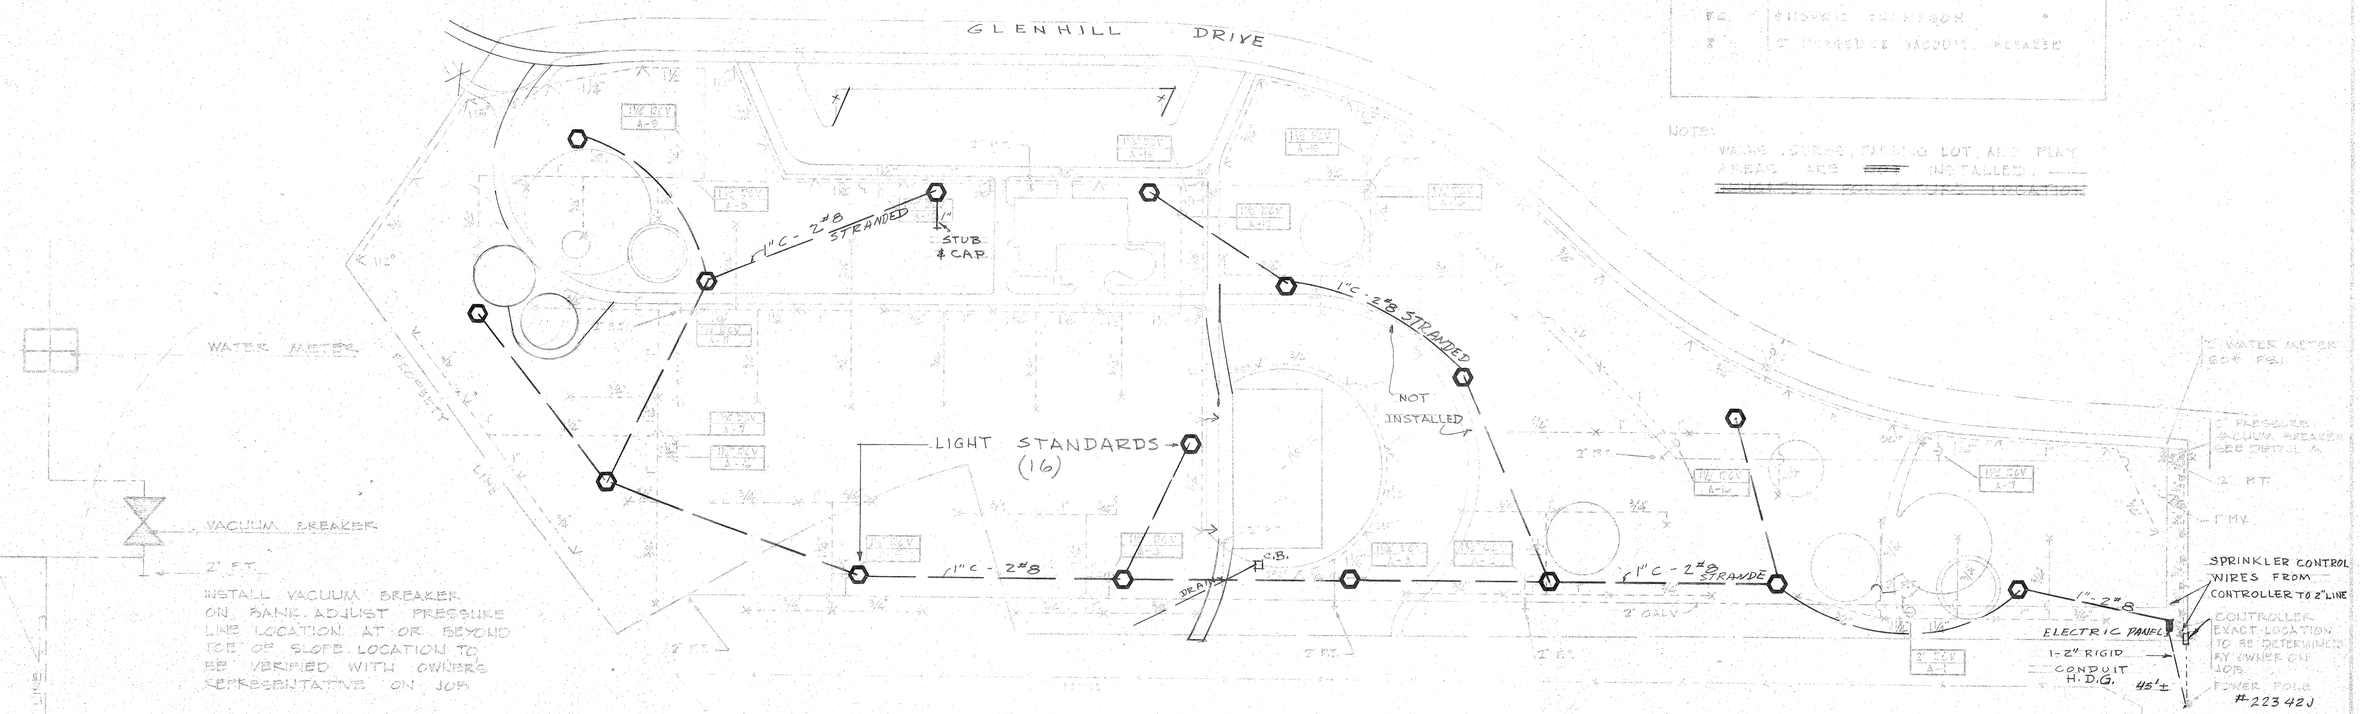

DETAIL A
VACUUM BREAKER LOCATION
NO. SCALE

PIPE AND VALVE LEGEND

	SCHEDULE 40 GALVANIZED
	P.V.C. #160 CLASS
	2" FLUSHED TEE
	REMOTE CONTROL VALVE, SIZE AS INDICATED TELCO 2-20 A1 SERIES WITH FLOW CONTROL ADJUSTER
	MANUAL VALVE
	CONTROLLER - TELCO

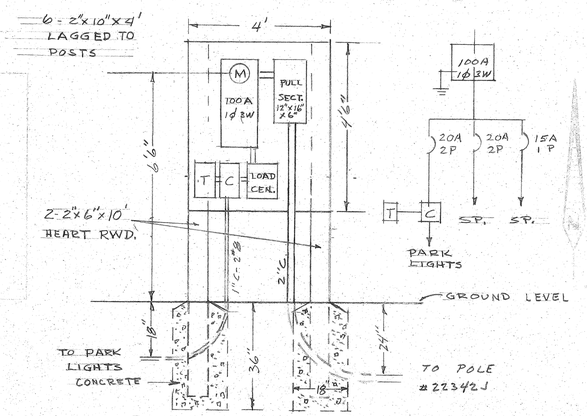

SERVICE PANEL DETAIL

LIGHTING PLAN

OVERLAY ON
SPRINKLER PLAN
HIGHLAND PARK
780 GLENHILL DRIVE
RIVERSIDE CALIFORNIA
SCALE 1"=40' DATE: 8-12-66
REVISED APRIL 6, 1971

P-120-5