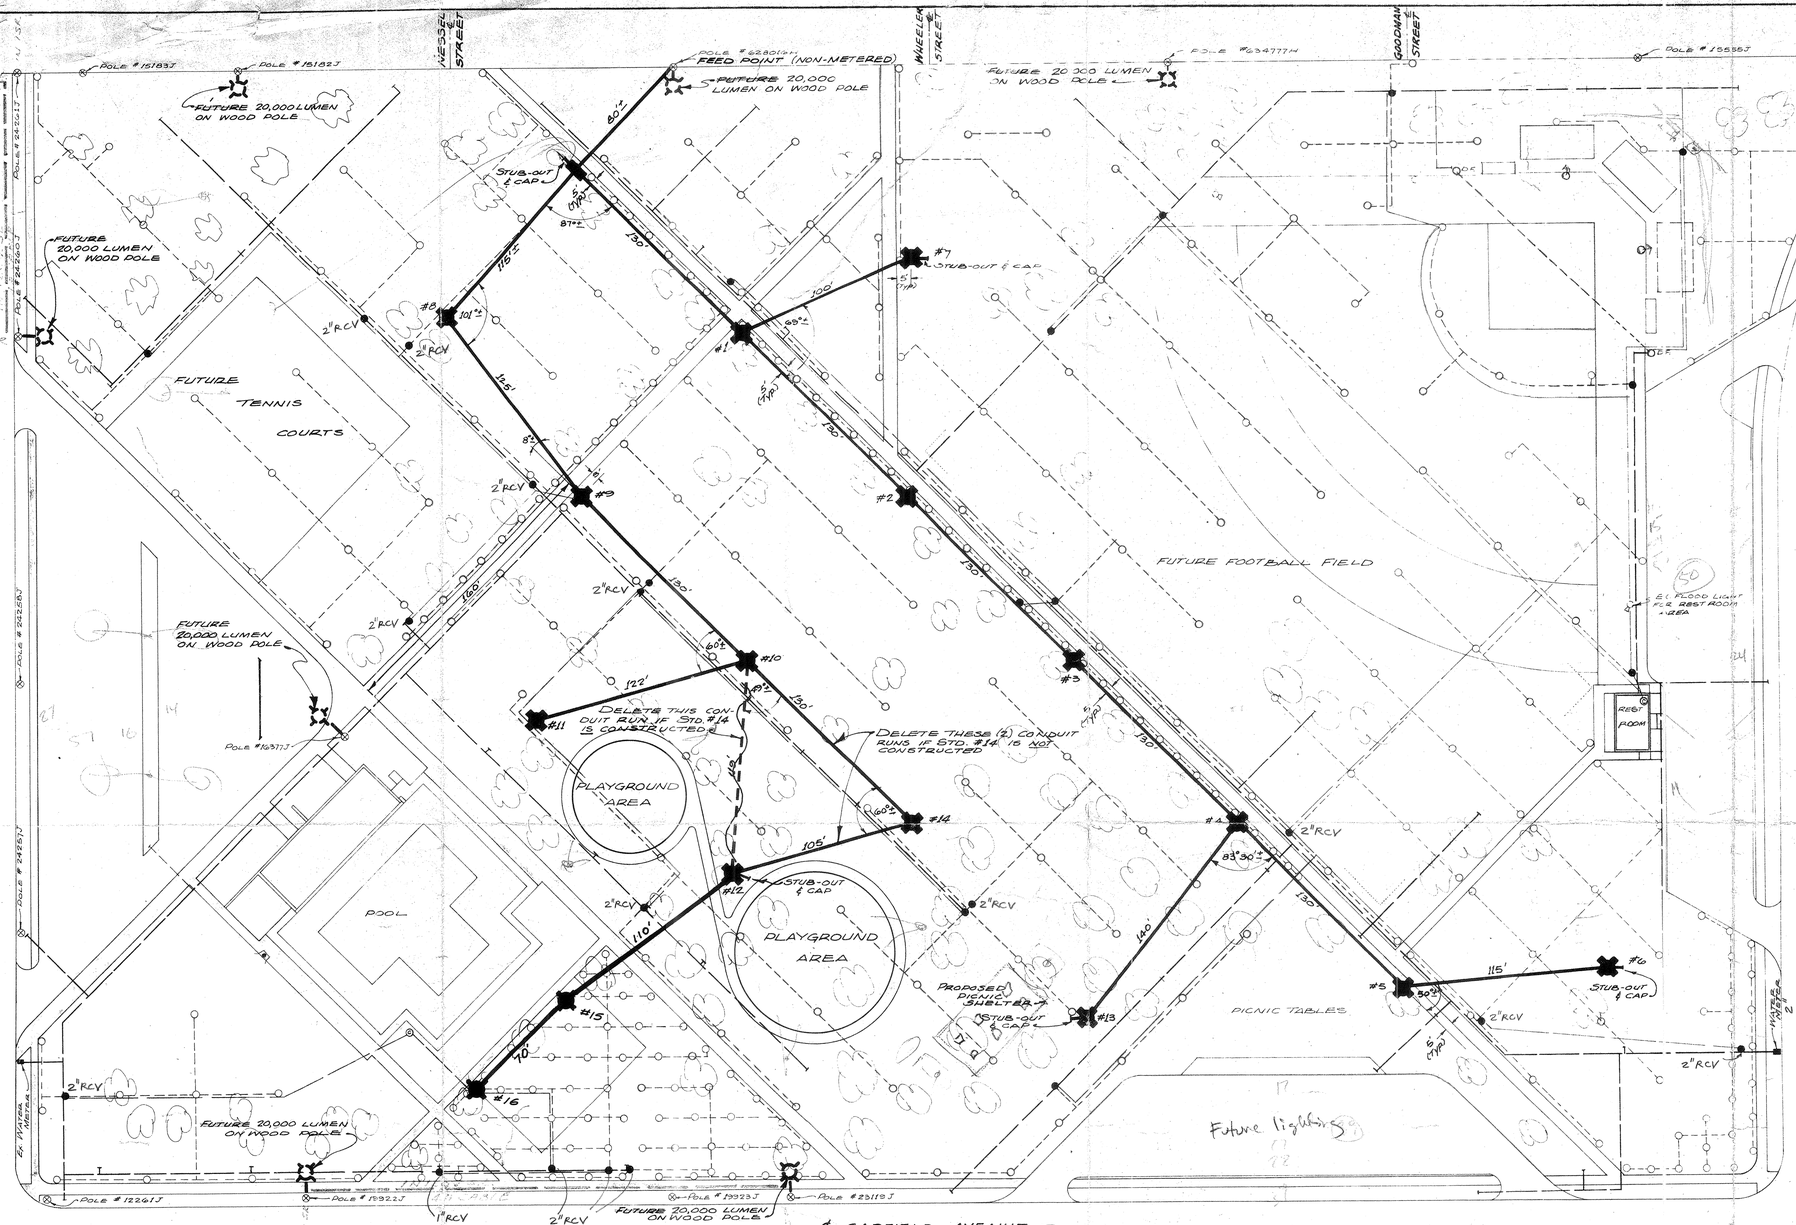

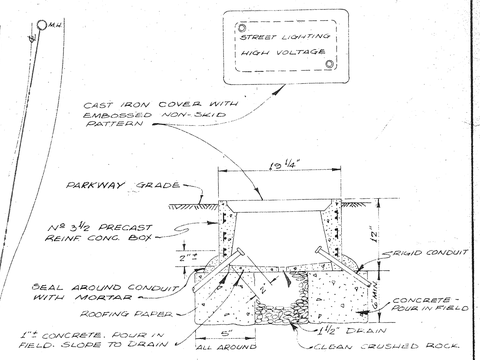

PULL BOX WITH TRAFFIC COVER

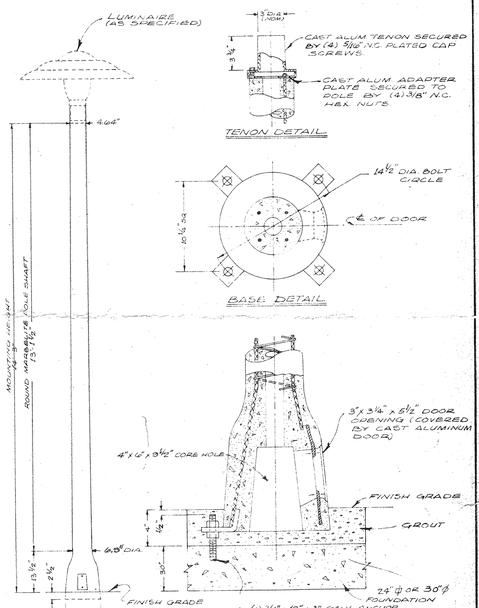

MARBELITE LIGHTING STANDARD No 1214-T WITH POLE TOP LUMINAIRES

SCALE: 1"=40'

Ex. LIGHT STD. #4104

Ex. LIGHT STD. #4104

GENERAL NOTES AND LEGEND

- INDICATES 1" RIGID GALVANIZED CONDUIT WITH MINIMUM OF 18" COVER.
- INDICATES No 3½ BROOKS INC. PULL BOX OR APPROVED EQUAL, WITH CAST IRON COVER.
- INDICATES MARBELITE LIGHTING STANDARD, DESIGN No 1214-T WITH POST TOP LUMINAIRE.

1. ALL LUMINAIRES SHALL BE POST MOUNTED, WITH INTERNAL SLIPFITTER, AND LEVELING SCREWS, DESIGNED FOR 3" O.D. POLES. EACH LUMINAIRE SHALL HAVE A BUILT-IN, 175 W. CONSTANT WATTAGE BALLAST WIRED FOR 240 V AND SHALL HAVE A PLASTIC REFRACTOR WITH I.E.S. TYPE V DISTRIBUTION, JOSLYN CAT. # J185041A, OR AN APPROVED EQUAL.
2. ALL LAMPS SHALL BE 175W, 7000 LUMEN, COLOR IMPROVED, G.E. CAT. # H 175 C39-22, (A.S.A. CODE H39-22K C/I) OR AN APPROVED EQUAL.
3. ALL CABLE SHALL BE AWG # 8 COPPER AS PER SPECIFICATIONS.
4. ALL CONSTRUCTION AND MATERIALS SHALL COMPLY WITH THE ATTACHED SPECIFICATIONS.
5. INSPECTIONS SHALL BE CALLED FOR AS OUTLINED IN THE SPECIFICATIONS. CALL HAROLD KING AT (WEBB ASSOC. (686-1070) 24 HOURS PRIOR TO TIME AN INSPECTION IS NEEDED.
6. IF THE WIDTH OF THE TRENCH DOES NOT EXCEED 6", THE PARK TURF WILL NOT NEED TO BE TRANSPLANTED.
7. THE CONTRACTOR SHALL DO ALL NECESSARY MEASURING FOR CONSTRUCTION STAKING.
8. THE CONTRACTOR SHALL PAY THE $7500 CONNECT FEE TO THE PUBLIC UTILITIES DEPARTMENT PRIOR TO THE FINAL INSPECTION.
9. NO STENCILED NUMBERS REQUIRED ON STANDARDS.
10. THIS SYSTEM TO BE 2 WIRE 240 V. MULTIPLE.
11. PHOTOELECTRIC CONTROL AND BREAKER WILL BE INSTALLED BY THE PUBLIC UTILITIES DEPARTMENT ON THE POWER POLE DESIGNATED AS THE FEED POINT ON THIS PLAN.
12. THE CONTRACTOR SHALL PRESENT AN "AS BUILT" PRINT TO THE PARK & RECREATION DIRECTOR UPON COMPLETION OF CONTRACT WORK.

FUTURE STREET LIGHT ON WOOD POLE

INTERFERENCE NOTES AND LEGEND

- WATER LINE (1" OR 2") STEEL
- SPRINKLER SYSTEM LINE (PVC)
- PNEUMATIC CONTROL LINE
- SPRINKLER HEADS
- REMOTE CONTROL VALVES
- AUTOMATIC SPRINKLER CONTROLS

THE INTERFERENCES SHOWN ON THIS PLAN ARE AS ACCURATE AS THE RECORDS SHOW. IT SHALL BE THE CONTRACTOR'S RESPONSIBILITY TO DETERMINE THE EXACT LOCATION OF ALL INTERFERENCES INVOLVED IN THE ACTUAL CONSTRUCTION.

NOTES

* INDICATE 400 W.M.V. MOV. CU. K TO LAMP LUMINAIRE COMPLETE WITH PHOTOELECTRIC CONTROL AND BREAKER AS SPECIFIED.

7 UNITS TO BE INSTALLED ON FUTURE LIGHTING CIRCUIT #1, FROM PANEL #2 LOCATED IN [illegible]

REVISIONS	DATE	BY
As Built	11-30-65	TLO
Added Stds. 15 & 16 (Std. 14 was Constructed)	6-7-65	HWK

CITY OF RIVERSIDE
PARK & RECREATION DEPARTMENT

HUNT PARK LIGHTING SYSTEM

LAYOUT PLAN & DETAILS

APPROVED:

DIRECTOR of Park and Recreation — DATE 5-16-66

SCALE AS NOTED	
DATE 3/8/65	
DRAWN JS	
TRACED	
CHECKED F.H.H.	
E.S. H.W.K.	

ALBERT A. WEBB ASSOCIATES
CIVIL ENGINEERS
RIVERSIDE CALIFORNIA

W.O. 65-69
SHEET 1 OF SHEETS
DWG. NO. P-121-29