HUNT PARK RESTROOM

7-8-81

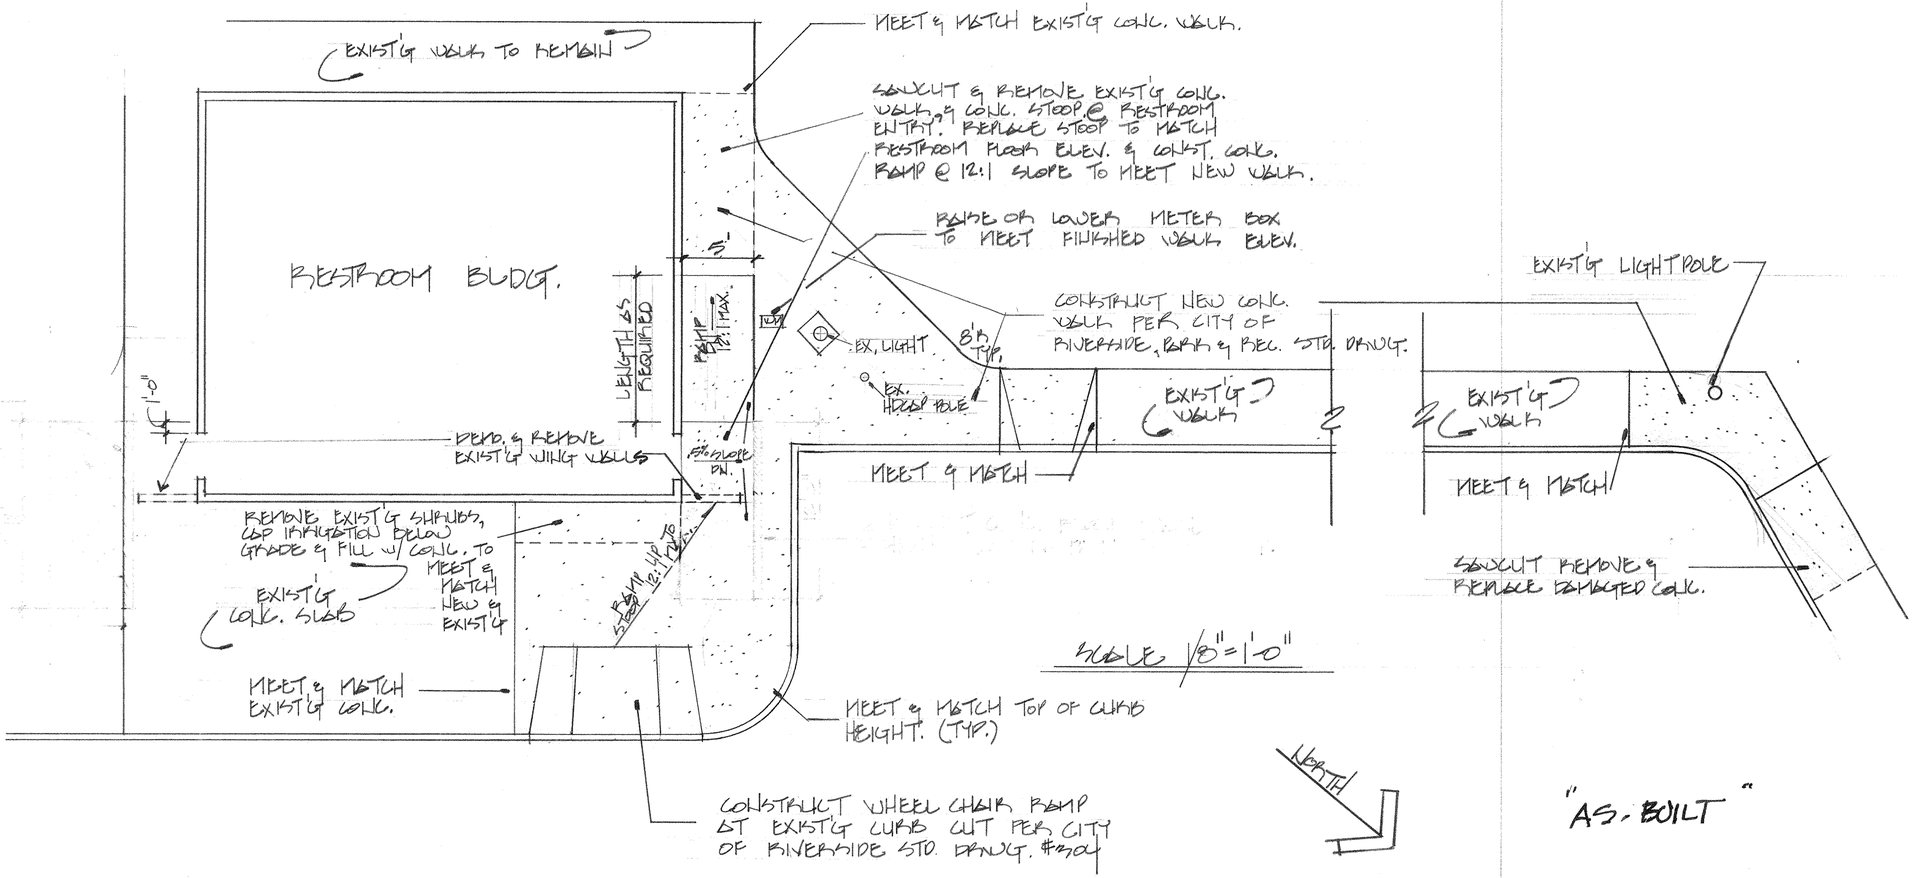

"AS-BUILT"