SINCE 1964

STATE LICENSE No. 319196

K&Z CABINET CO. INC.

1450 SOUTH GROVE AVE., ONTARIO, CA. 91761

PHONE No. 909 947-3567 FAX No. 909 947-3264

WOODWORK INSTITUTE OF CALIF.
SINCE 1966

CONSTRUCTION SPECIFICATIONS INSTIT.
INDUSTRY MEMBER

job name : RENCK COMMUNITY CENTER

address : 4015 JACKSON STREET (HUNT PARK) RIVERSIDE

architect : L.M. TAKITA ARCH.

general contractor: CAMBRIDGE CONSTR

MAP LOCATION

SHEET INDEX

No	DESCRIPTION

GENERAL SPECIFICATIONS

1 CABINET EXTERIORS: All exposed vertical surfaces shall be 1/32" high pressure plastic laminate. Laminate to be 11/16", 3/4", or 1" 45 lb. density particleboard core material. Plastic shall be applied under pressure with cold setting waterproof glue. Edge banding (BIRCH) PLYWOOD - CAB. BODY.

LUMBERCORE - DOORS

PRIME & PAINTED BY OTHERS PRIOR TO ERECTION

2 CABINET INTERIORS: Semi-exposed portions - PRIME PAINTED (ON PLYWOOD) BY OTHERS

DOOR INSIDE: PRIME PAINTED

4 CONSTRUCTION: 8 mm x 30 mm wood dowels spaced per W.I.C. Section 15, Page 10, Para.IX.A.5.b.

5 DRAWERS: Constructed of 1/2" PLYWOOD sides, back and sub-front. Dowel joints with 8 mm x 30 mm wood dowels. 1/4" bottom let into sides, back and sub-front. Drawers mounted on metal side guides. File drawers mounted on full-extension metal guides.

6 SHELF ADJUSTMENT: Metal clips in 1/4" holes @ 32 mm O.C., or metal shelf standards as indicated.

7 COUNTER TOPS: Surface material shall be .042 post forming high pressure plastic laminate. Core to be 3/4" particleboard. Backing sheet to be .020 PHENOLIC Ply., edge treatment as selected by the Architect. 0.0625 1/16"

8 LAMINATE PLASTIC COLOR: As selected by the Architect from Wilsonart or Formica's "standard" colors.

COUNTER TOPS & RECEPTION DESK TOP & PUBLIC COUNTER (INCL. VERT. SURFACES)

BACK PRIMED & PAINTED BY OTHERS

HARDWARE

FINISH:	SHALL MATCH THE FINISH OF THE LOCKSETS
HINGES:	BLUM # 75M 5580 120° S.C.
PULLS:	STAINLEY # 4483 — 3" C TOC.
MAGNETIC CATCHES:	
ELBOW CATCHES:	IVES # 2A-92
LOCKS:	NATIONAL # C8173-7/8" & C8179-1 3/8"
DRAWER SLIDES:	ACCURIDE # 4034 = 150LB FULL EXT.
FILE DRAWER SLIDES:	
SHELF SUPPORT:	K&V # 346 FOR DRILLED HOLES.
OTHER HARDWARE:	

HARDWARE SUBSTITUTION/REASON

PROVIDE DOUBLE-D INSERT ON THE CABINET LOCK

ARCHITECT STAMP

☐ NO EXCEPTION TAKEN ☒ MAKE CORRECTIONS NOTED
☐ REJECTED ☐ REVISE AND RESUBMIT
☐ SUBMIT SPECIFIED ITEM

Checking is only for general conformance with the design concept of the project and general compliance with the information given in the contract documents. Any action shown is subject to the requirements of the plans and specifications. Contractor is responsible for: dimensions which shall be confirmed and correlated at the job site; fabrication processes and techniques of construction; coordination of his work with that of all other trades; and the satisfactory performance of his work.

CITY OF RIVERSIDE
PARK & RECREATION DEPARTMENT
DATE 10-7-97 BY

OCT 7 1997

GENERAL NOTES

1. All plans and elevation drawings have a scale of 1/2" = 1'0" unless otherwise noted on the drawings.
2. All counter tops have a 4" backsplash unless otherwise noted on the drawings.
3. All finished rubber base material is to be furnished by the General Contractor.
4. All backing inside walls for cabinet installation is by the General Contractor.
5. All adj. shelves up to 25" will be made of 3/4" ~~PARTICLE BD. W/~~ 3/4" PLYWOOD (BIRCH.)
   All adj. shelves between 25" & 34" will be made of 1" ~~PARTICLE BD. W/~~
   All adj. shelves over 34" will be made of ~~1" PARTICLE BD. W/ SUBLINER ON.~~
6. All cabinets will have the number of shelves shown on the drawings.
7. All tall cabinets with finished ends shall have the center shelf fixed per W.I.C. Section 15, Page 10, Paragraph IX-E-5.

NOTE:
- UNIVERSAL GRADE LAM. PL. FOR TOPS
- LUMBER CORE FOR DOORS
- BIRCH PLYWOOD FOR CAB. BOX

CAB.	WIC CUSTOM GRADE
TOP	WIC CUSTOM GRADE
MILL	N/A

W.I.C. LABELS REQ'D YES...✓.... NO.....

W.I.C. LABELS TO FOLLOW

DATE	REVISION
10/03/97	REVISED & RESUBMITTED

DRAWN BY: C.A. JOB No. 4562

PROJECT MGR: JOHN CANTU SHEET No. 1

DATE: 09/15/97 OF 5

JOB NAME/No. RENCK COMMUNITY CENTER #4562

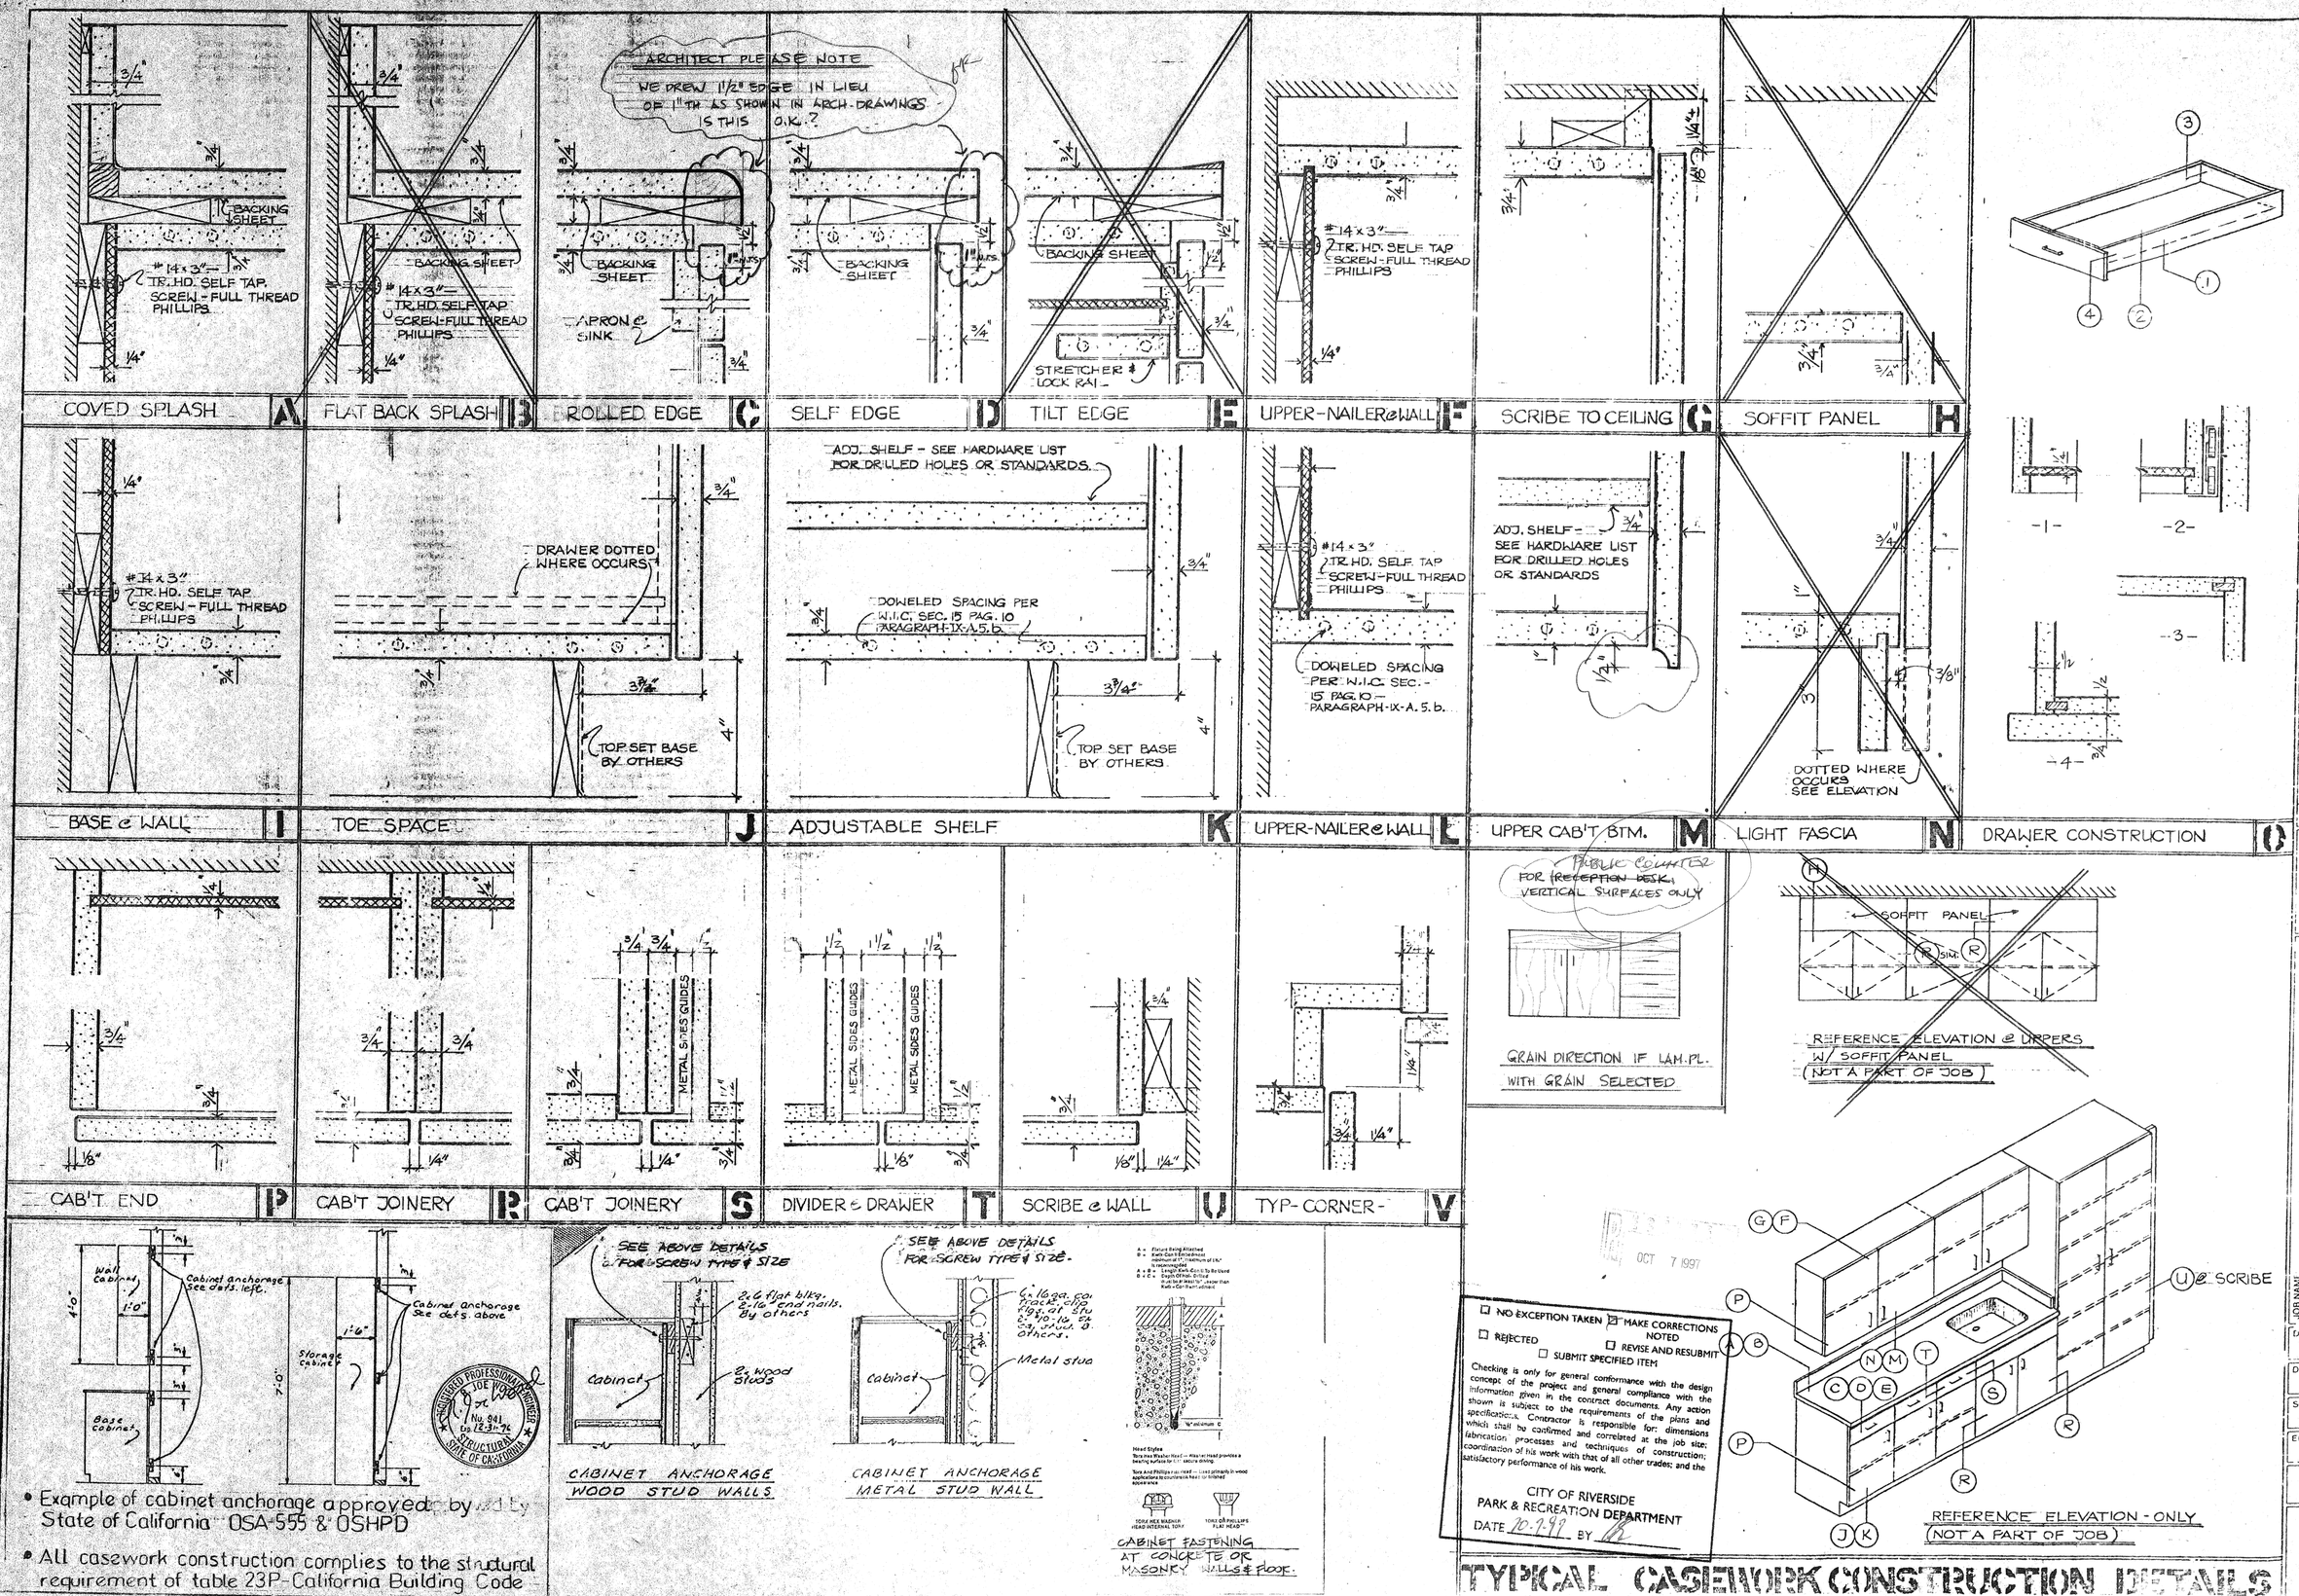

- Example of cabinet anchorage approved by State of California OSA-555 & OSHPD
- All casework construction complies to the structural requirement of table 23P-California Building Code

OCT 7 1997

☐ NO EXCEPTION TAKEN ☒ MAKE CORRECTIONS NOTED
☐ REJECTED ☐ REVISE AND RESUBMIT
☐ SUBMIT SPECIFIED ITEM

Checking is only for general conformance with the design concept of the project and general compliance with the information given in the contract documents. Any action shown is subject to the requirements of the plans and specifications. Contractor is responsible for: dimensions which shall be confirmed and correlated at the job site; fabrication processes and techniques of construction; coordination of his work with that of all other trades; and the satisfactory performance of his work.

CITY OF RIVERSIDE
PARK & RECREATION DEPARTMENT
DATE 10-7-97 BY

TYPICAL CASEWORK CONSTRUCTION DETAILS

K & Z Cabinet Co., Inc.
1450 So. Grove Ave.
Ontario, Calif. 91761
(714) 947-3567

REVISION | DATE | MEMBER

RENCK COMMUNITY CENTER

JOB NAME: | JOB ADDRESS: | CONTRACTOR: | ARCHITECT:

DRAWN BY: C.A.
DATE: 09/15/97
SCALE: HALF SIZE
ELEV:
JOB NO. 4562
SHEET NO. 2
OF

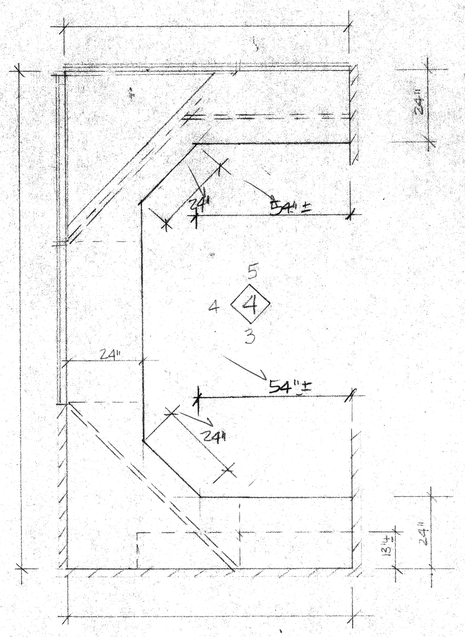

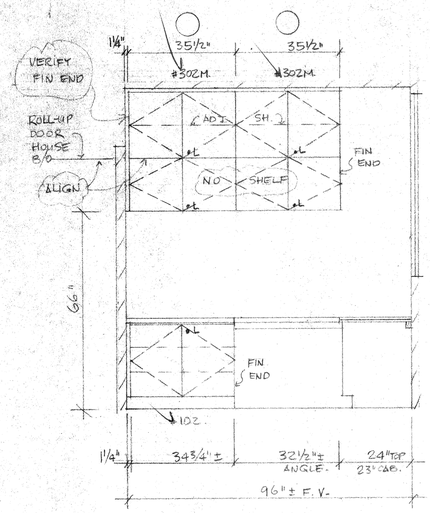

3 ELEVATION.
1/2" = 1'-0"

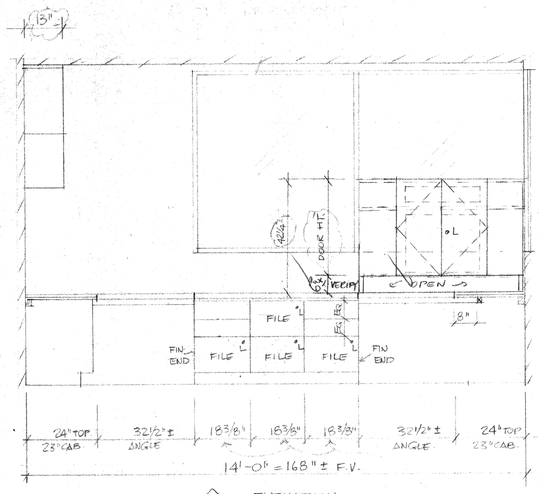

4 ELEVATION
1/2" = 1'-0"

VERIFY THE DRAWER SIZE

1 - ROOM CAB. @ WORK STATION.

CAB: PAINT GRADE PLYWOOD

TOP L/P.

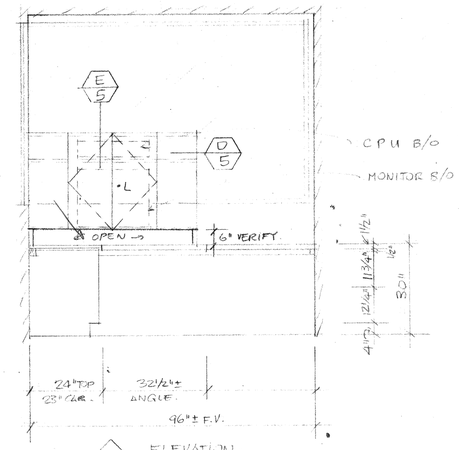

5 ELEVATION.
1/2" = 1'-0"

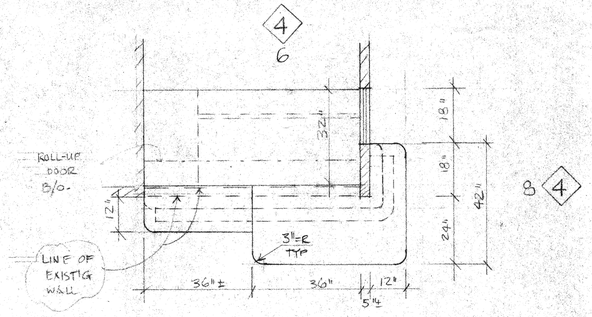

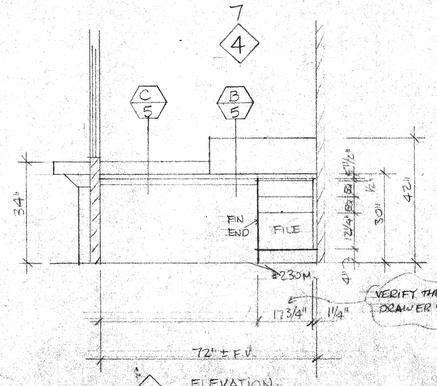

6 ELEVATION.
1/2" = 1'-0"

VERIFY THE DRAWER SIZE OK

1 - ELEV. OF CAB. @ RECEPTION

CAB: PAINT GR. PLYWOOD

TOP L/P:

LAM. PL WALL L/P:

PAINT B/O

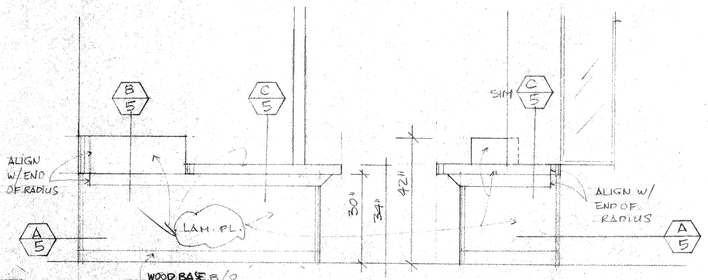

7 ELEVATION.
1/2" = 1'-0"

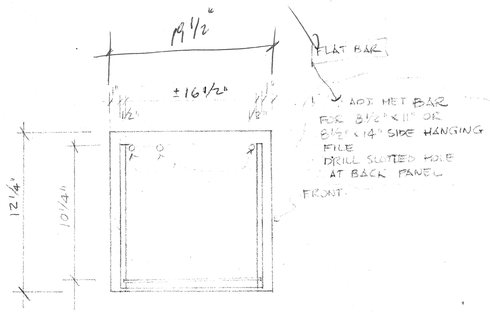

8 ELEVATION
1/2" = 1'-0"

FILE DRAWER

FOR THE WHOLE JOB.

☑ NO EXCEPTION TAKEN ☐ MAKE CORRECTIONS NOTED
☐ REJECTED ☐ REVISE AND RESUBMIT
☐ SUBMIT SPECIFIED ITEM

Checking is only for general conformance with the design concept of the project and general compliance with the information given in the contract documents. Any action shown is subject to the requirements of the plans and specifications. Contractor is responsible for: dimensions which shall be confirmed and correlated at the job site; fabrication processes and techniques of construction; coordination of his work with that of all other trades; and the satisfactory performance of his work.

CITY OF RIVERSIDE
PARK & RECREATION DEPARTMENT
DATE 10-7-97 BY

RECEIVED
OCT 7 1997

K & Z Cabinet Co., Inc.
1450 So. Grove Ave.
Ontario, Calif. 91761
(909) 947-3567
State Lic. # 319196 Fax No. (909) 947-3264

DATE	REVISION

MEMBER

JOB NAME: RENICK COMMUNITY CENTER
JOB ADDRESS:
CONTRACTOR:
ARCHITECT:

DRAWN BY: A.C.
DATE: 09/15/97
SCALE: AS NOTED
ELEV:
JOB NO. 4562
SHEET NO. 4
OF

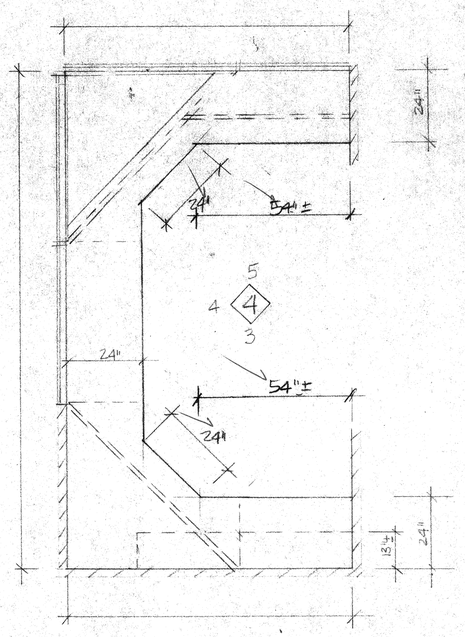

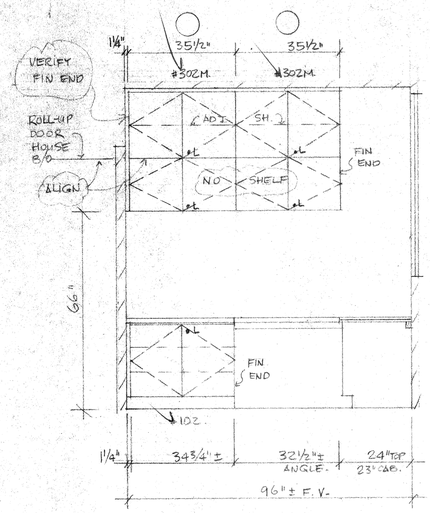

3 ELEVATION.
1/2" = 1'-0"

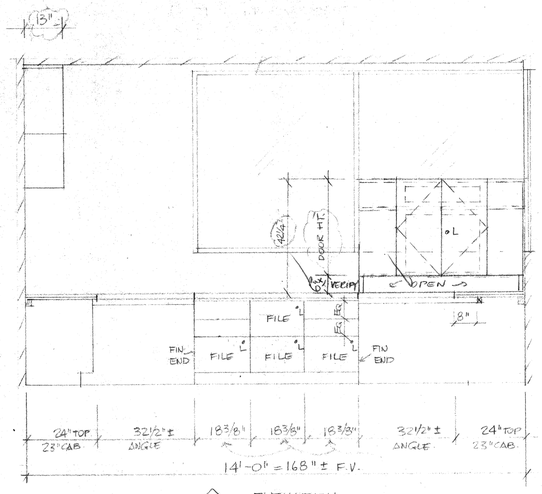

4 ELEVATION
1/2" = 1'-0"

VERIFY THE DRAWER SIZE

1 - ROOM CAB. @ WORK STATION.

CAB: PAINT GRADE PLYWOOD

TOP L/P.

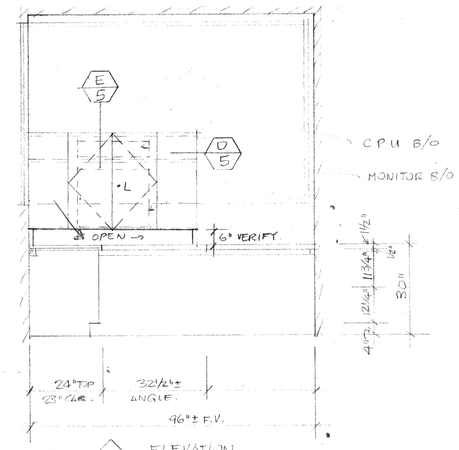

5 ELEVATION.
1/2" = 1'-0"

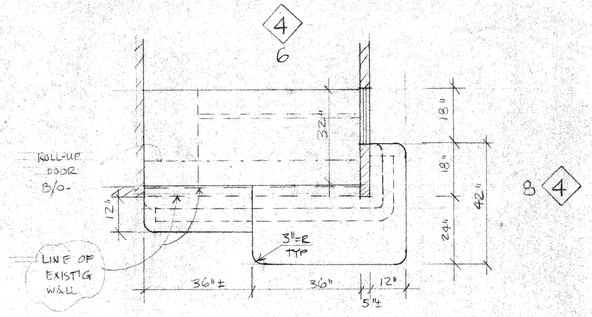

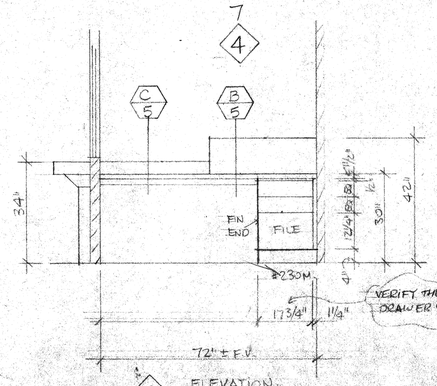

6 ELEVATION.
1/2" = 1'-0"

VERIFY THE DRAWER SIZE OK

1 - ELEV. OF CAB. @ RECEPTION

CAB: PAINT GR. PLYWOOD

TOP L/P:

LAM. PL WALL L/P:

PAINT B/O

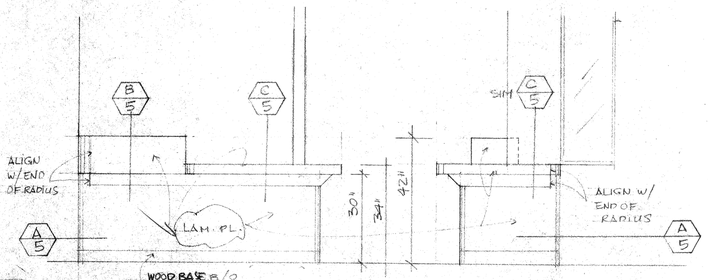

7 ELEVATION.
1/2" = 1'-0"

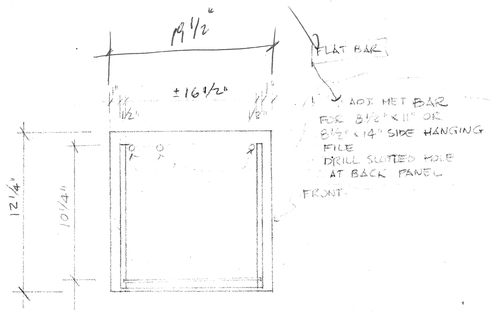

8 ELEVATION
1/2" = 1'-0"

FILE DRAWER

FOR THE WHOLE JOB.

☑ NO EXCEPTION TAKEN ☐ MAKE CORRECTIONS NOTED
☐ REJECTED ☐ REVISE AND RESUBMIT
☐ SUBMIT SPECIFIED ITEM

Checking is only for general conformance with the design concept of the project and general compliance with the information given in the contract documents. Any action shown is subject to the requirements of the plans and specifications. Contractor is responsible for: dimensions which shall be confirmed and correlated at the job site; fabrication processes and techniques of construction; coordination of his work with that of all other trades; and the satisfactory performance of his work.

CITY OF RIVERSIDE
PARK & RECREATION DEPARTMENT
DATE 10-7-97 BY

RECEIVED
OCT 7 1997

K & Z Cabinet Co., Inc.
1450 So. Grove Ave.
Ontario, Calif. 91761
(909) 947-3567
State Lic. # 319196 Fax No. (909) 947-3264

DATE	REVISION

MEMBER

JOB NAME: RENICK COMMUNITY CENTER
JOB ADDRESS:
CONTRACTOR:
ARCHITECT:

DRAWN BY: A.C.
DATE: 09/15/97
SCALE: AS NOTED
ELEV:
JOB NO. 4562
SHEET NO. 4
OF

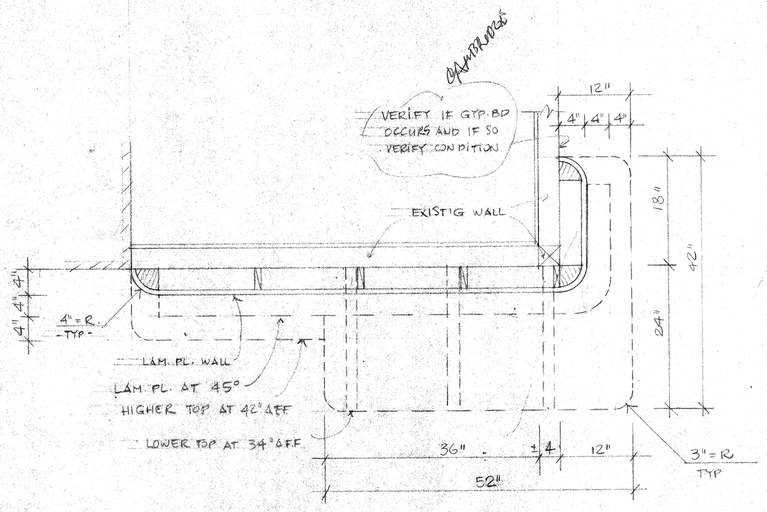

A 1" = 1'-0"

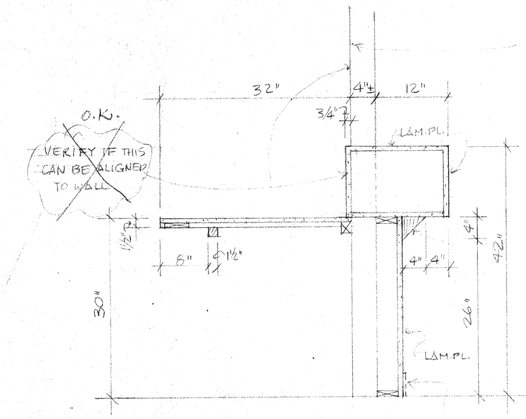

B 1" = 1'-0"

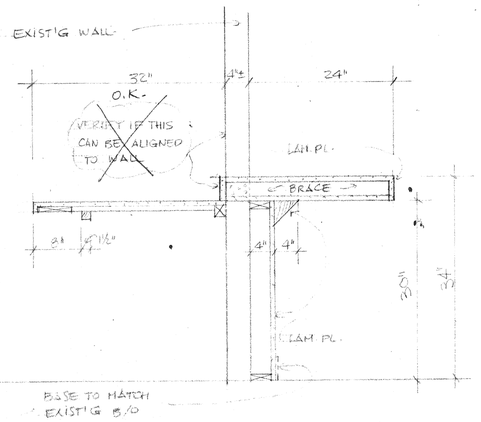

C 1" = 1'-0"

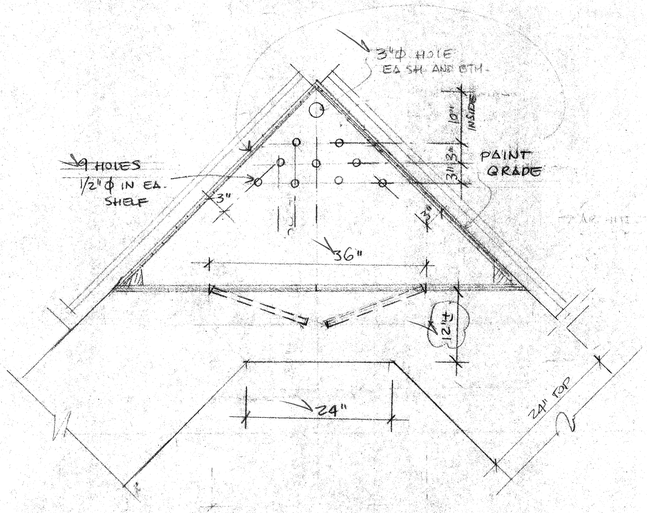

D 1" = 1'-0"

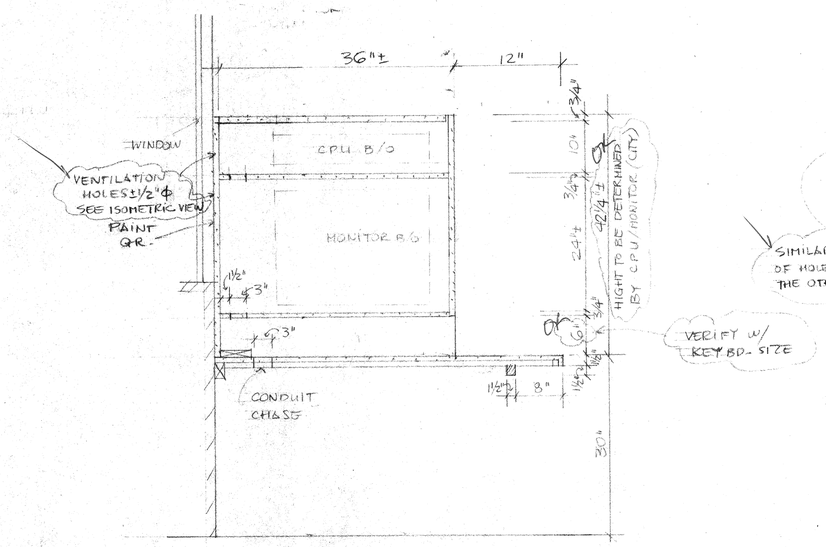

E 1" = 1'-0"

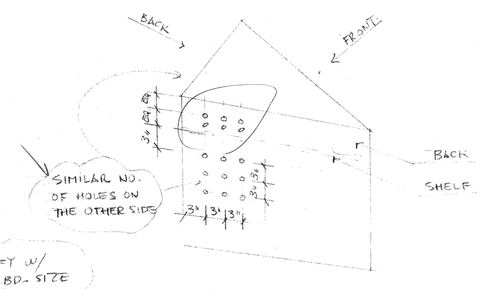

1/2"Φ HOLES FOR VENTILATION – ~~3~~ + 9
6

☐ NO EXCEPTION TAKEN ☑ MAKE CORRECTIONS NOTED
☐ REJECTED ☐ REVISE AND RESUBMIT
☐ SUBMIT SPECIFIED ITEM

Checking is only for general conformance with the design concept of the project and general compliance with the information given in the contract documents. Any action shown is subject to the requirements of the plans and specifications. Contractor is responsible for: dimensions which shall be confirmed and correlated at the job site; fabrication processes and techniques of construction; coordination of his work with that of all other trades; and the satisfactory performance of his work.

CITY OF RIVERSIDE
PARK & RECREATION DEPARTMENT
DATE 10-7-97 BY [illegible]

RECEIVED
OCT 7 1997
PARK & RECREATION DEPARTMENT

K & Z Cabinet Co., Inc.
1450 So. Grove Ave.
Ontario, Calif. 91761
(909) 947-3567
State Lic. # 319196 Fax No. (909) 947-3264

DATE	REVISION
10/03/97	REVISED & RESUBMITTED

MEMBER

JOB NAME: RENCK COMMUNITY CENTER
JOB ADDRESS:
CONTRACTOR:
ARCHITECT:

DRAWN BY: C.A.
DATE: 09/15/97
SCALE: AS NOTED
ELEV:
JOB NO. #4562
SHEET NO. 5
OF