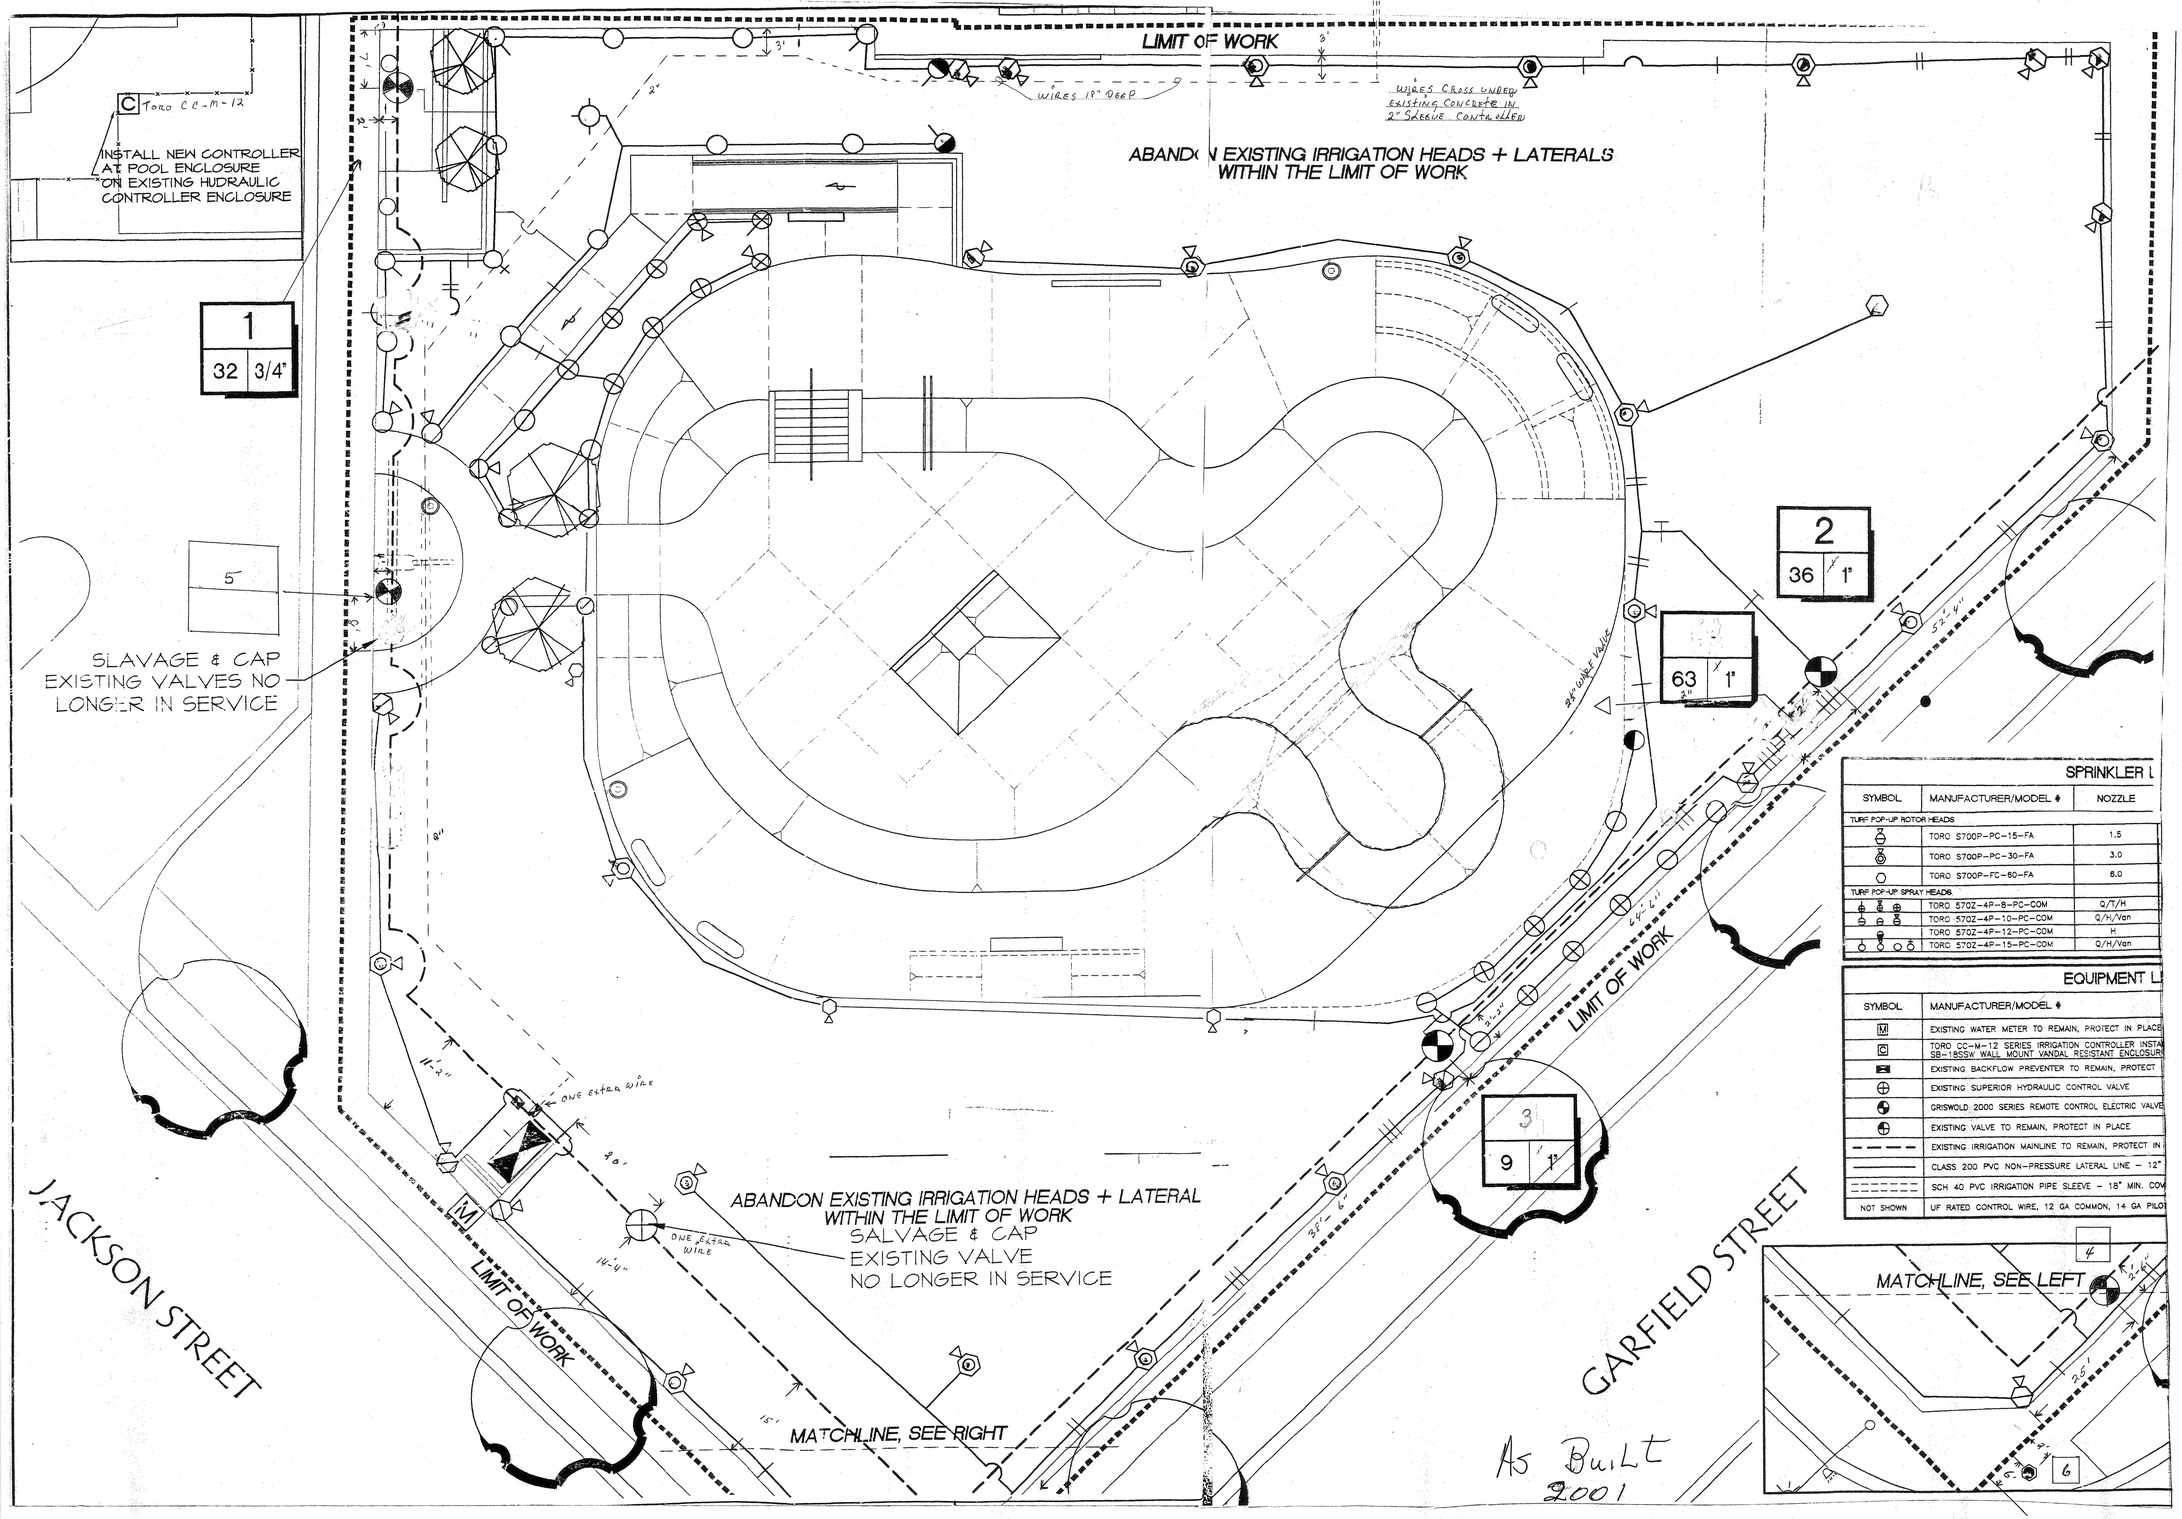

SPRINKLER L		
SYMBOL	MANUFACTURER/MODEL #	NOZZLE
TURF POP-UP ROTOR HEADS		
	TORO S700P-PC-15-FA	1.5
	TORO S700P-PC-30-FA	3.0
	TORO S700P-FC-60-FA	6.0
TURF POP-UP SPRAY HEADS		
	TORO 570Z-4P-8-PC-COM	Q/T/H
	TORO 570Z-4P-10-PC-COM	Q/H/Van
	TORO 570Z-4P-12-PC-COM	H
	TORO 570Z-4P-15-PC-COM	Q/H/Van

EQUIPMENT L	
SYMBOL	MANUFACTURER/MODEL #
M	EXISTING WATER METER TO REMAIN, PROTECT IN PLACE
C	TORO CC-M-12 SERIES IRRIGATION CONTROLLER INSTA SB-18SSW WALL MOUNT VANDAL RESISTANT ENCLOSUR
	EXISTING BACKFLOW PREVENTER TO REMAIN, PROTECT
	EXISTING SUPERIOR HYDRAULIC CONTROL VALVE
	GRISWOLD 2000 SERIES REMOTE CONTROL ELECTRIC VALVE
	EXISTING VALVE TO REMAIN, PROTECT IN PLACE
	EXISTING IRRIGATION MAINLINE TO REMAIN, PROTECT IN
	CLASS 200 PVC NON-PRESSURE LATERAL LINE - 12"
	SCH 40 PVC IRRIGATION PIPE SLEEVE - 18" MIN. COV
NOT SHOWN	UF RATED CONTROL WIRE, 12 GA COMMON, 14 GA PILO

As Built 2001

DRAWING NUMBER Hunt
PLAN HOLD CORPORATION • IRVINE, CALIFORNIA
REORDER BY NUMBER 075AR

DRAWING NUMBER SKATE
PLAN HOLD CORPORATION • IRVINE, CALIFORNIA
REORDER BY NUMBER 075AR

DRAWING NUMBER
PLAN HOLD CORPORATION • IRVINE, CALIFORNIA
REORDER BY NUMBER 075AR
POSITION EDGE OF PRINT ON THIS LINE

UMBER
• IRVINE, CALIFORNIA
BER 075AR