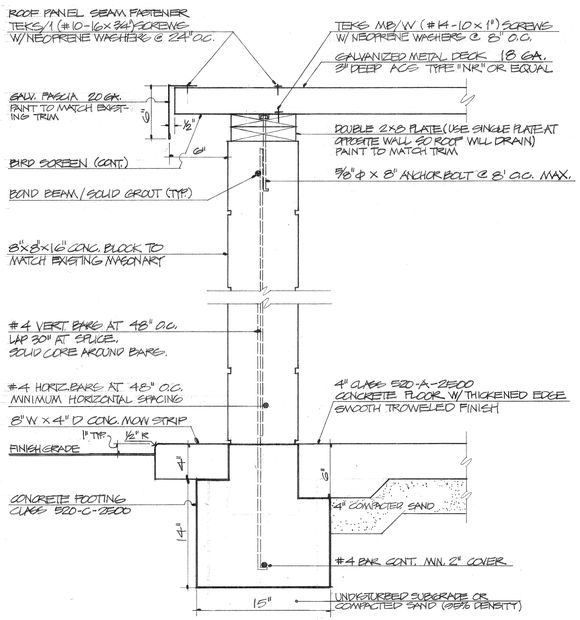

SECTION Ⓐ SCALE: 1½" = 1'-0"

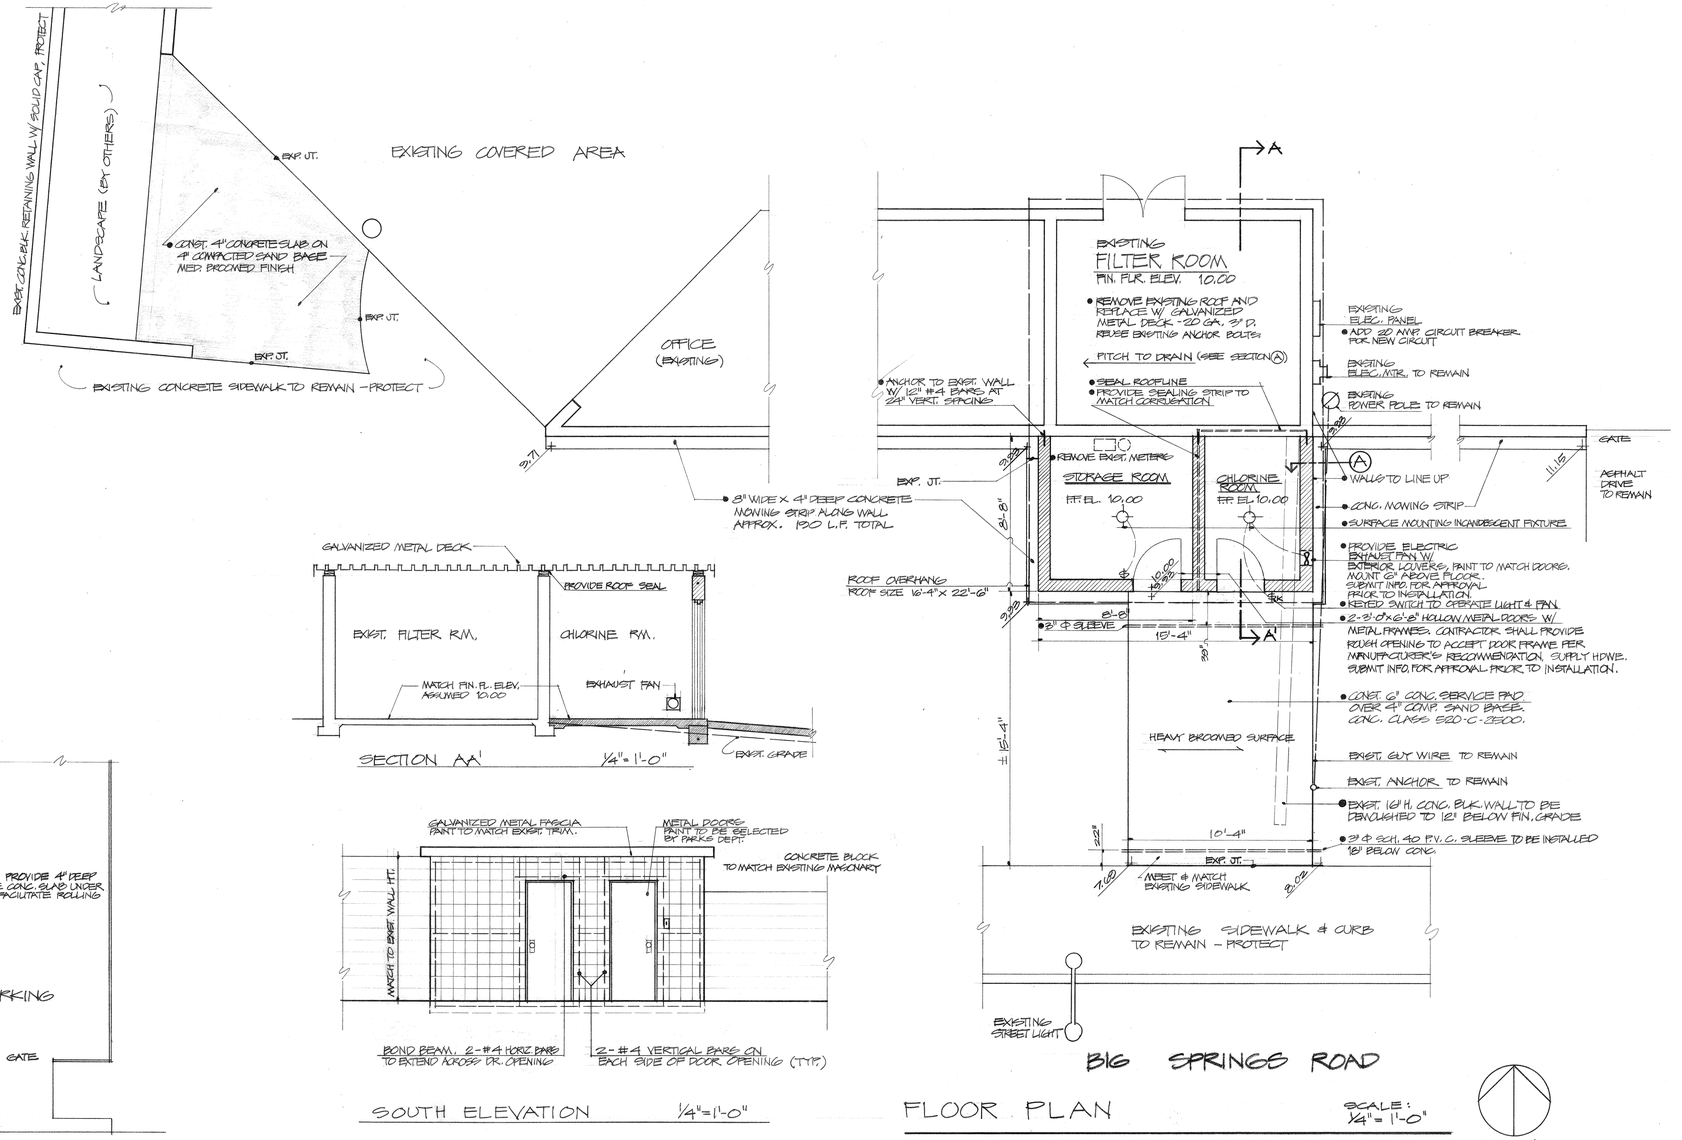

FLOOR PLAN SCALE: ¼" = 1'-0"

SECTION AA' ¼" = 1'-0"

SOUTH ELEVATION ¼"=1'-0"

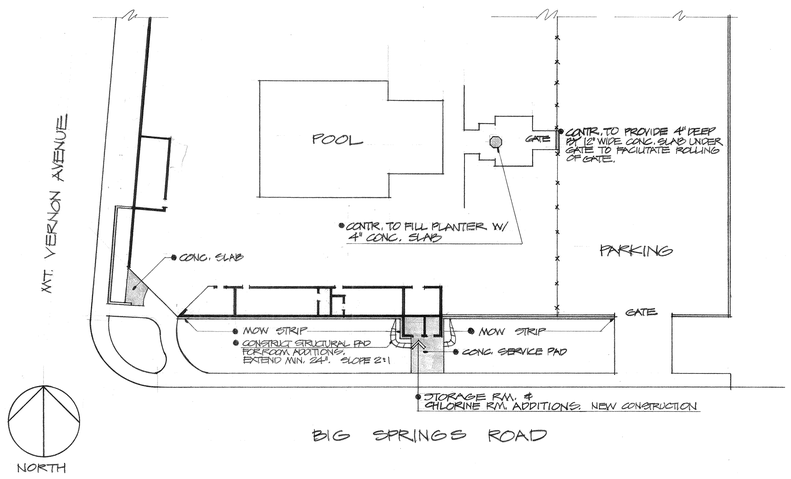

SITE PLAN SCALE 1" = 30'

C - 24 - 601

AS BUILT DRWG. 7/2/81

CONCRETE WORK & ROOM ADDITIONS

ISLANDER POOL

CITY OF RIVERSIDE, CALIFORNIA
DEPARTMENT OF PARKS & RECREATION

ACCT. NO.	441
DATE	3/31/81
DESIGNED BY	EWECTT
DRAWN BY	EWECTT
CHECKED BY	
SHEET NUMBER	1 OF 1
DRAWING NUMBER	P-123-3