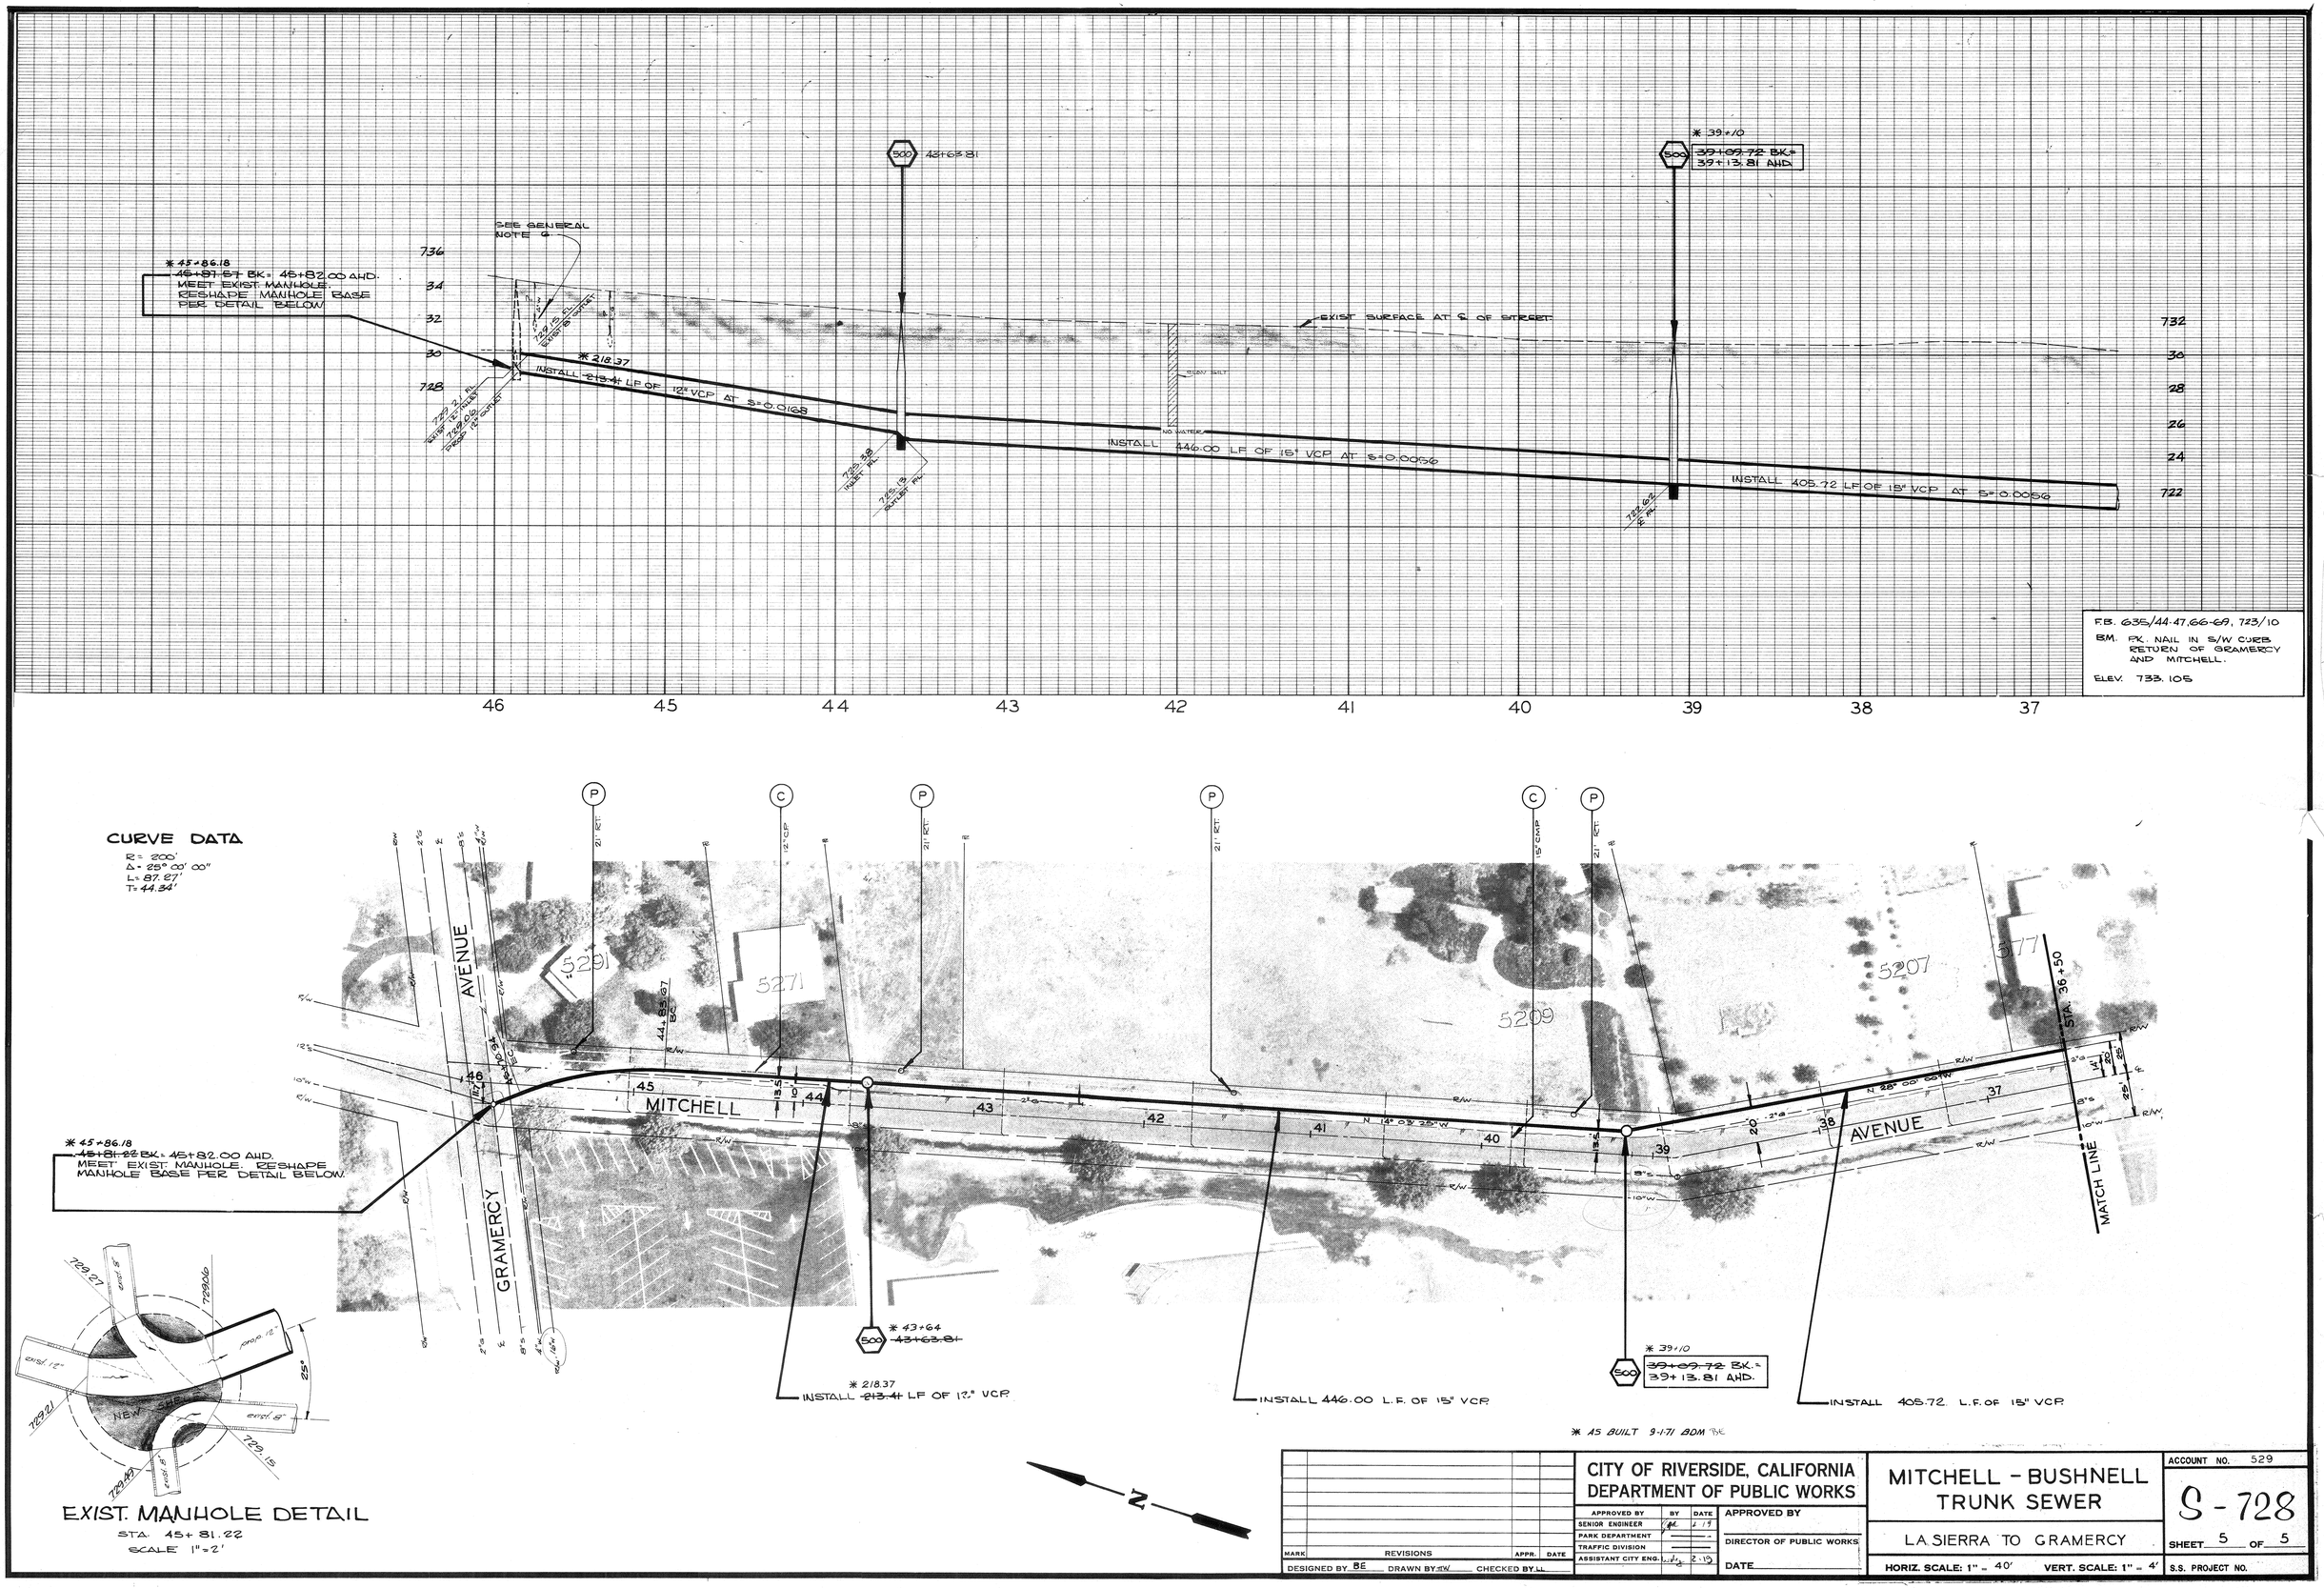

MARK	REVISIONS	APPR.	DATE

DESIGNED BY BE DRAWN BY TW CHECKED BY LL

CITY OF RIVERSIDE, CALIFORNIA
DEPARTMENT OF PUBLIC WORKS

APPROVED BY	BY	DATE
SENIOR ENGINEER	[illegible]	2-19
PARK DEPARTMENT		
TRAFFIC DIVISION		
ASSISTANT CITY ENG.	[illegible]	2-19

APPROVED BY

DIRECTOR OF PUBLIC WORKS

DATE

MITCHELL - BUSHNELL
TRUNK SEWER

LA SIERRA TO GRAMERCY

HORIZ. SCALE: 1" = 40' VERT. SCALE: 1" = 4'

ACCOUNT NO. 529

S - 728

SHEET 5 OF 5

S.S. PROJECT NO.