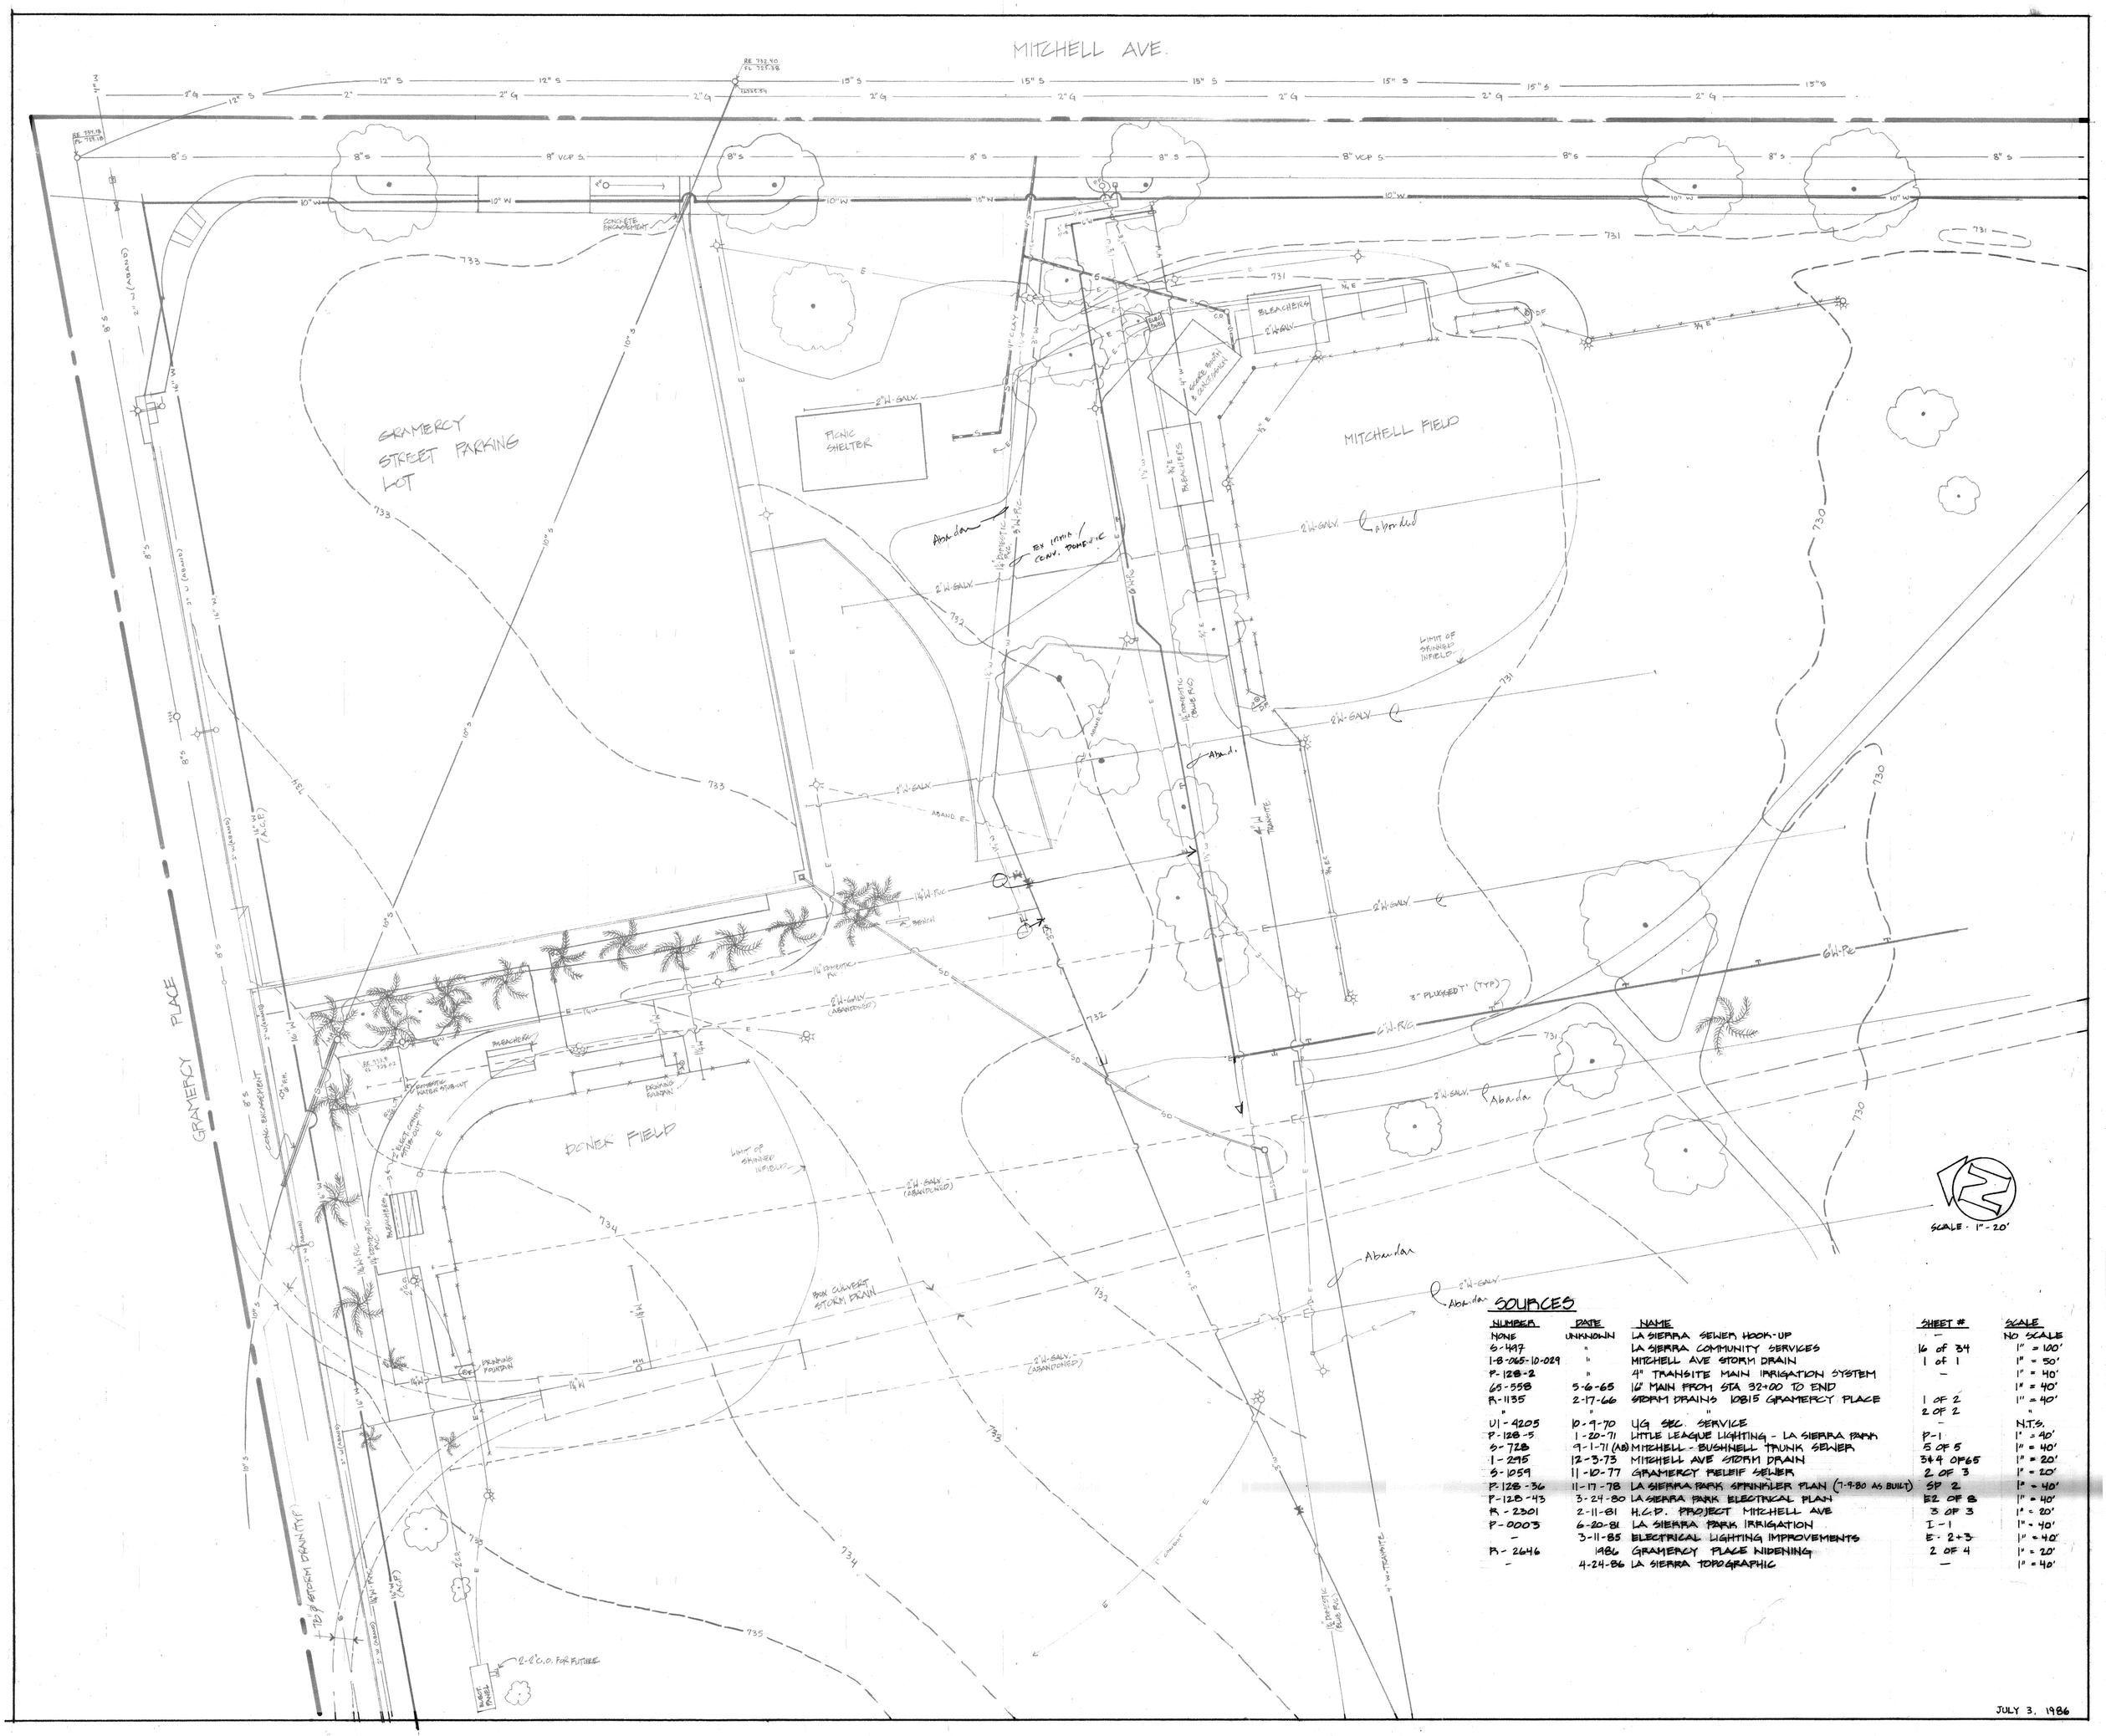

SOURCES

NUMBER	DATE	NAME	SHEET #	SCALE
NONE	UNKNOWN	LA SIERRA SEWER HOOK-UP	—	NO SCALE
S-497	"	LA SIERRA COMMUNITY SERVICES	16 of 34	1" = 100'
1-8-065-10-029	"	MITCHELL AVE STORM DRAIN	1 of 1	1" = 50'
P-128-2	"	4" TRANSITE MAIN IRRIGATION SYSTEM	—	1" = 40'
65-558	5-6-65	16" MAIN FROM STA 32+00 TO END		1" = 40'
R-1135	2-17-66	STORM DRAINS 10815 GRAMERCY PLACE	1 OF 2	1" = 40'
"	"	"	2 OF 2	"
U1-4205	10-9-70	UG SEC. SERVICE	—	N.T.S.
P-128-5	1-20-71	LITTLE LEAGUE LIGHTING - LA SIERRA PARK	P-1	1" = 40'
S-728	9-1-71 (AB)	MITCHELL - BUSHNELL TRUNK SEWER	5 OF 5	1" = 40'
1-295	12-3-73	MITCHELL AVE STORM DRAIN	3 & 4 OF 65	1" = 20'
S-1059	11-10-77	GRAMERCY RELEIF SEWER	2 OF 3	1" = 20'
P-128-36	11-17-78	LA SIERRA PARK SPRINKLER PLAN (7-9-80 AS BUILT)	SP 2	1" = 40'
P-128-43	3-24-80	LA SIERRA PARK ELECTRICAL PLAN	E2 OF 8	1" = 40'
R-2301	2-11-81	H.C.D. PROJECT MITCHELL AVE	3 OF 3	1" = 20'
P-0003	6-20-81	LA SIERRA PARK IRRIGATION	I-1	1" = 40'
—	3-11-85	ELECTRICAL LIGHTING IMPROVEMENTS	E-2+3	1" = 40'
R-2646	1986	GRAMERCY PLACE WIDENING	2 OF 4	1" = 20'
—	4-24-86	LA SIERRA TOPOGRAPHIC	—	1" = 40'

JULY 3, 1986