CONTRACTOR
LIQUID FLOW ENGINEERING, INC
21633 CEZANNE PLACE
WOODLAND HILLS, CA
91364
818/704-1835

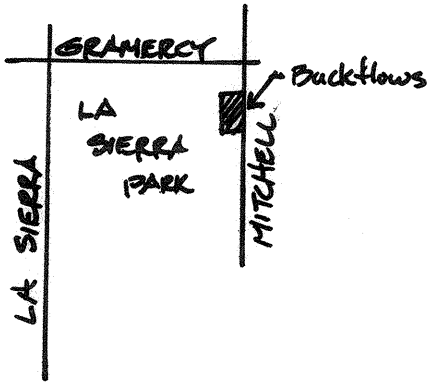

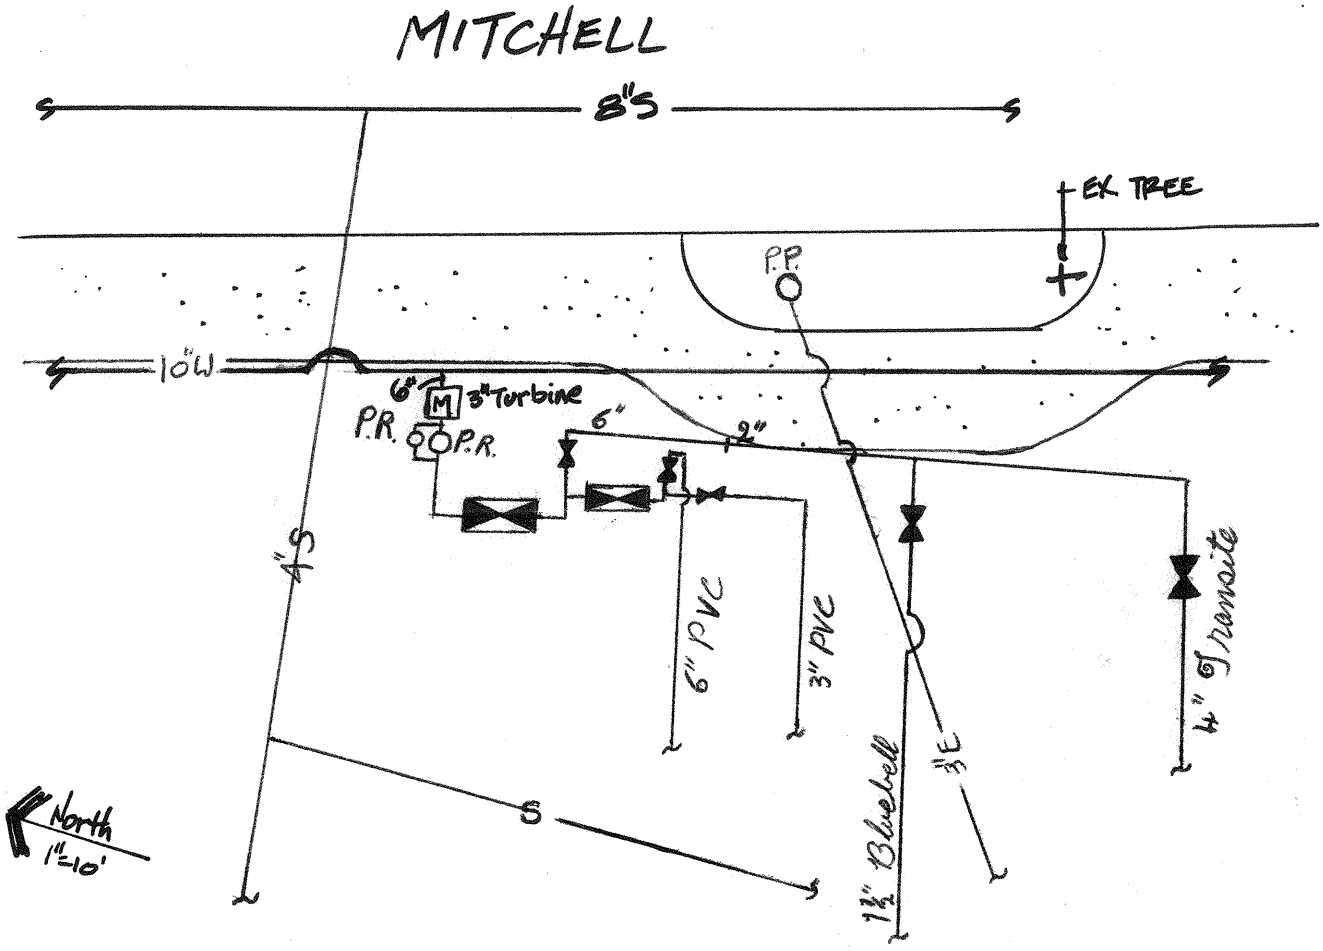

"AS-BUILT"

11/15/88