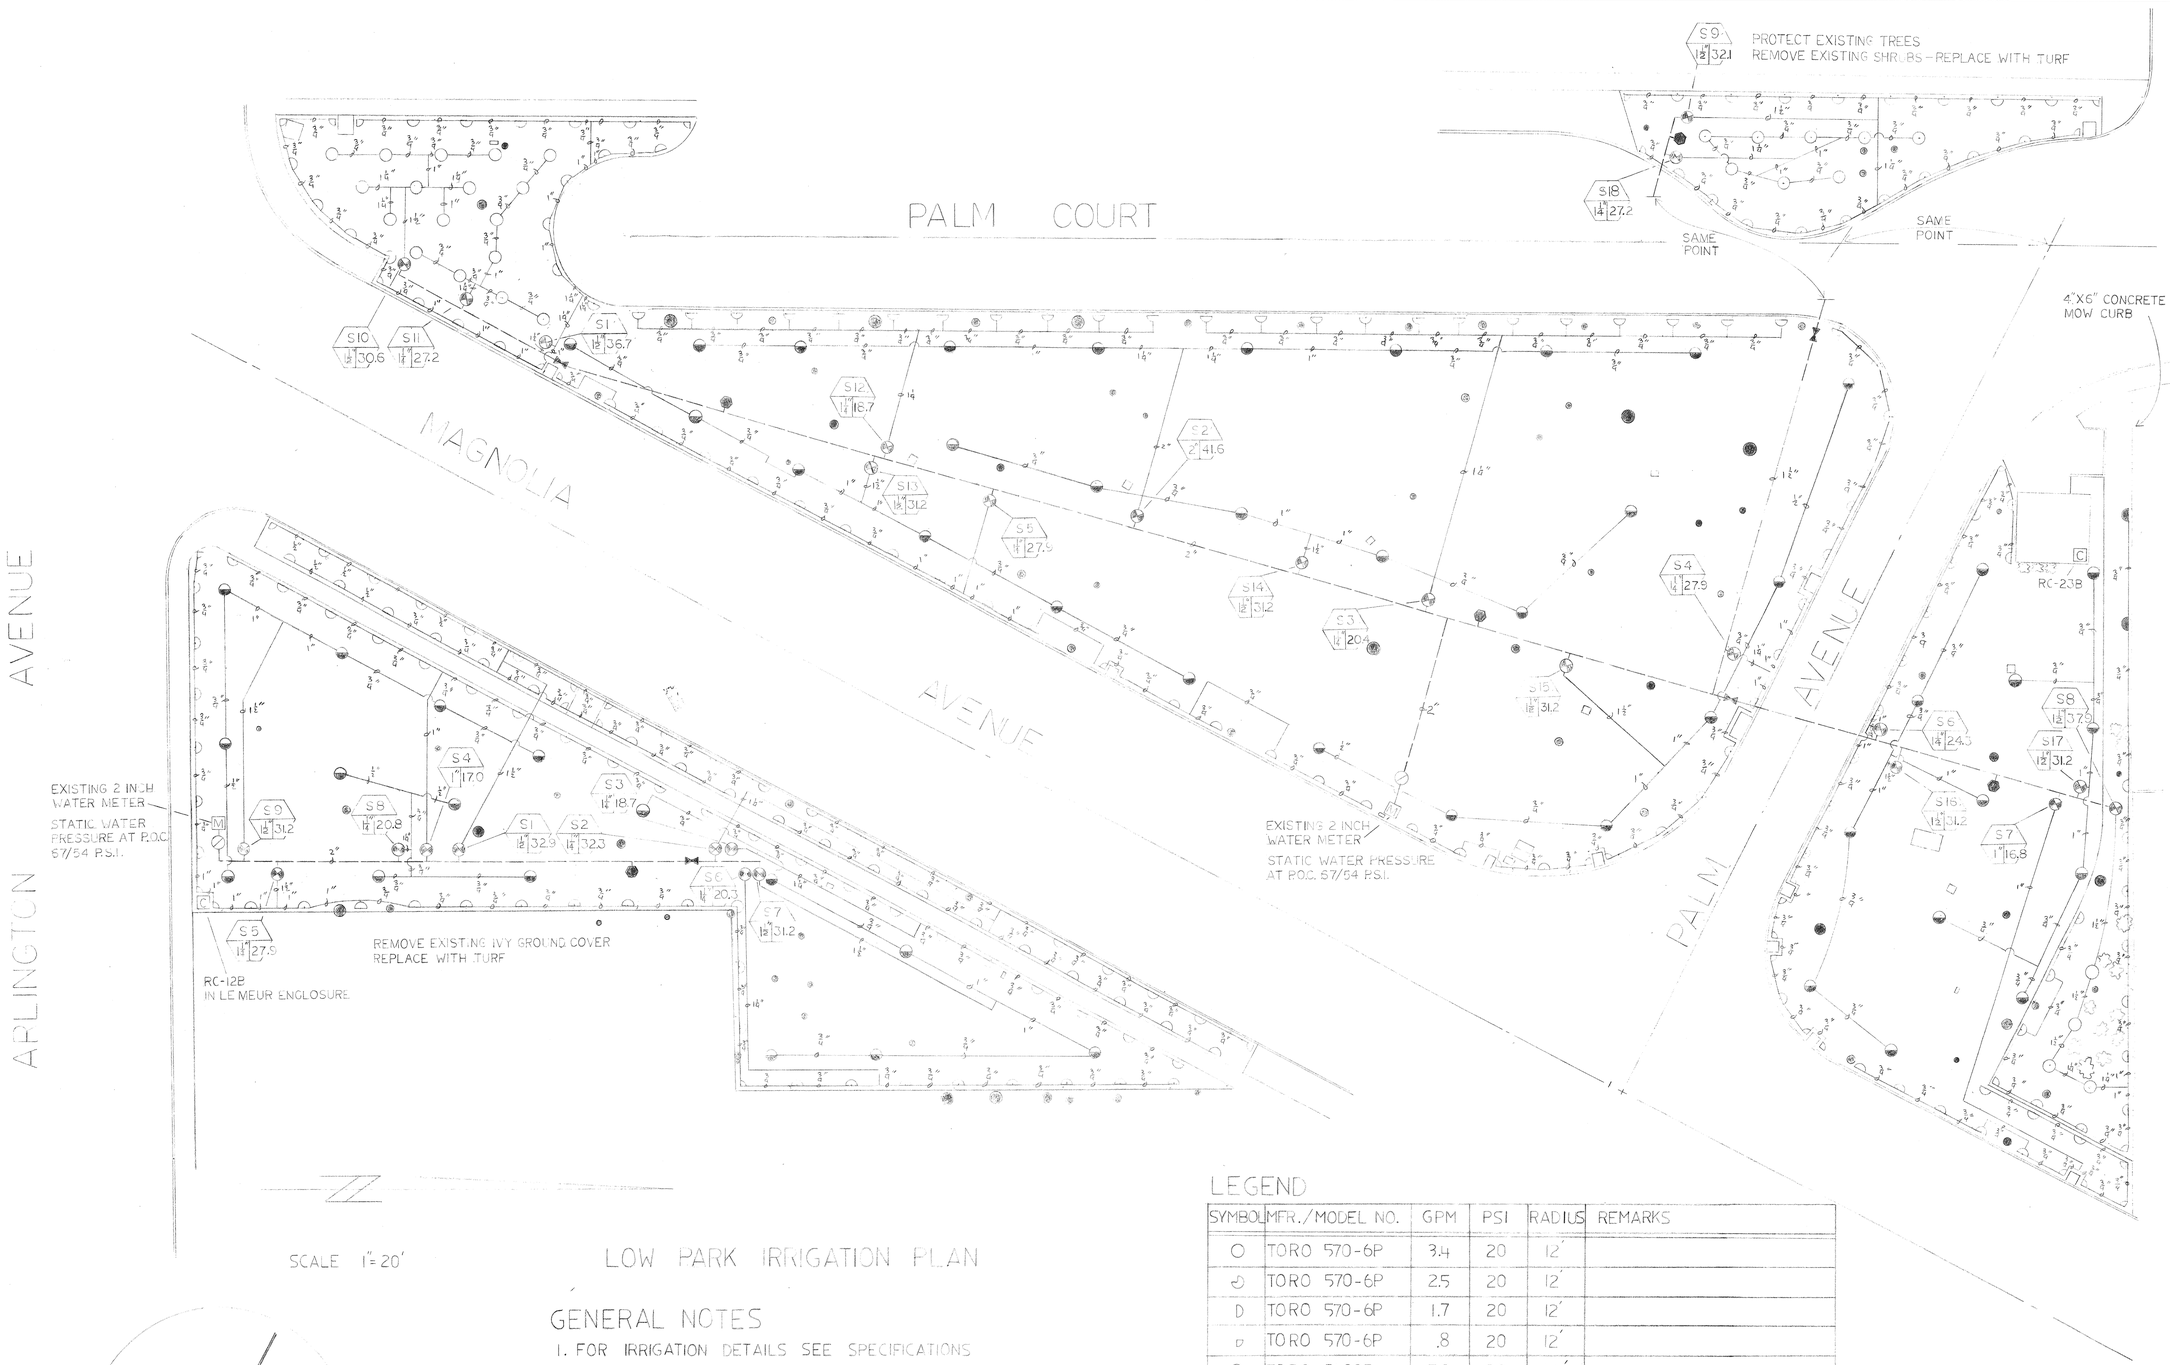

SCALE 1" = 20'

LOW PARK IRRIGATION PLAN

GENERAL NOTES

1. FOR IRRIGATION DETAILS SEE SPECIFICATIONS
2. ALL IRRIGATION LINES AND WIRING UNDER PAVEMENT TO BE SEPARATELY SLEEVED WITH 4 INCH DIAMETER SCHEDULE 40 PVC PIPE

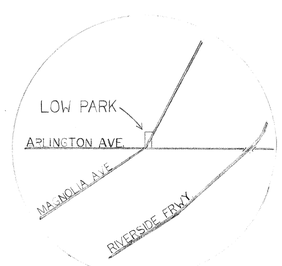

NO SCALE

VALVE SIZE — STATION — GPM DEMAND

APPROVALS

Dee Bachman-Hill PARK AND RECREATION DIRECTOR	8/6/86 DATE
Terry Nielsen PARK SUPERINTENDANT	8/6/86 DATE
Robert Johnson-Hill PARK PROJECTS COORDINATOR	8/6/86 DATE

LEGEND

SYMBOL	MFR./MODEL NO.	GPM	PSI	RADIUS	REMARKS
	TORO 570-6P	3.4	20	12'	
	TORO 570-6P	2.5	20	12'	
	TORO 570-6P	1.7	20	12'	
	TORO 570-6P	.8	20	12'	
	TORO S600S	5.2	30	42'	
	TORO SB-180	.28	1.1	1'	
	RAINBIRD EFA	BRASS RCV. W/BROOKS CONC. VB-NONHINGED LKG. LID			
	NIBCO 200 LB. CL.	BRASS BODY RISING STEM GATE VALVE-LINE SIZE			
	FEBCO 765-2"	PRESSURE TYPE VACUUM BREAKER			
	RAINBIRD 33D-¾	QUICK COUPLER-LOCKING TYPE			
——	CLASS 200 PVC LATERAL LINES SIZES NOTED-12" TO 16" COVER				
— —	CLASS 315 PVC PRESSURE LINES SIZES NOTED-18" TO 24" COVER				
C	RAINBIRD AUTOMATIC CONTROLLER IN LE MEUR ENCLOSURE WHERE NOTED.				
	LOCATION OF EXISTING TREES				

LOW PARK

IRRIGATION PLAN.

city of riverside
park & recreation
department
(714) 787-7923
3900 MAIN ST RIVERSIDE, CALIFORNIA 92522

revisions	by

date	7-7-86
design	
drawn	
check	
acc't. no.	51-532-492

SHEET 1 of 1

DRAWING NUMBER
LO-08

PLAN HOLD CORPORATION • IRVINE, CALIFORNIA
REORDER BY NUMBER 07SAR

DRAWING NUMBER

PLAN HOLD CORPORATION • IRVINE, CALIFORNIA
REORDER BY NUMBER 07SAR

DRAWING NUMBER

PLAN HOLD CORPORATION • IRVINE, CALIFORNIA
REORDER BY NUMBER 07SAR

IRRIGATION PLAN
WEST PORTION
LOW PARK

CITY OF RIVERSIDE - PARK & RECREATION DEPT.

SCALE - 1" = 20'

3-22-61

SYMBOL	QUAN.	DESCRIPTION
X	112	WEATHER-MATIC #43-024 F - SPK HD.
V	46	" " #43-024 H " "
O	18	CONTROL VALVE - AQUA-DIAL
—·—	-	EXISTING GALV. MAIN
—··—	250'	2" GALV. PIPE - SCH. 40
———	-	PVC SCH. 40
■	1	AQUA-DIAL # 523 CONTROLLER (23 STA)
▼	6	WEATHER-MATIC # 73-618 H
◇	22	" " # 33-520 H
Q	5	RAINBIRD TURF VALVES - RUBBER COV. #33-RC

NOTE:
SUBJECT TO PARK DEPT. APPROVAL, HEADS SHALL BE ALTERED FOR COMPLETE COVERAGE WHERE CONDITIONS DICTATE CHANGES. (TREES, SHRUBS, ETC.)

AS BUILT PLAN MUST BE CORRECTED AS JOB PROGRESSES

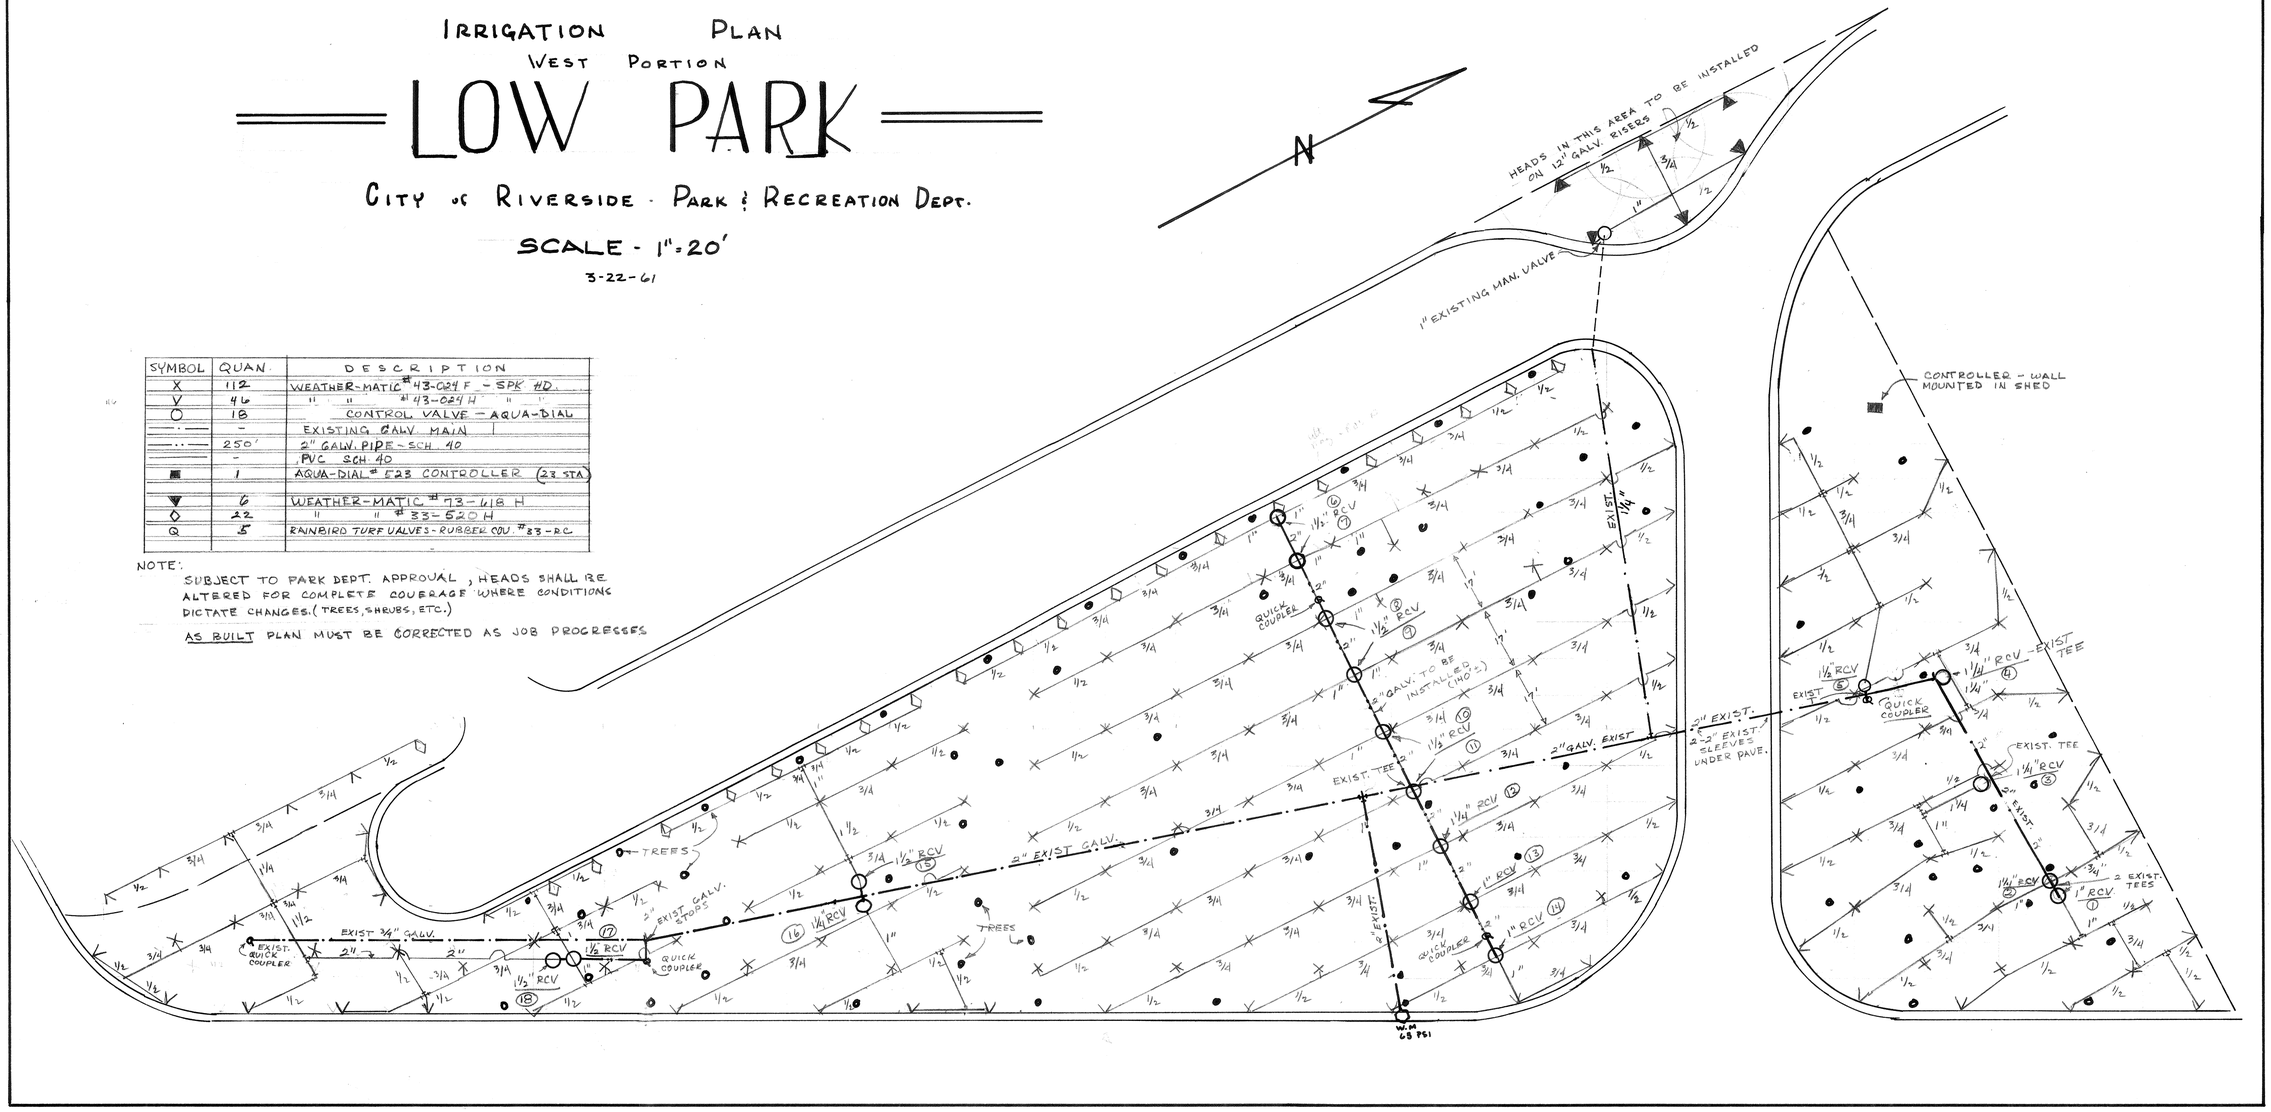

P-131-7

SYMBOL	SIZE	QUAN.	DESCRIPTION
X	15' R	18	WEATHER-MATIC # 43-024 F 5.7 G.P.M
V	15' R	25	" " # 43-024 H - 3.7 GPM
▽	10' R	21	" " # 13-516 H - STD. HEAD
▼	10' R	2	" " 13-516 Q "
●	1¼"	6	REMOTE CONTROL VALVE
▬	6 STA.	1	" " CONTROLLER (NEPTUNE) WITH 8 DAY SPRING WOUND CLOCK
◇	2"	1	2" CHECK VALVE } MOIST-O-MATIC
◆	2"	1	2" GATE VALVE } MOIST-O-MATIC
M	1"	1	METER
Q	¾"	3	RAINBIRD SURE QUICK TURF VALVES - RUBBER COV. #33-RC
T	2"	2	T'S - PLUGGED

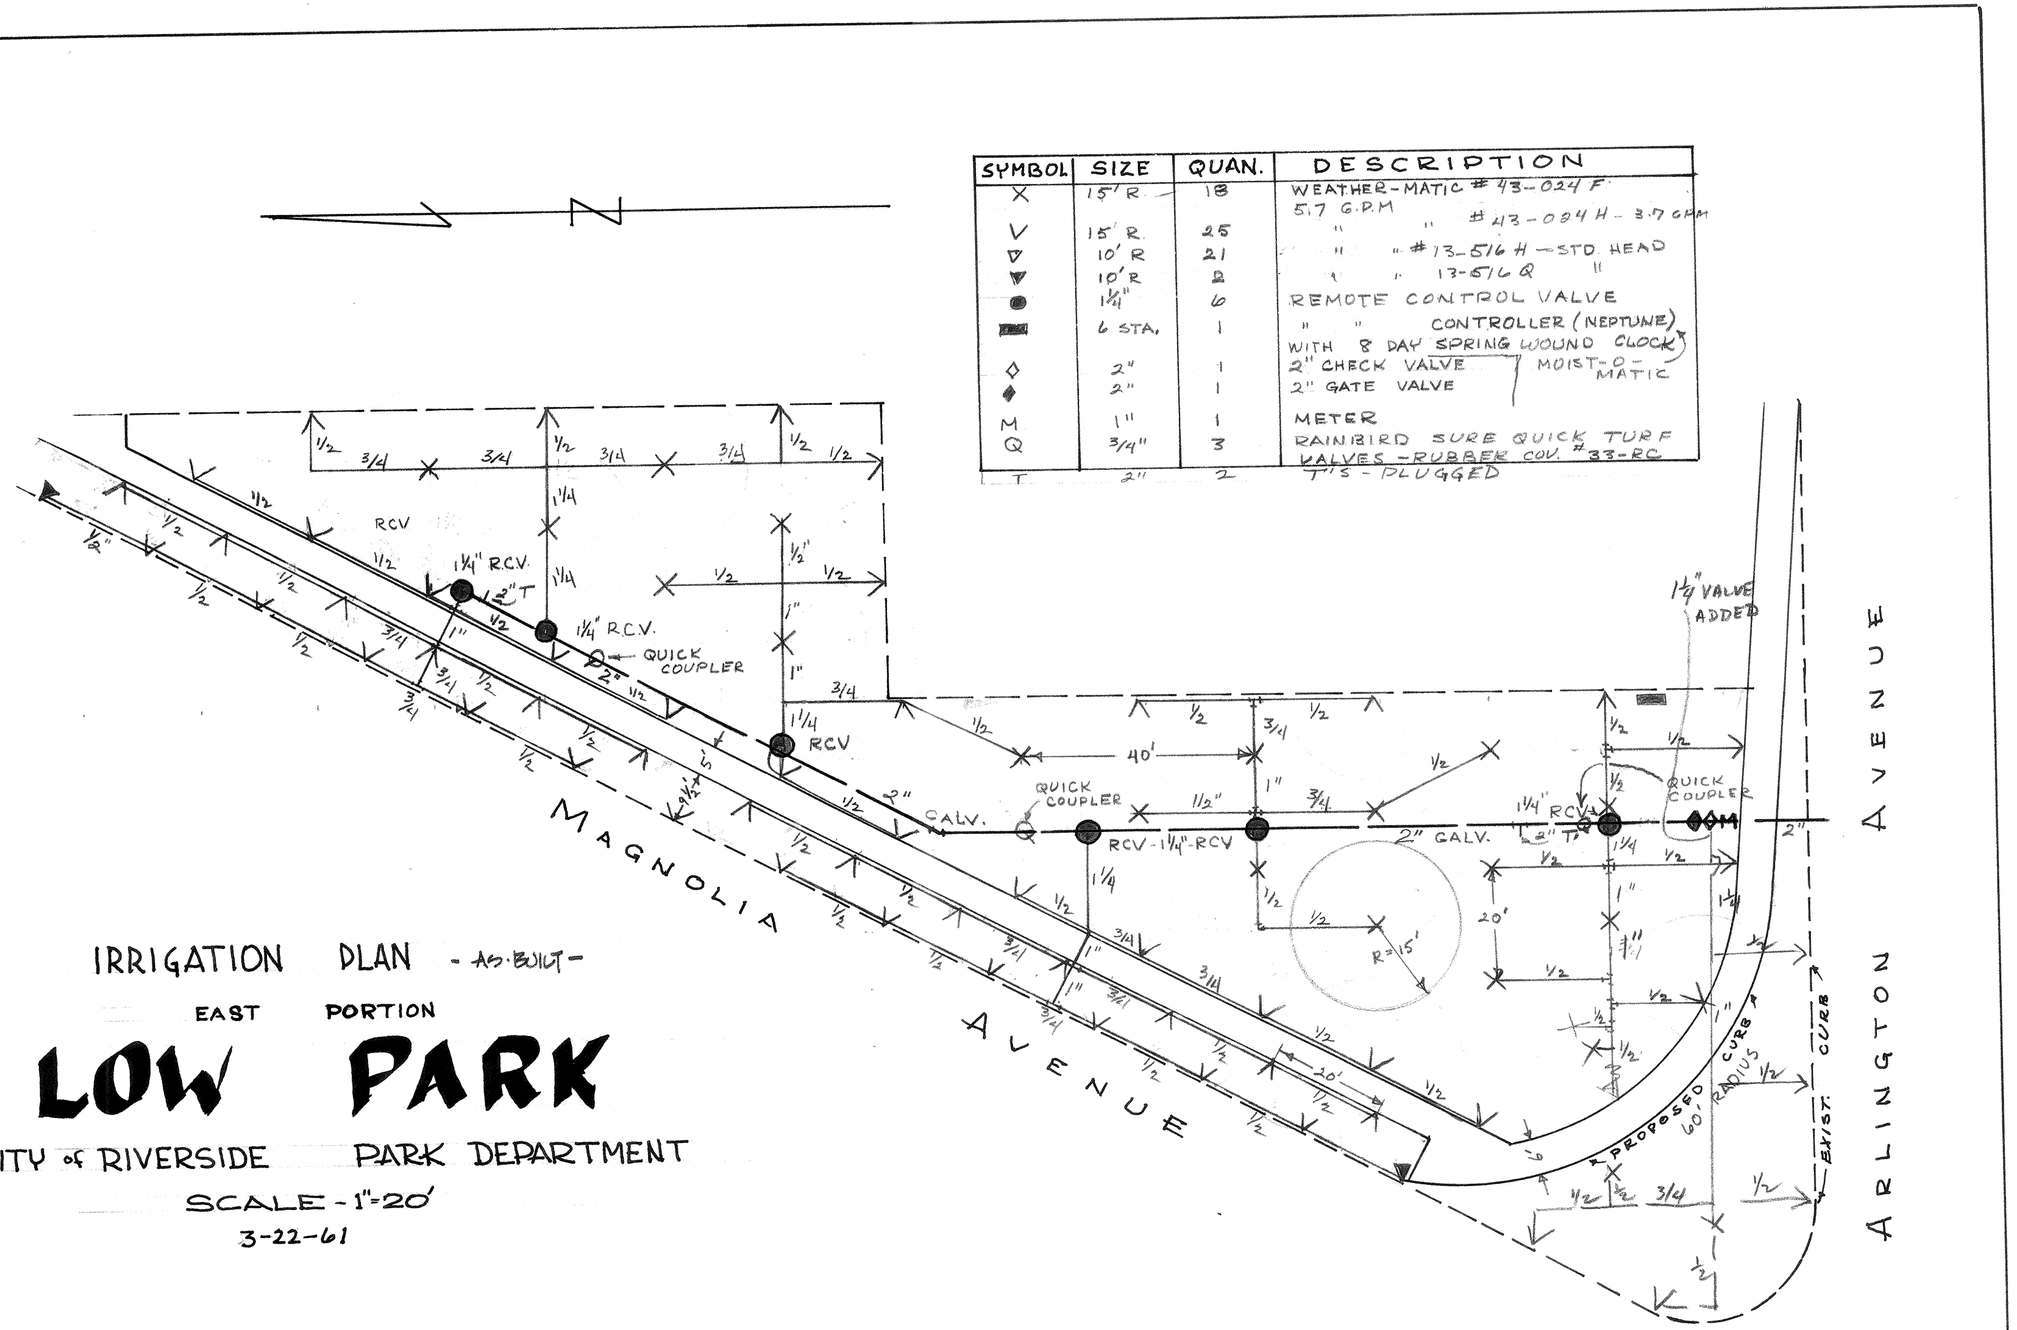

IRRIGATION PLAN - AS-BUILT -

EAST PORTION

LOW PARK

CITY of RIVERSIDE PARK DEPARTMENT

SCALE - 1"=20'

3-22-61

DRAWING NUMBER 10-01

DRAWING NUMBER

DRAWING NUMBER 003

PLAN HOLD CORPORATION • IRVINE, CALIFORNIA
REORDER BY NUMBER 075AR

P-131-4

DRAWING NUMBER

LO10

PLAN HOLD CORPORATION • IRVINE, CALIFORNIA

REORDER BY NUMBER 075AR

DRAWING NUMBER

LO-09

PLAN HOLD CORPORATION • IRVINE, CALIFORNIA

REORDER BY NUMBER 075AR

DRAWI

PLAN HOLD CORPOR

REORDER

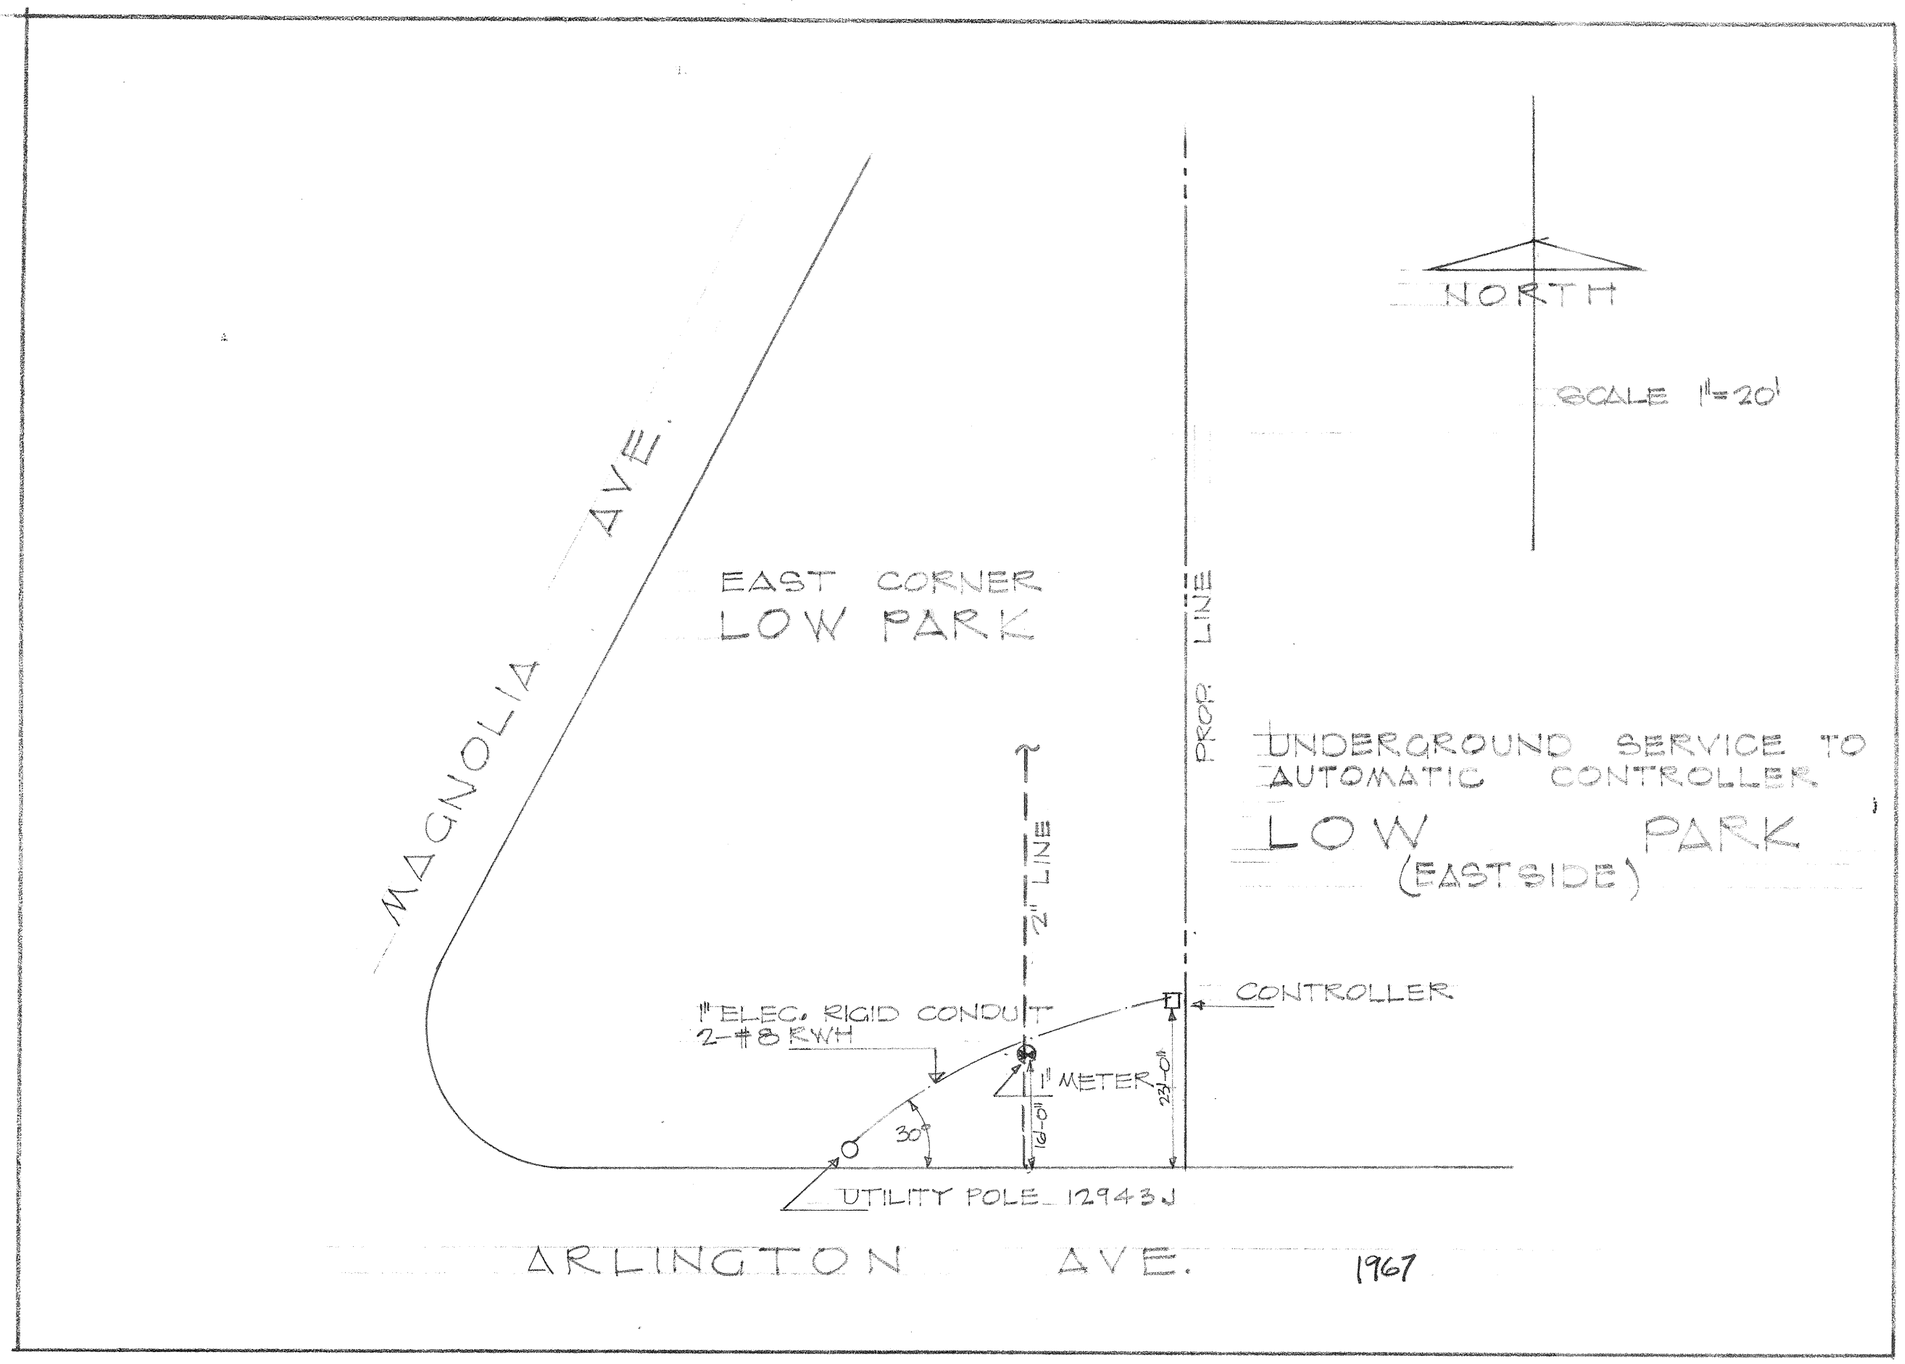

P-131-5