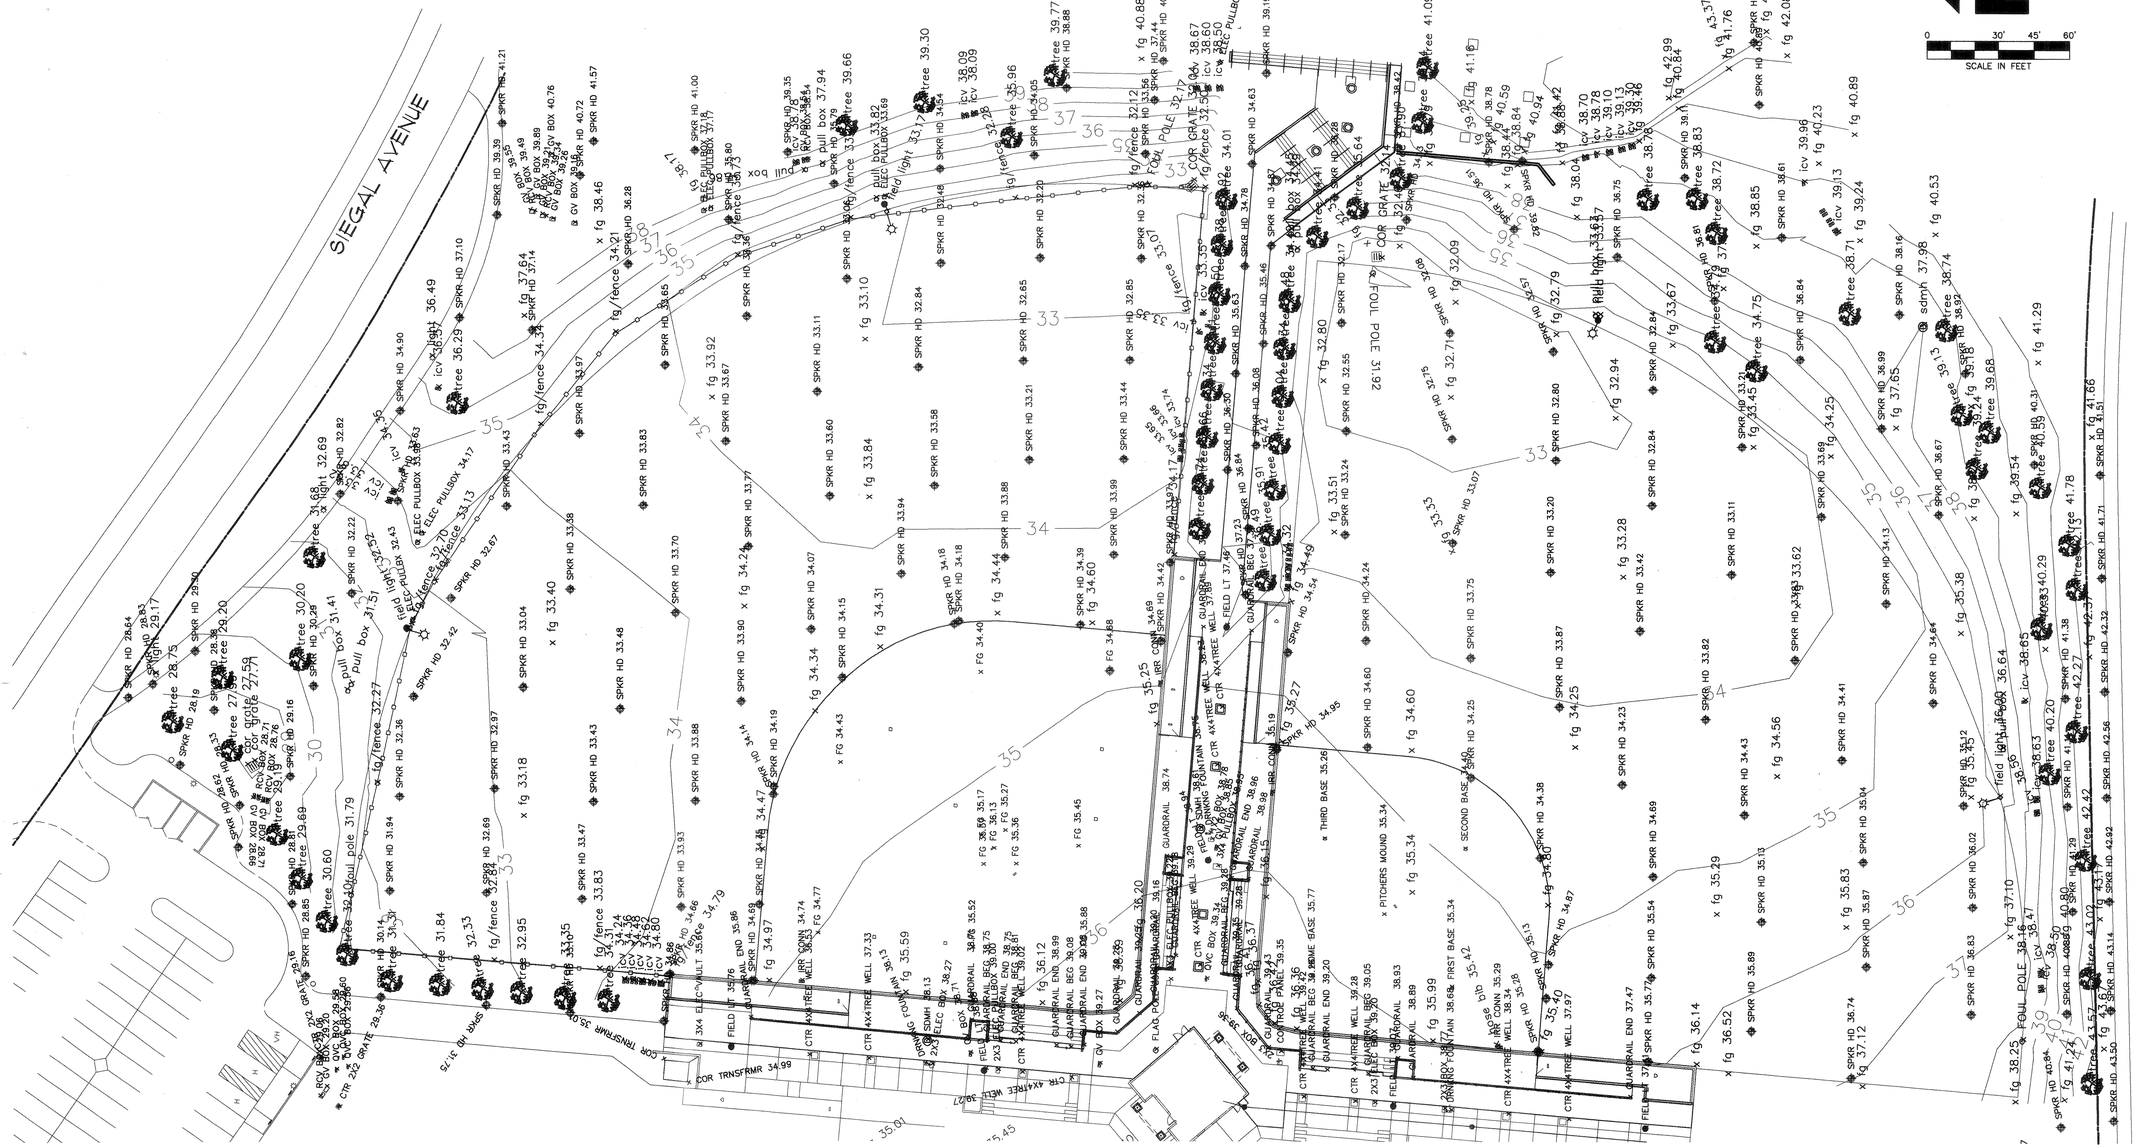

LEGEND	ABBREVIATIONS	
EXISTING TREE	COR GRATE	FINISH GRADE AT CORNER OF GRATE
IRRIGATION CONTROL VALVE	FG	FINISH GRADE
GRATE INLET	FG/FENCE	FINISH GRADE AT FENCE POLE
PULL BOX	FIELD LIGHT	FINISH GRADE AT LIGHT POLE
LIGHT POLE	FOUL POLE	FINISH GRADE AT FOUL POLE
DRAIN MANHOLE	HOSE BIB	FINISH GRADE AT HOSE BIB
SPRINKLER HEAD	ICV	FINISH GRADE AT IRRIG CONT. VALVE
QUICK COUPLER	LIGHT	FINISH GRADE AT LIGHT POLE
	PULL BOX	FINISH GRADE AT PULLBOX
	SDMH	FINISH GRADE AT STORM DRAIN MH
	TREE	FINISH GRADE AT TREE
	SPKR HD	FINISH GRADE AT SPRINKLER HEAD
	QVC	FINISH GRADE AT QUICK COUPLER
	GV BOX	FINISH GRADE AT BALL VALVE
	RCV BOX	FINISH GRADE AT RADIO CONTROL VALVE

F. Correia Surveying
PO BOX 77938
CORONA, CA 92877
TEL/FAX (909) 371-7579

AS-BUILT TOPO 7/15/03
SHEET 1 OF 2

SEE SHEET 1 OF 2

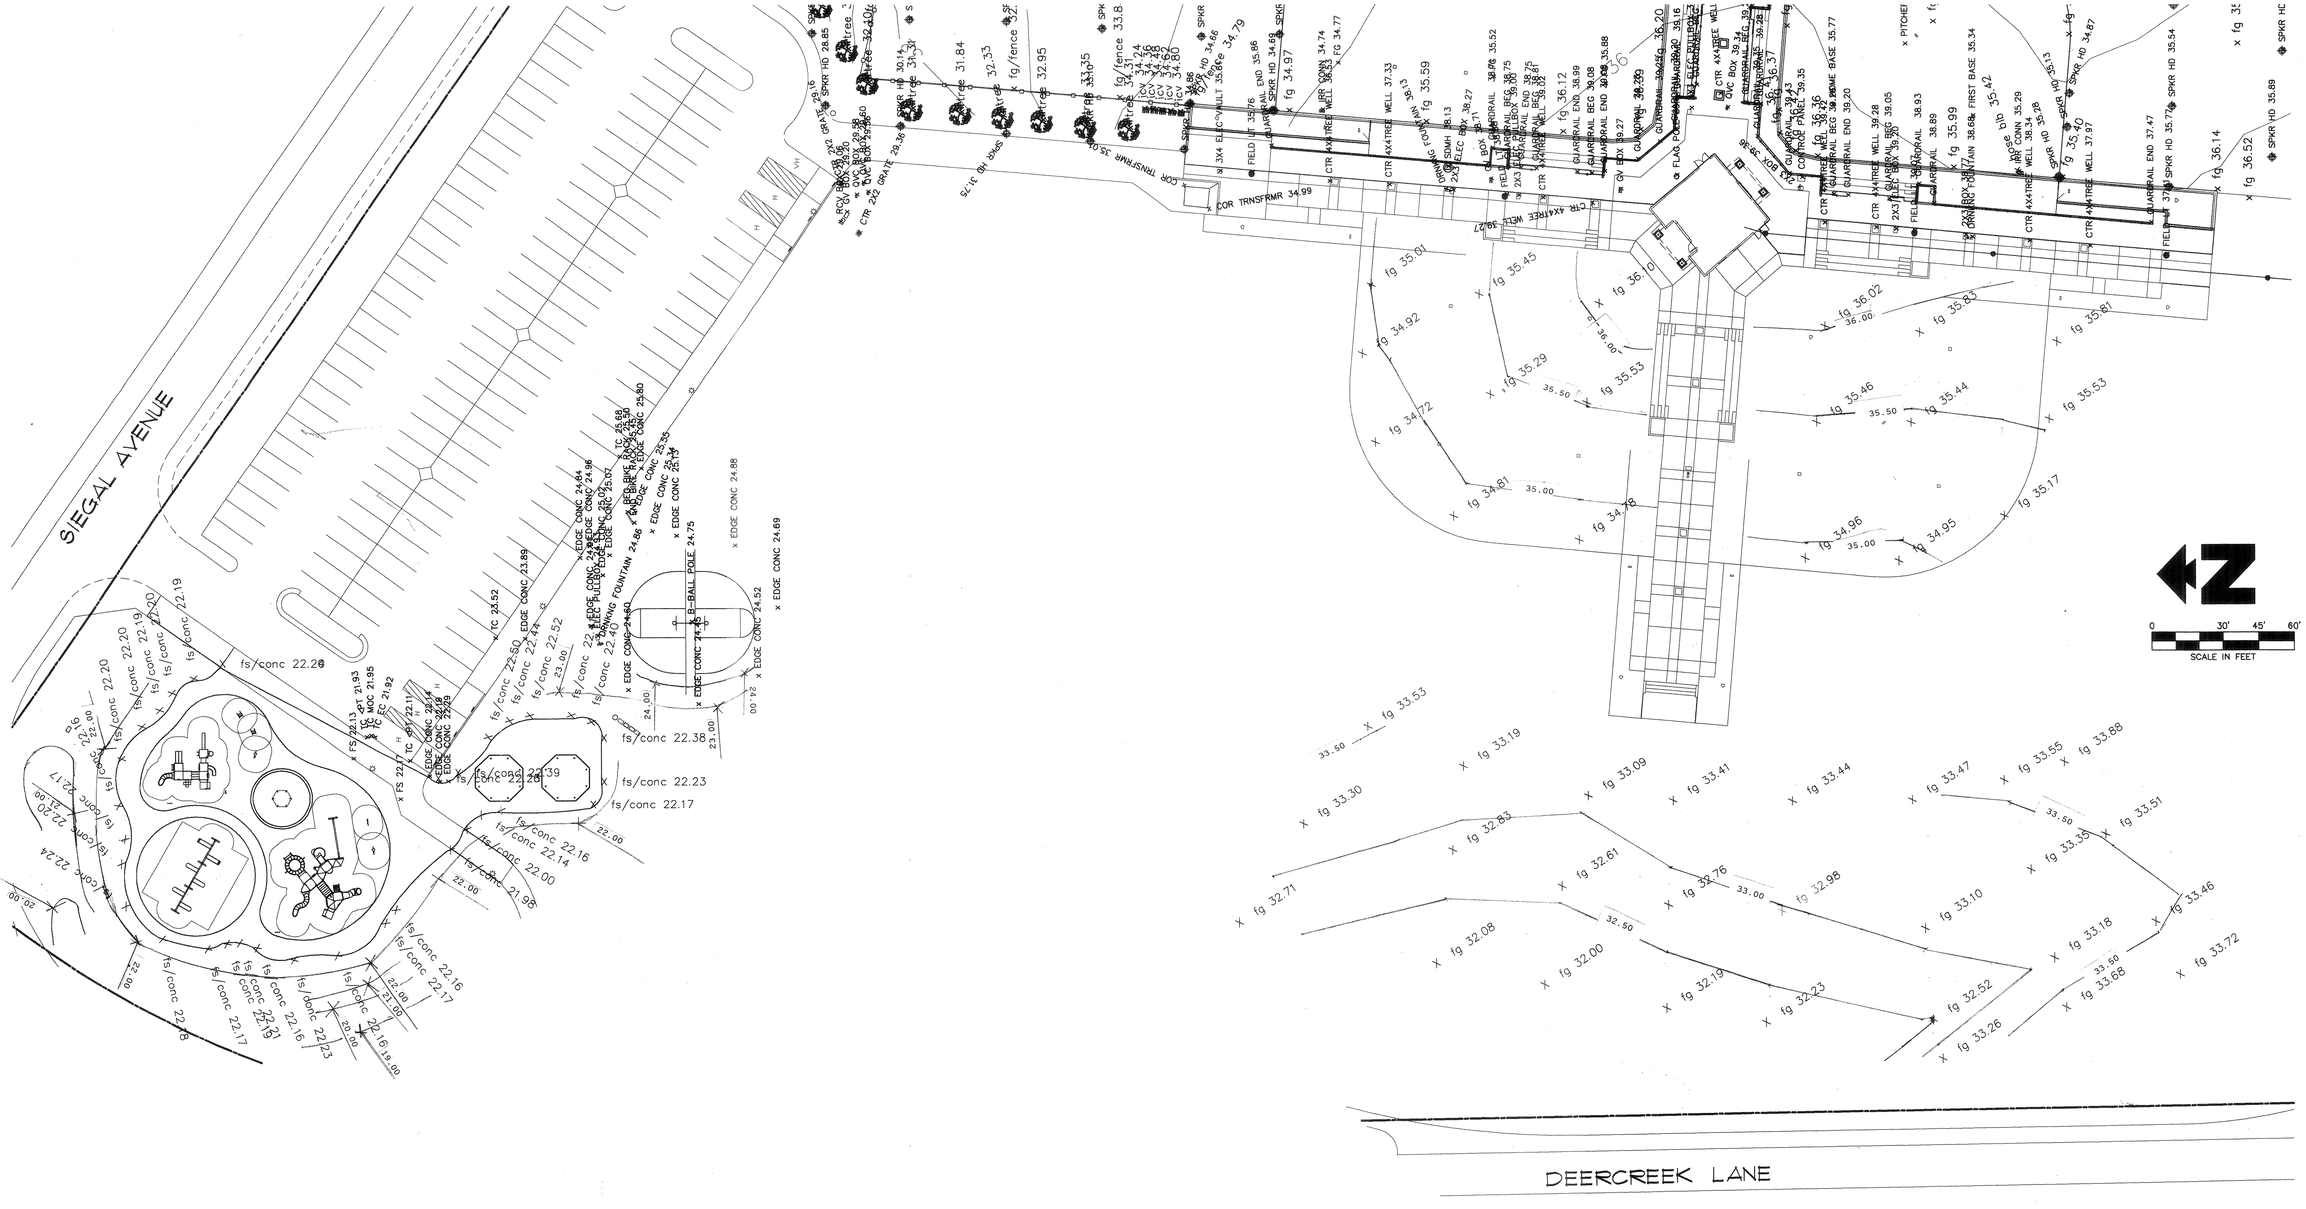

LEGEND	ABBREVIATIONS	
EXISTING TREE	COR GRATE	FINISH GRADE AT CORNER OF GRATE
IRRIGATION CONTROL VALVE	FG	FINISH GRADE
GRATE INLET	FG/FENCE	FINISH GRADE AT FENCE POLE
PULL BOX	FIELD LIGHT	FINISH GRADE AT LIGHT POLE
LIGHT POLE	FOUL POLE	FINISH GRADE AT FOUL POLE
DRAIN MANHOLE	HOSE BIB	FINISH GRADE AT HOSE BIB
SPRINKLER HEAD	ICV	FINISH GRADE AT IRRIG CONT. VALVE
QUICK COUPLER	LIGHT	FINISH GRADE AT LIGHT POLE
	PULL BOX	FINISH GRADE AT PULLBOX
	SDMH	FINISH GRADE AT STORM DRAIN MH
	TREE	FINISH GRADE AT TREE
	SPKR HD	FINISH GRADE AT SPRINKLER HEAD
	QVC	FINISH GRADE AT QUICK COUPLER
	GV BOX	FINISH GRADE AT BALL VALVE
	RCV BOX	FINISH GRADE AT RADIO CONTROL VALVE

F. Correia Surveying
PO BOX 77938
CORONA, CA 92877
TEL/FAX (909) 371-7579

AS-BUILT TOPO 7/15/03
SHEET 2 OF 2