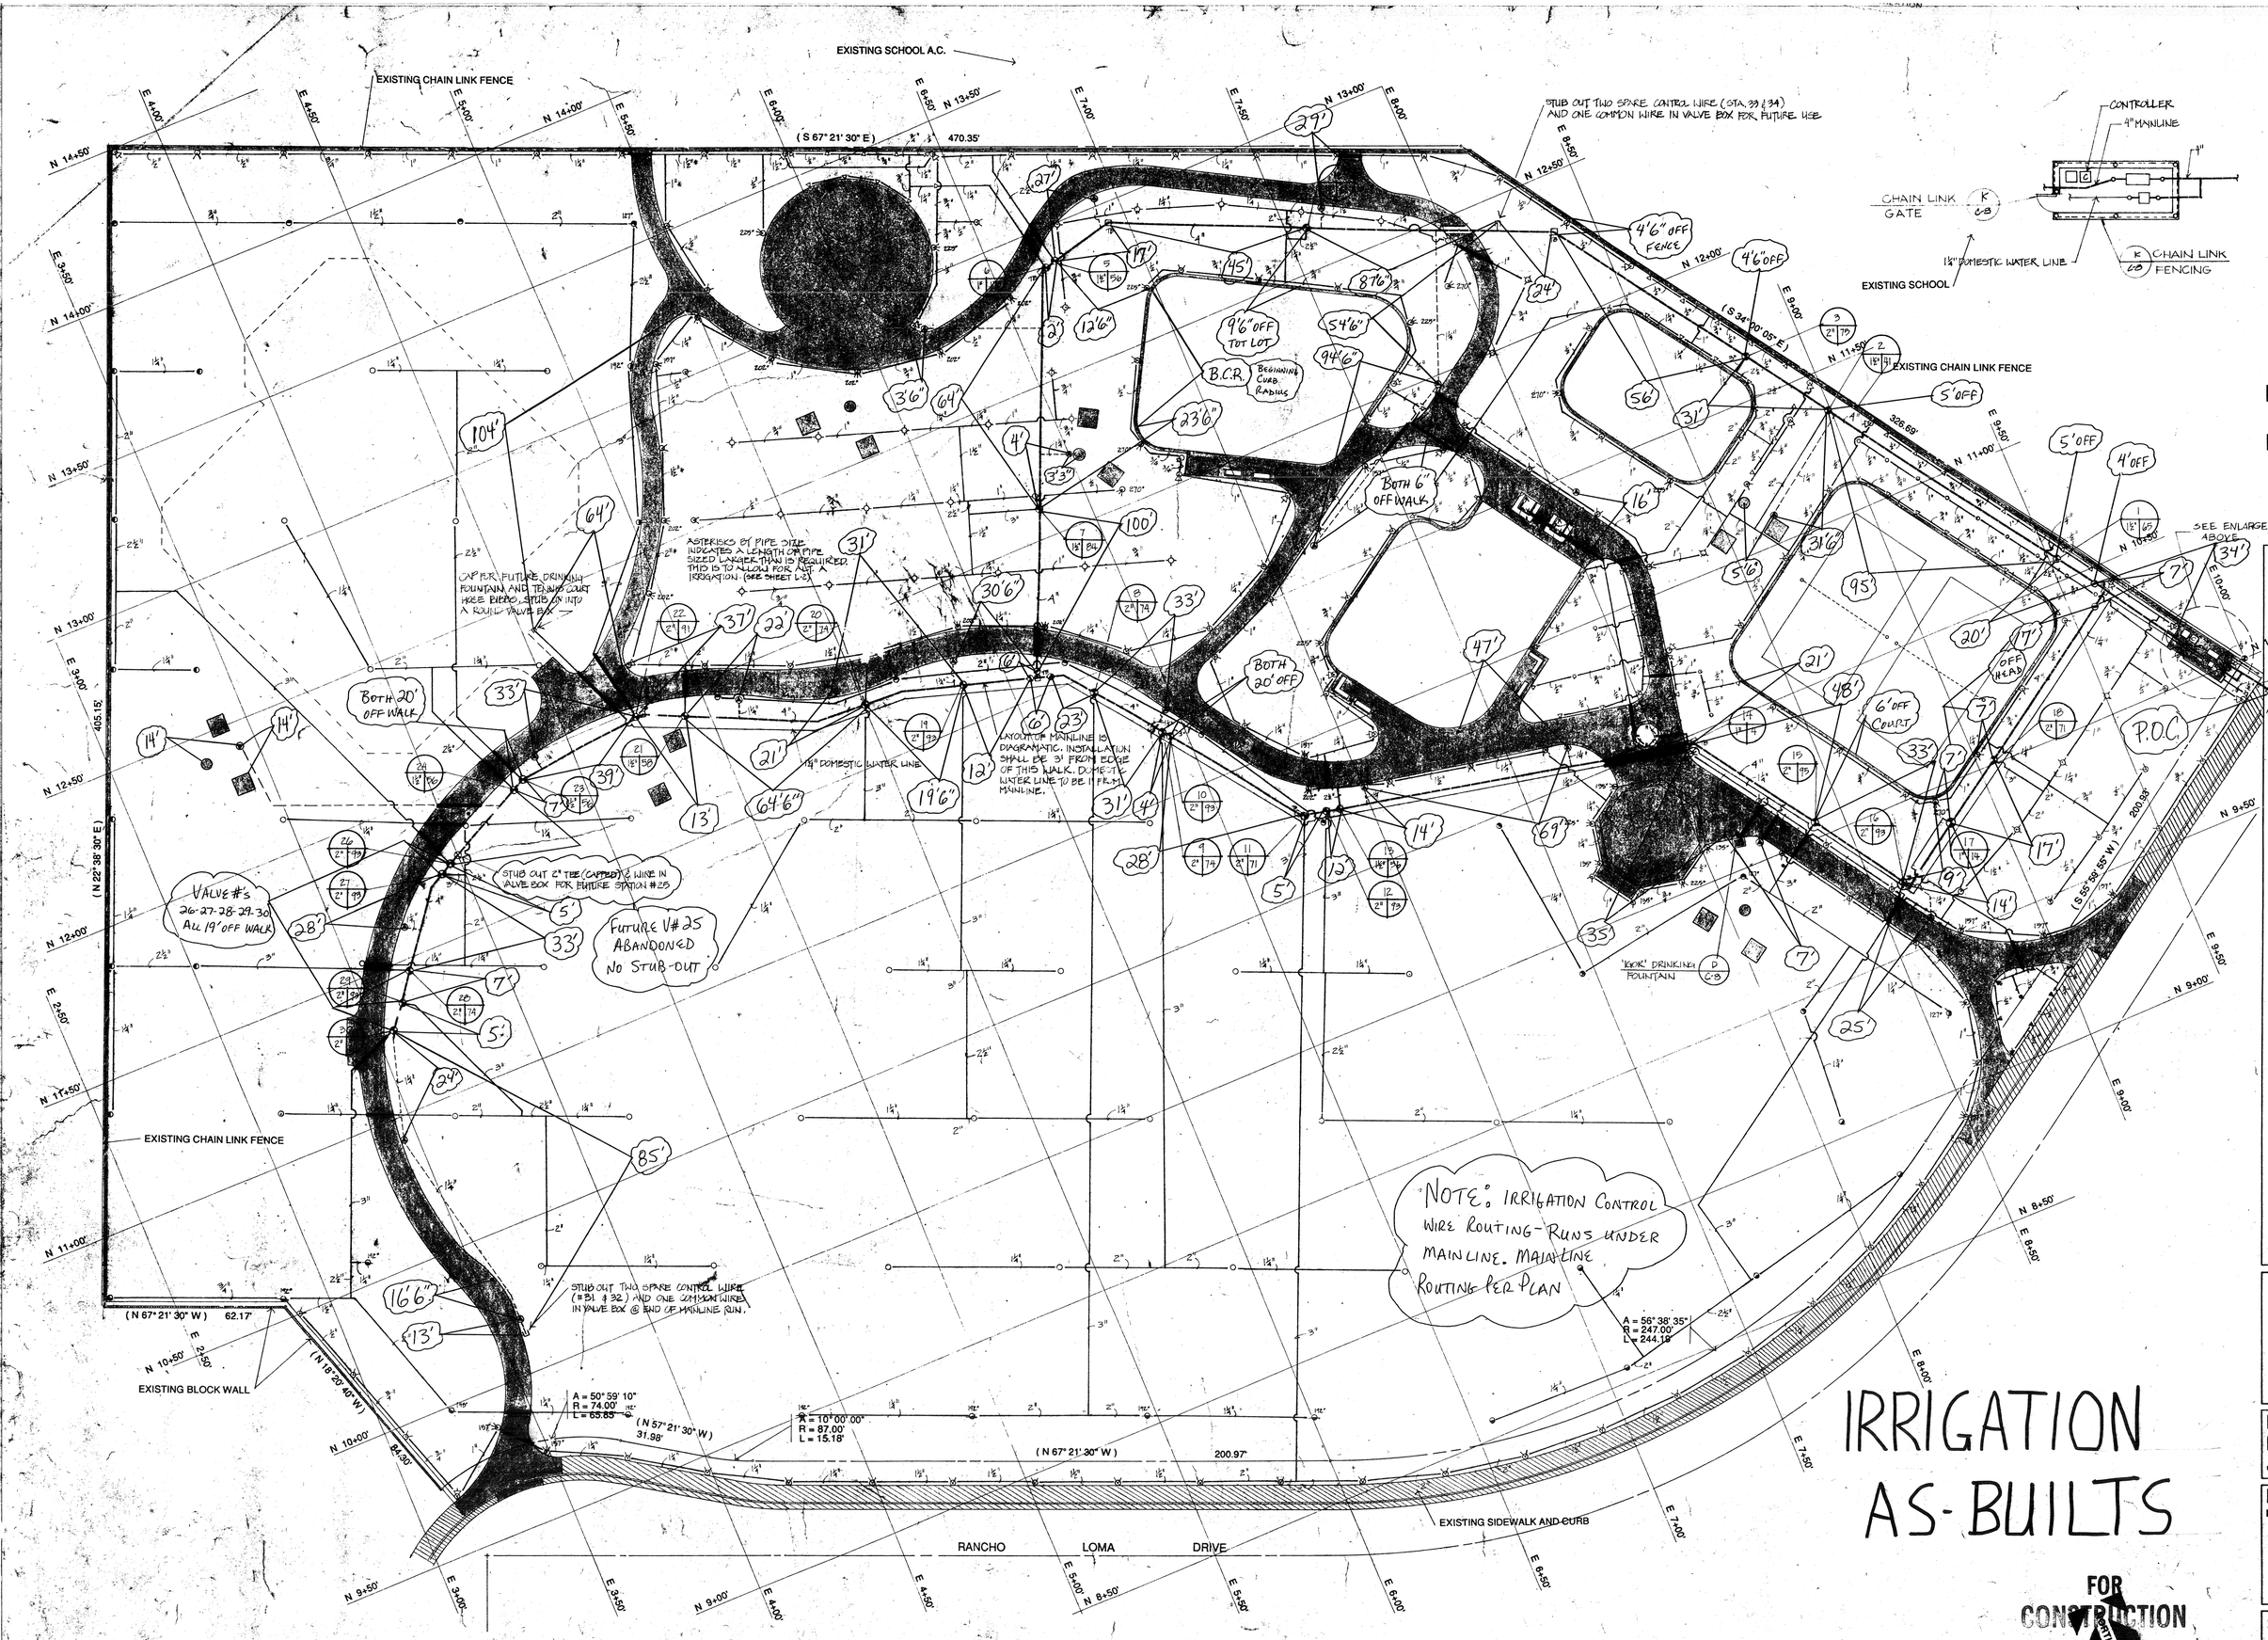

Irrigation Plan Refer to Sheet L-2 for Legend, Notes, and Details. SCALE: 1"= 20'-0"

NOTE: Origin of Grid is the South/West Corner of the Property at Rancho Loma Drive N 10+00' & S 10+00'

LANDSCAPE ARCHITECTURE AND PLANNING
515 W. COMMONWEALTH, SUITE 205
FULLERTON, CA 92632 (714)773-0973
ASLA

Heimberger Hirsch

Project;

Rancho Loma Park
The City of Riverside
3900 Main Street
Riverside, CA. 92522

Date; July 1, 199[illegible]
Design; C. Heimb[illegible]
Job No; 89014

Description; Irrigation Plan

Sheet 13 of 17
Dwg # L-1
P - 0810