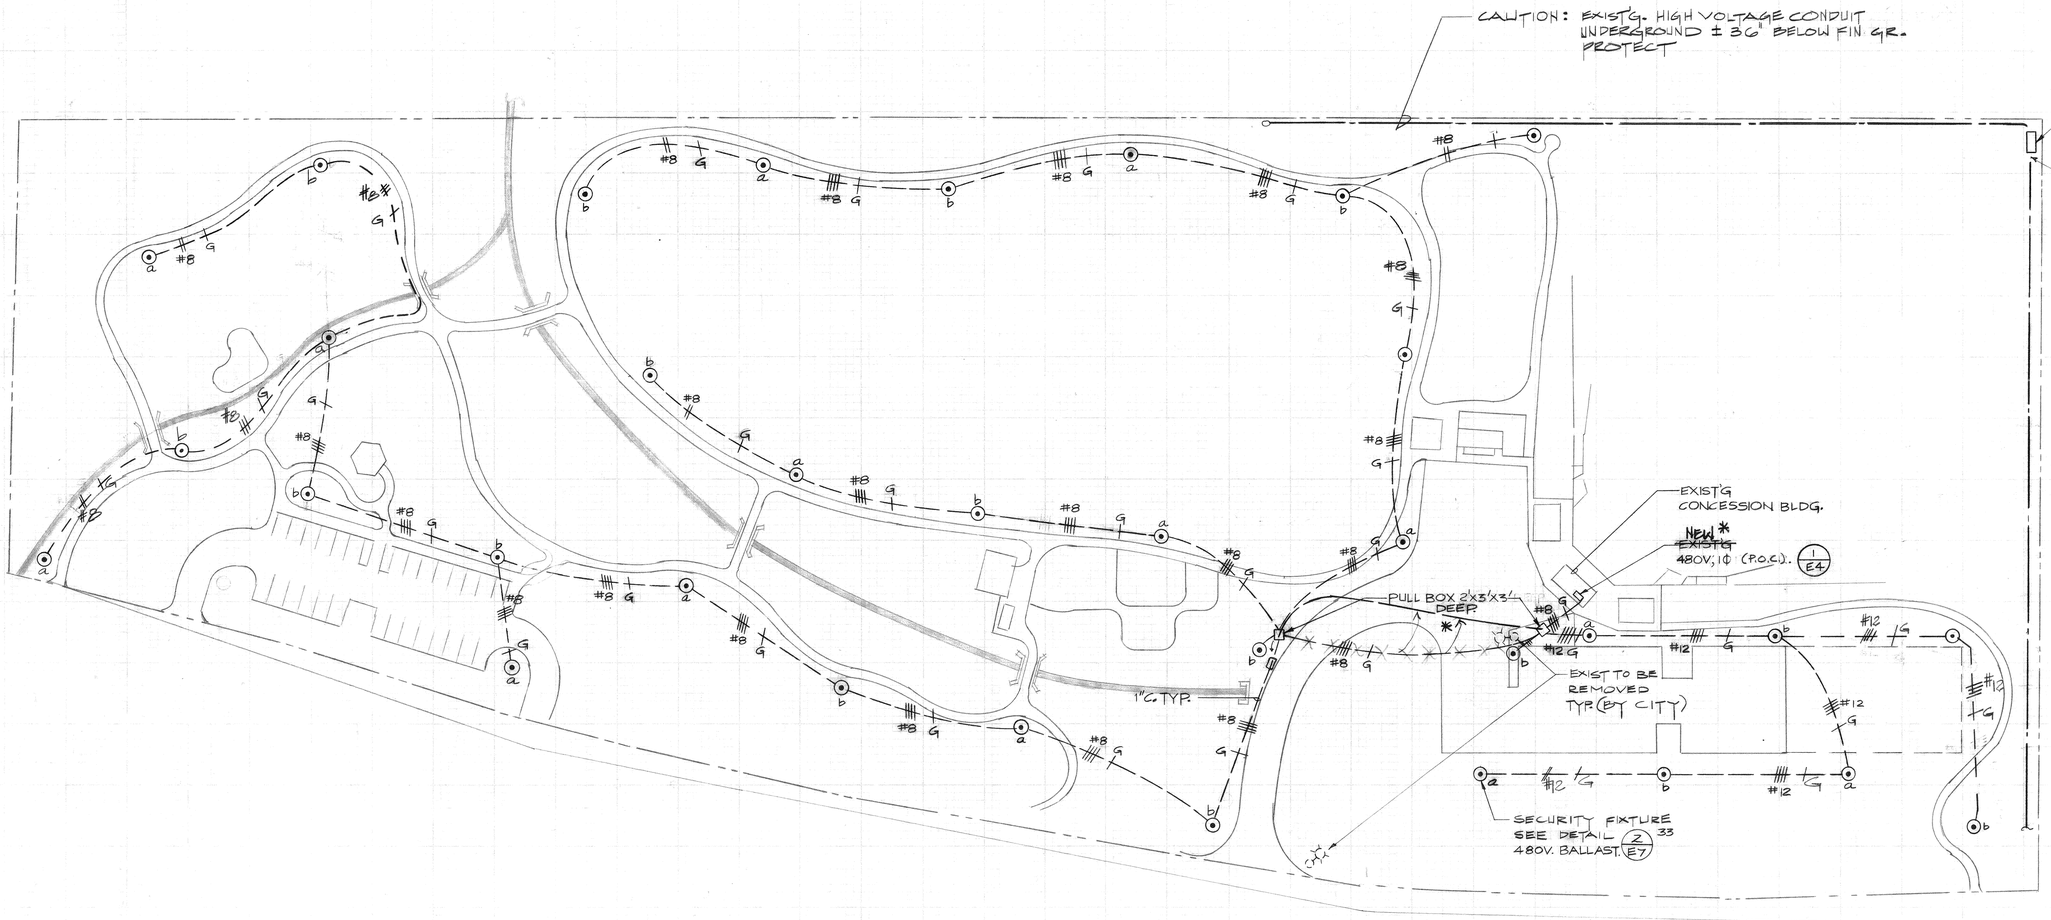

A/— ELECTRICAL SITE PLAN, REID PARK
SCALE: 1" = 40'-0"

NOTES:

1. FINAL LIGHT STANDARD LOCATIONS TO BE VERIFIED AND APPROVED IN THE FIELD BY THE PARKS DEPT. REPRESENTATIVE PRIOR TO INSTALLATION/DIGGING FOR FOOTINGS.
2. CONDUIT ROUTING IN PROXIMITY TO EXISTING TREES SHALL BE AS APPROVED BY THE CITY.

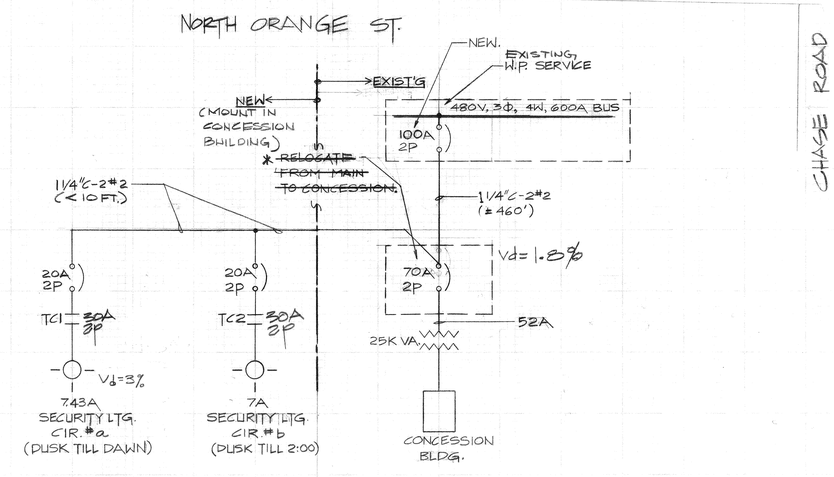

1/E4 1-LINE DIAGRAM
NO SCALE

* "AS-BUILT"

MULLEN & ASSOCIATES INC.
CONSULTING ENGINEERS
1940 N. TUSTIN AVE., SUITE 113
ORANGE, CALIFORNIA 92665/714-637-6621

REGISTERED PROFESSIONAL ENGINEER 9-25-81 LARRY D. MULLEN ELECTRICAL STATE OF CALIFORNIA

RIVERSIDE PARK LIGHTING
CITY OF RIVERSIDE

REID PARK
ELECTRICAL PLAN
JOB # 8072

REVISIONS

DATE:

SHEET E 1 OF 2

PLAN # P1010

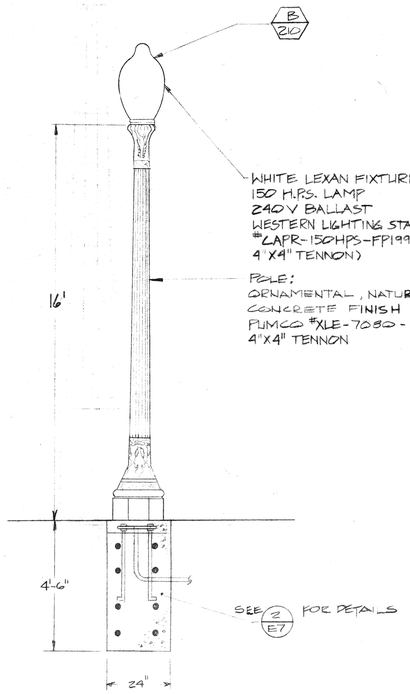

1 E7 SECURITY LIGHT DETAIL
N.T.S.

NOTES:

1. FINAL LIGHT STANDARD LOCATIONS TO BE VERIFIED AND APPROVED IN THE FIELD BY THE PARKS DEPT. REPRESENTATIVE PRIOR TO INSTALLATION/DIGGING FOR FOOTINGS.
2. CONDUIT ROUTING IN PROXIMITY TO EXISTING TREES SHALL BE AS APPROVED BY THE CITY.

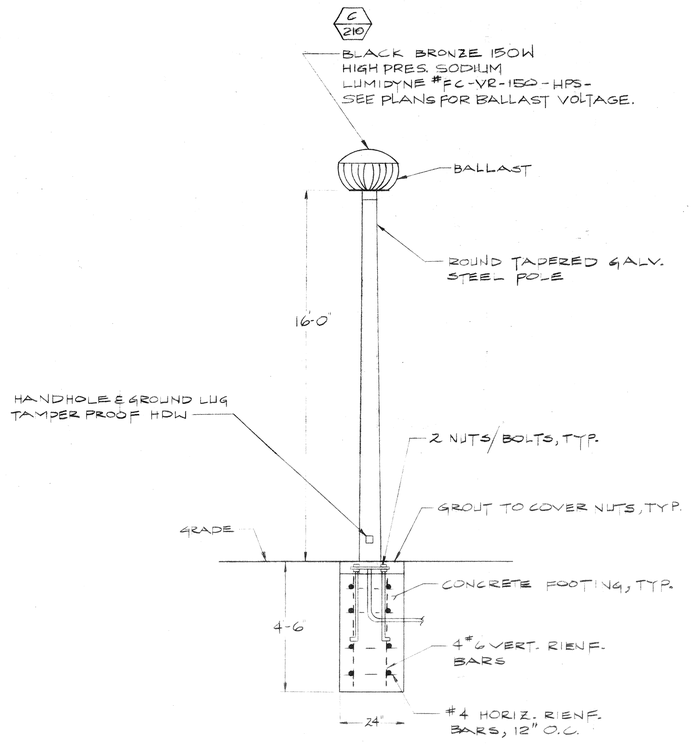

2 E7 PARKING/WALKWAY LIGHT DETAIL
N.T.S.

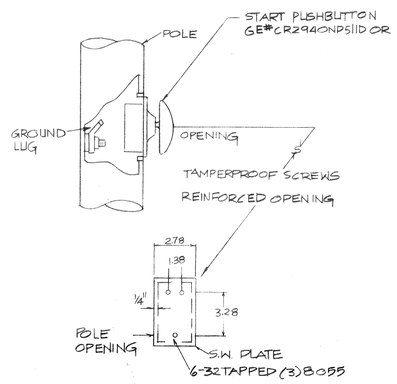

1 E5 HARD COURT PUSHBUTTON DETAIL
N.T.S.

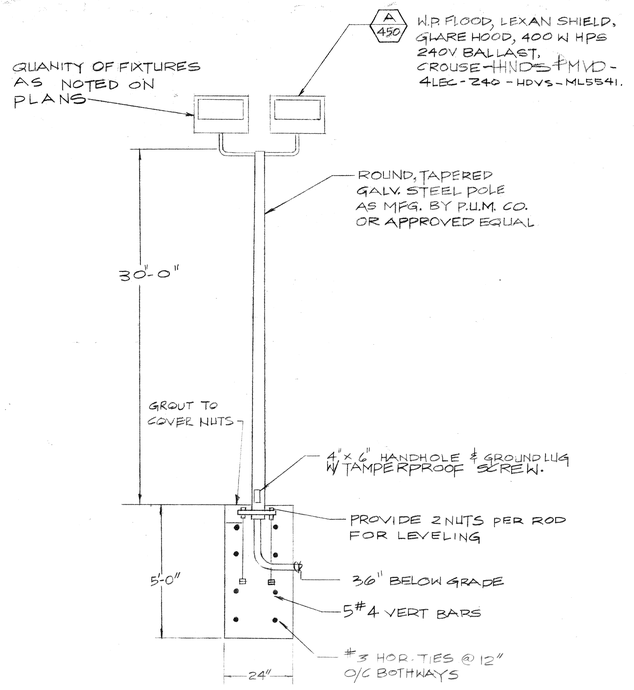

2 B4 FLOODLIGHT/HARD COURT LIGHTING DETAIL
NTS

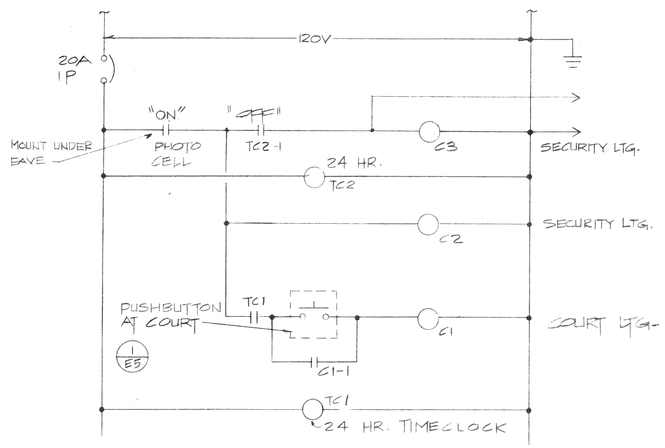

3 E4 LIGHT CONTROL DIAGRAM (BORDWELL PARK)
NO SCALE (TYP. FOR WHITE, REID, SHAMEL)

FOR REPRODUCIBLE OF THIS SHEET SEE WHITE PK.

MULLEN & ASSOCIATES INC.
CONSULTING ENGINEERS
1940 N. TUSTIN AVE., SUITE 113
ORANGE, CALIFORNIA 92665/714-637-6621

RIVERSIDE PARK LIGHTING
CITY OF RIVERSIDE

ELECTRICAL PLAN JOB# 3072

REID PARK FILE COPY

REVISIONS

DATE:

SHEET E 2 OF 8 2

PLAN # P-1010