825.56 825.50 823.80 822.80 824.91 824.29 823.72 823.78 823.61 823.73 823.80 823.90 823.90 824.01 824.70 827.70 836.50 840.03 841.98 842.50

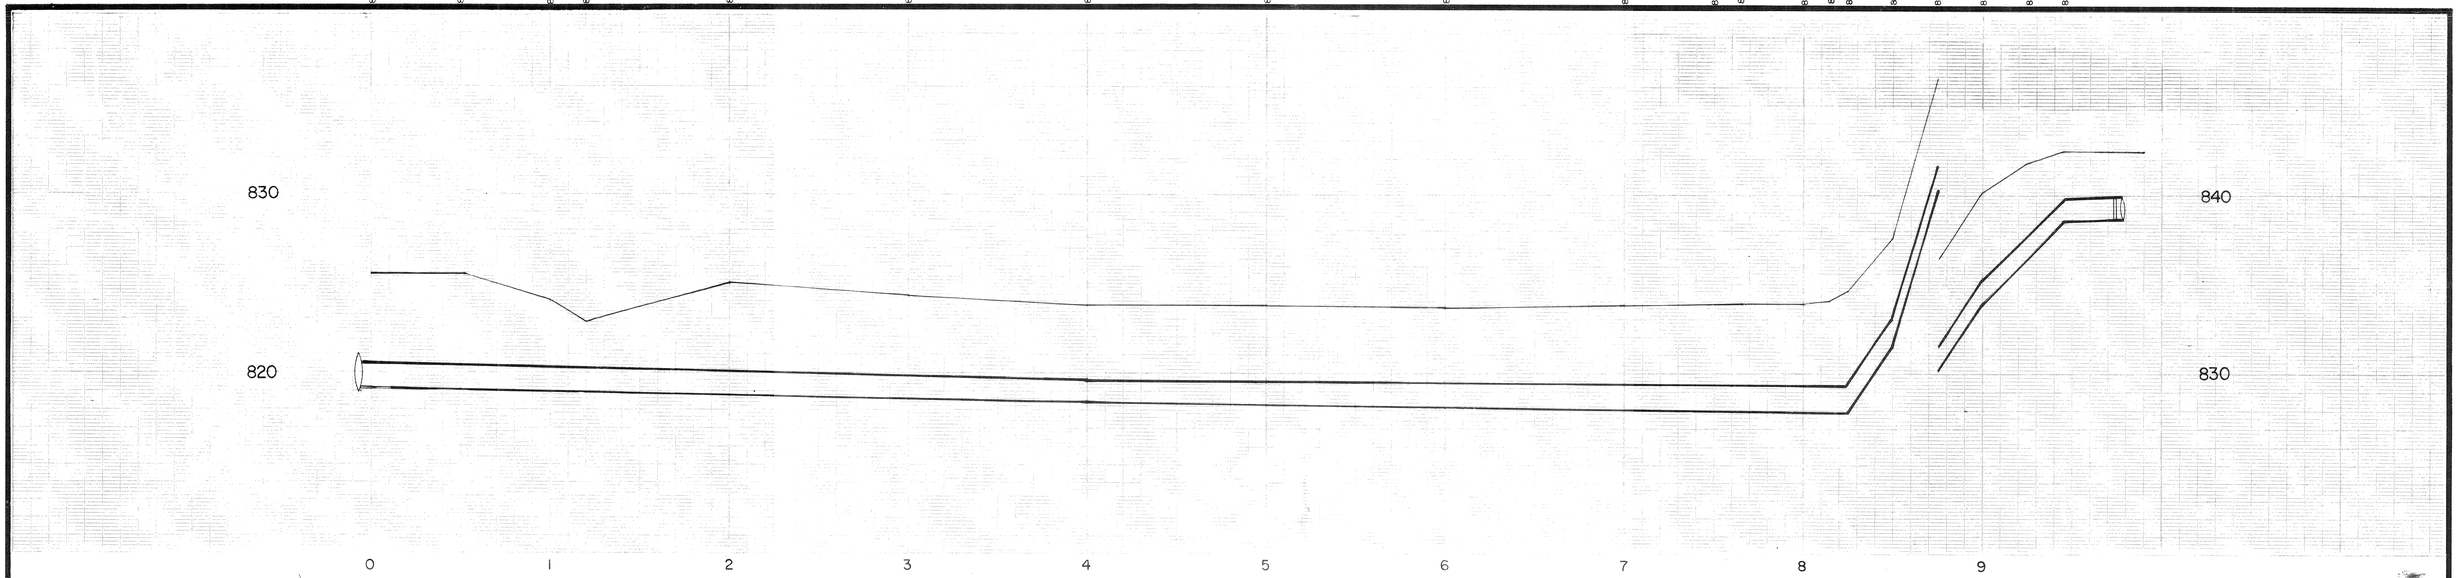

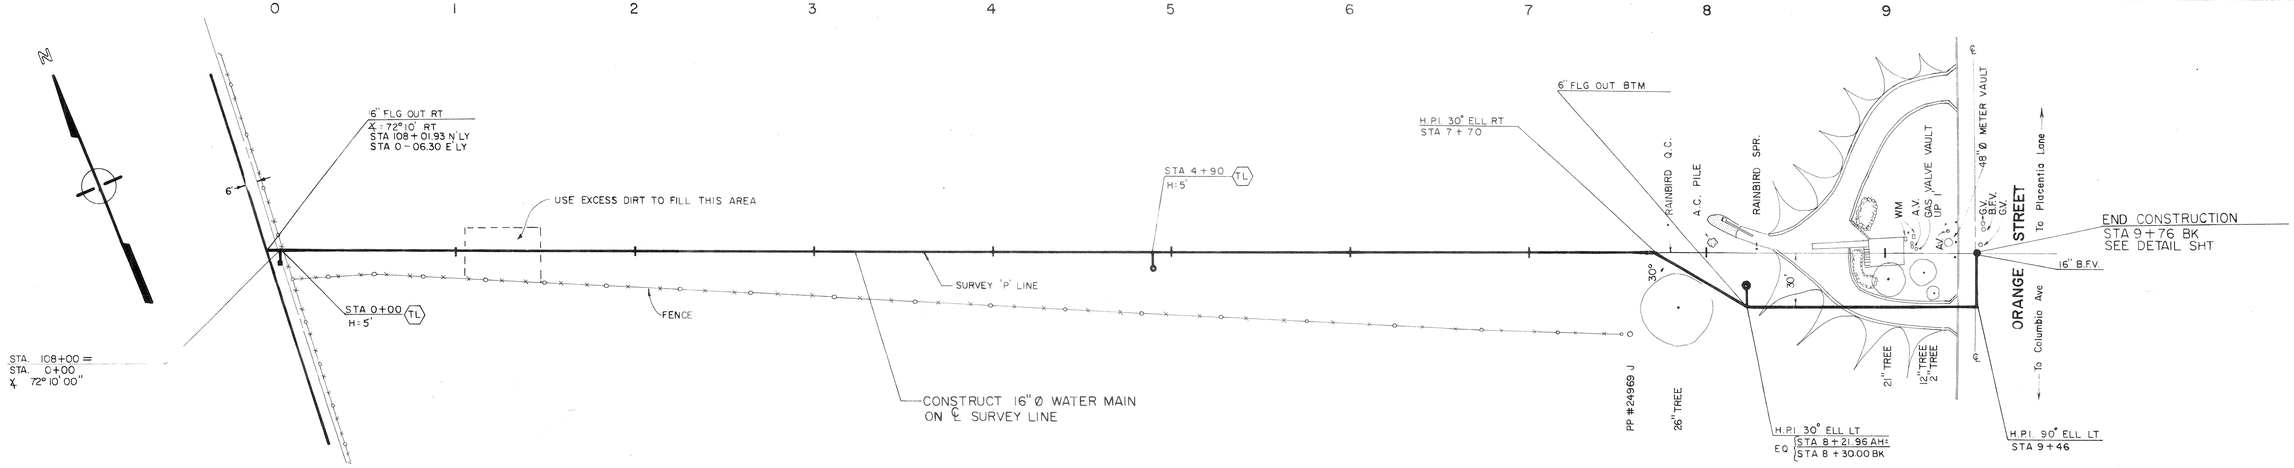

 


NORTH ORANGE 24" Ø T.M.

SCALE H-1"=40' V-1"=4'	DRAWN A. SAINT	CITY OF RIVERSIDE DEPARTMENT OF PUBLIC UTILITIES	
DATE	CHECKED		
JOB No 1269	APPROVED	W DIV.	DRAWING NO. 79-D5-1269-

APPRVD | REVISIONS | DATE | P. B. No

65—751—745—1269—XX843

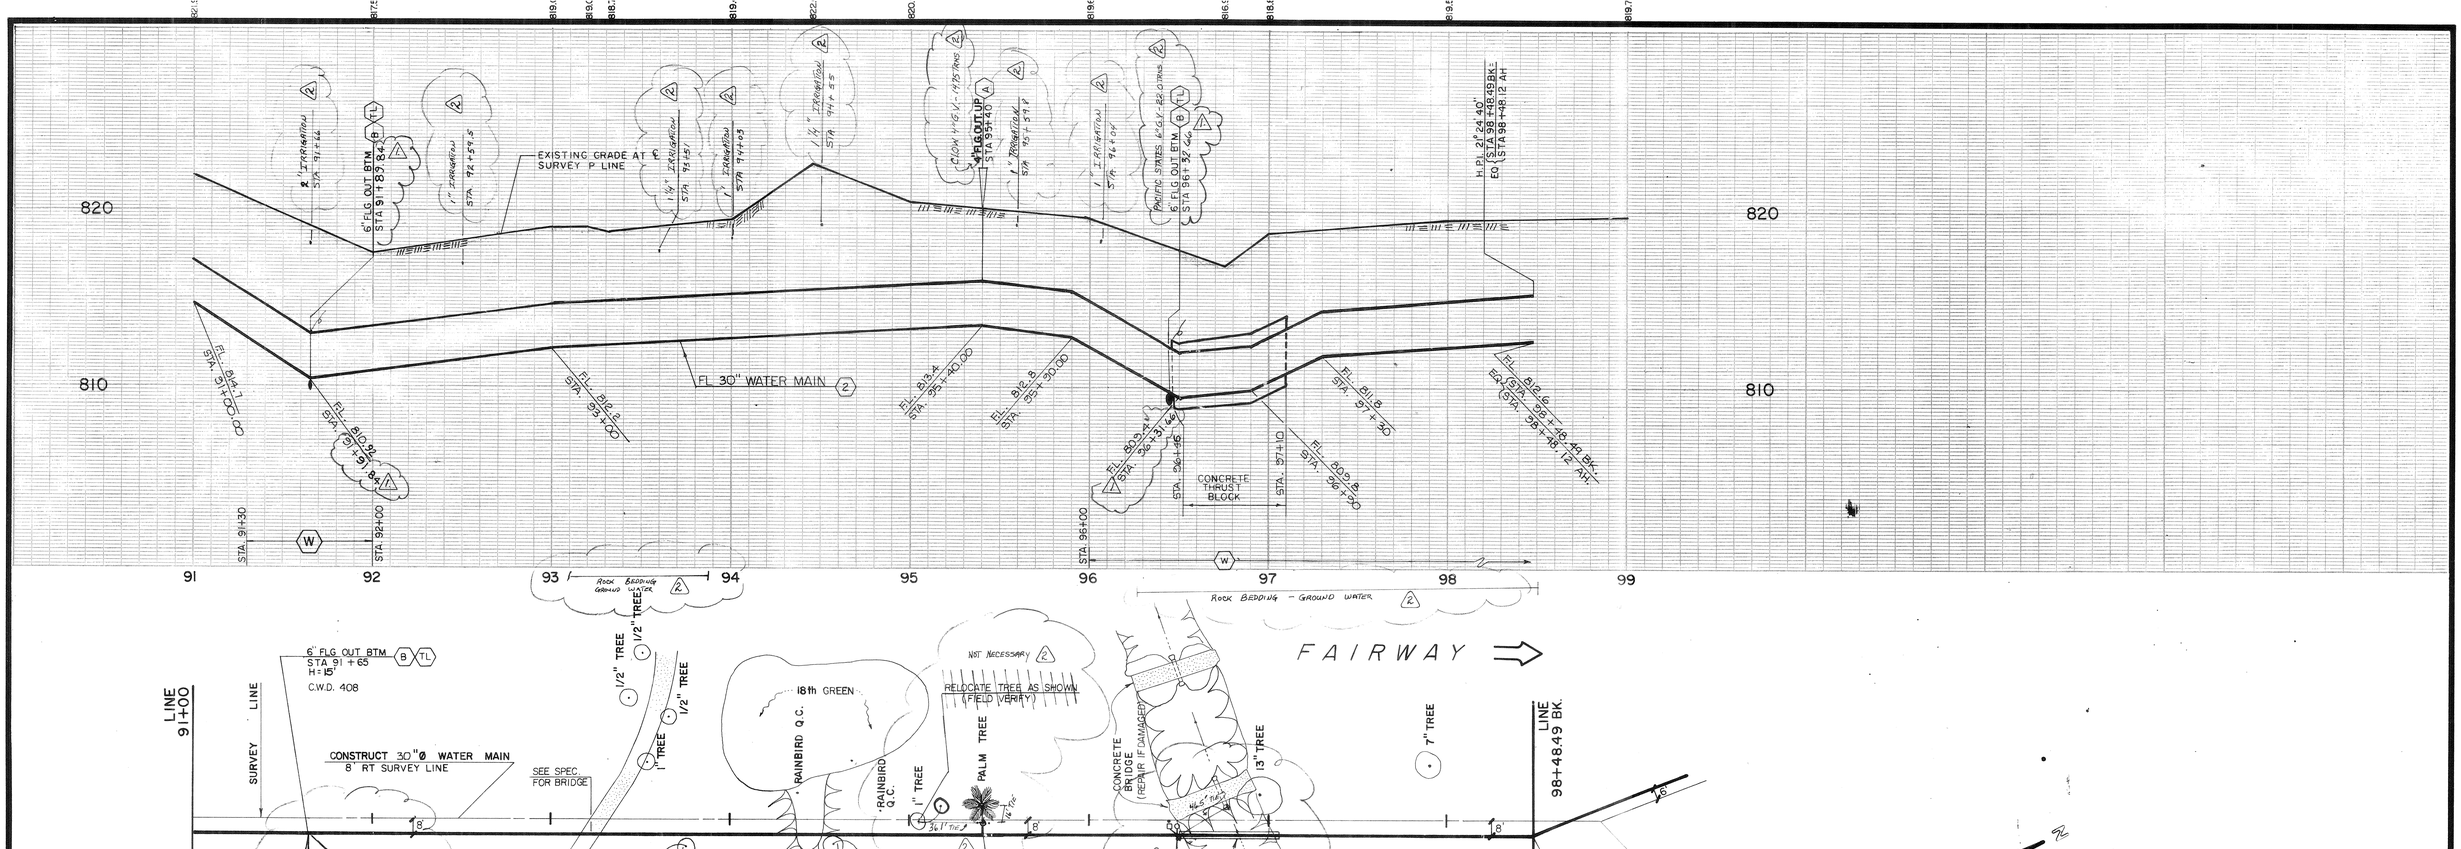

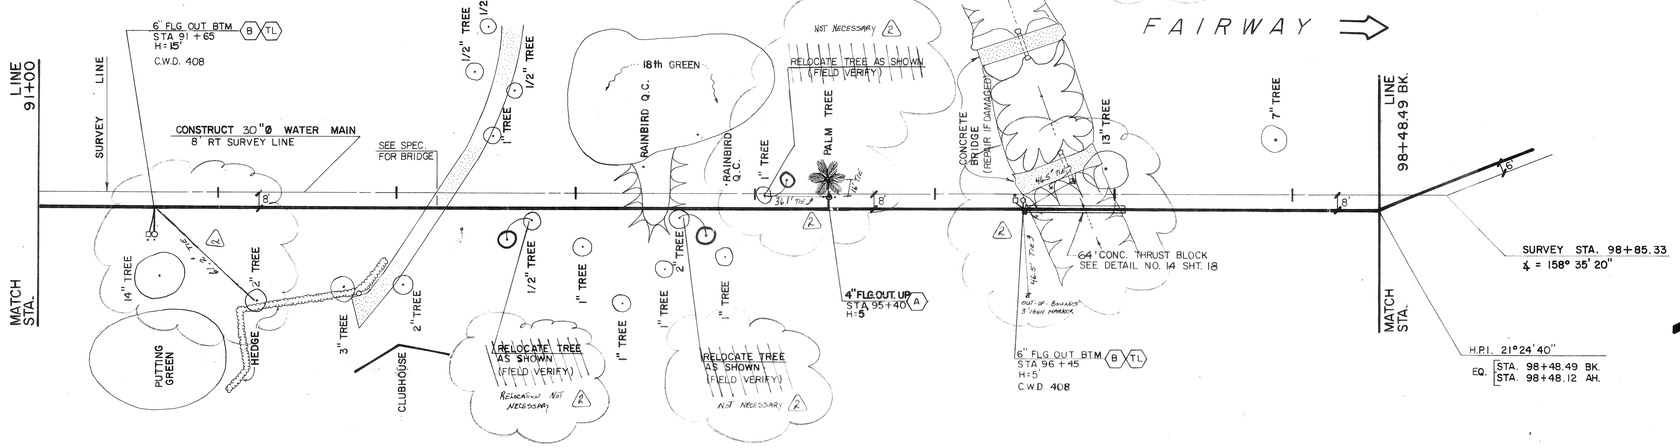

			NORTH ORANGE 30" Ø T.M. PHASE II		
	(2) AS-BUILT by [illegible] 8-82		SCALE H—1"=40' V—1"=4'	DRAWN A. SAINT	CITY OF RIVERSIDE DEPARTMENT OF PUBLIC UTILITIES
	(1) Rev. Loc. per Pipe Co. 2/26/82		DATE OCT. 1981	CHECKED [illegible]	
APPRVD	REVISIONS	DATE	JOB No 1269	APPROVED [signature] 12/7/81	DRAWING NO. W D.W. 78-D5-1269-10
			F. B. No -		

65—751—745—1269—XX843

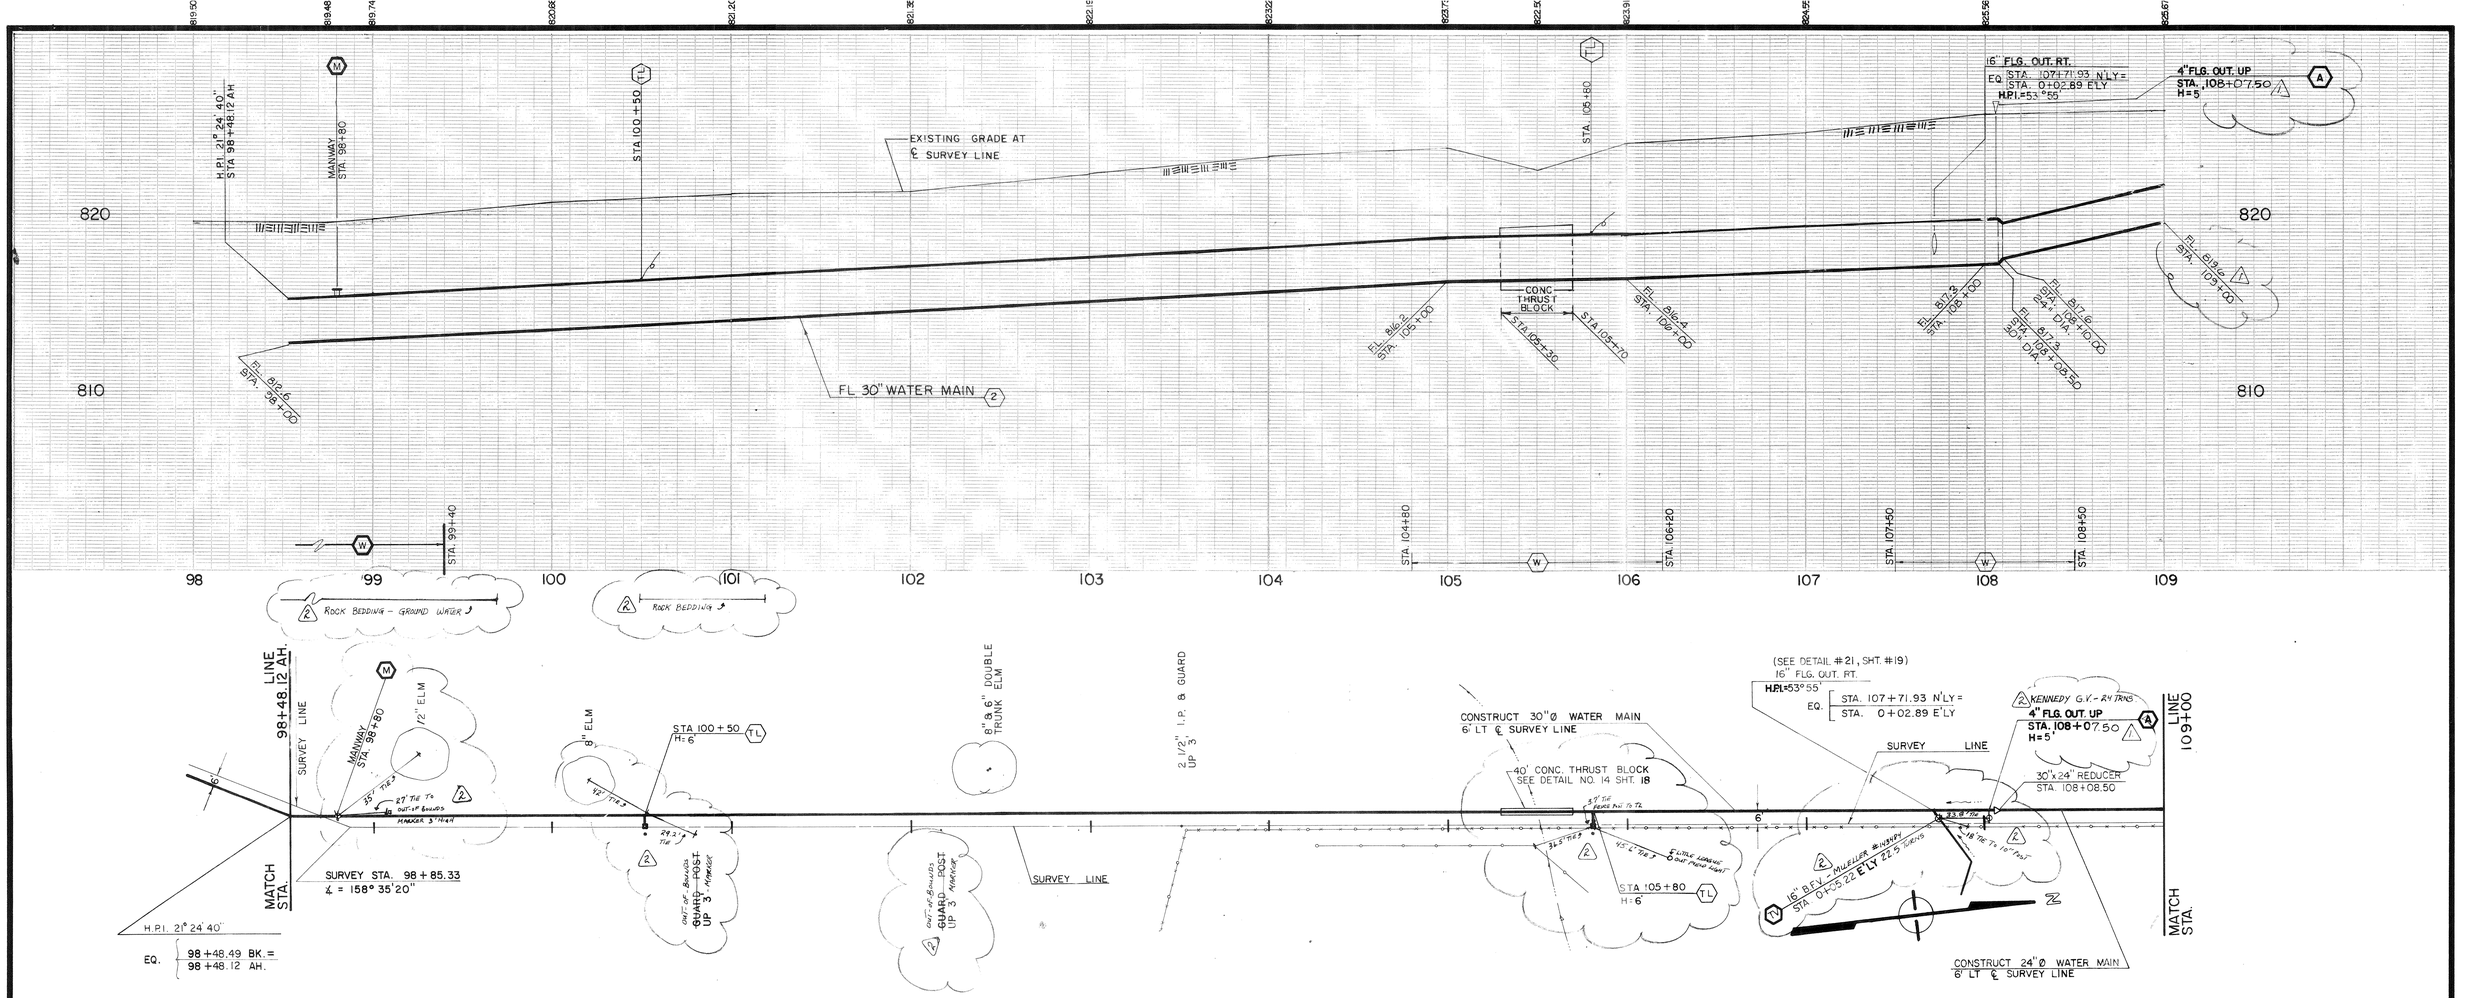

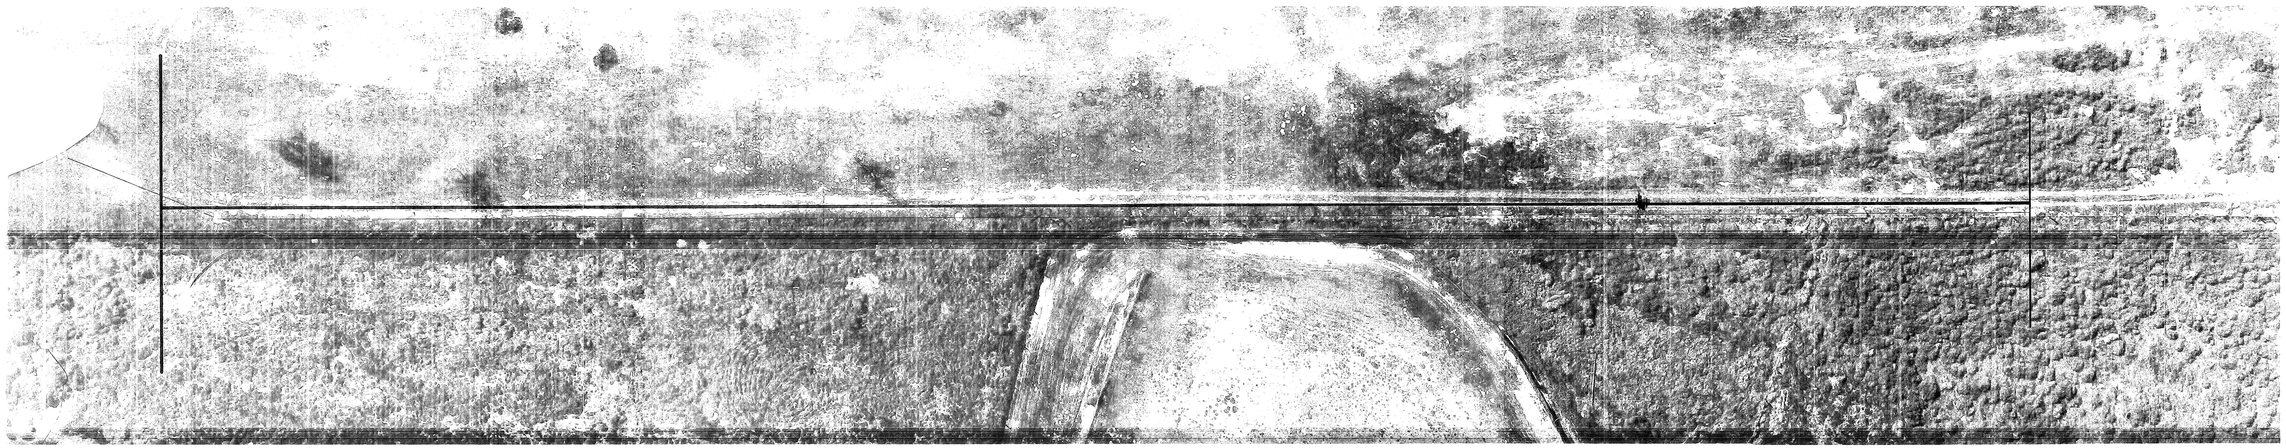

	AS-BUILT Sept 8-4-82	NORTH ORANGE 30" Ø T.M. PHASE II		
DLP	Chd Sta fm 98.0 to 99.0 & Grd Elev fm 8/75 5/25/82	SCALE H—1"=40' V—1"=4'	DRAWN A. SAINT	CITY OF RIVERSIDE DEPARTMENT OF PUBLIC UTILITIES
APPRVD	REVISIONS DATE	DATE OCT. 1981	CHECKED BEW 11/20/81	
		JOB No 1269	APPROVED Kent 12/17/81	DRAWING NO.
		F. B. No -		W DIV. 78-D5-1269-11

65—751—745—1269— XX843

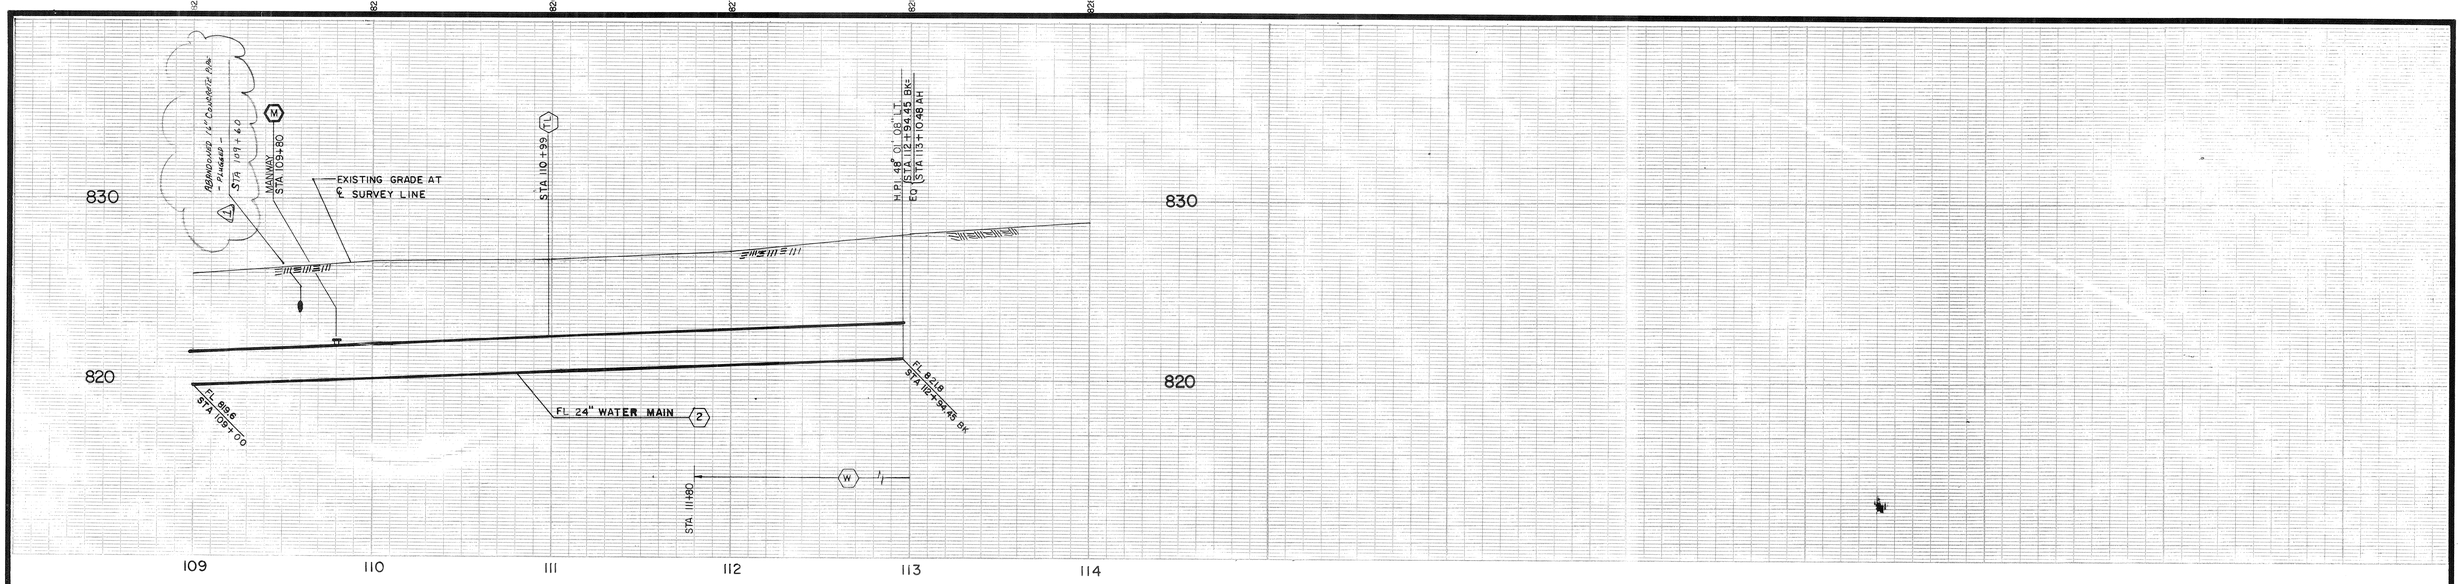

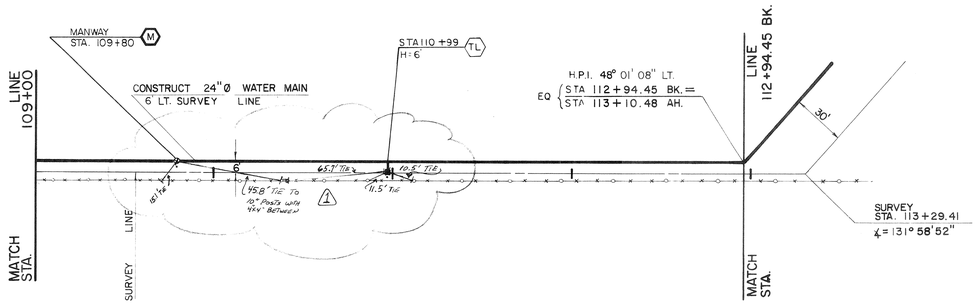

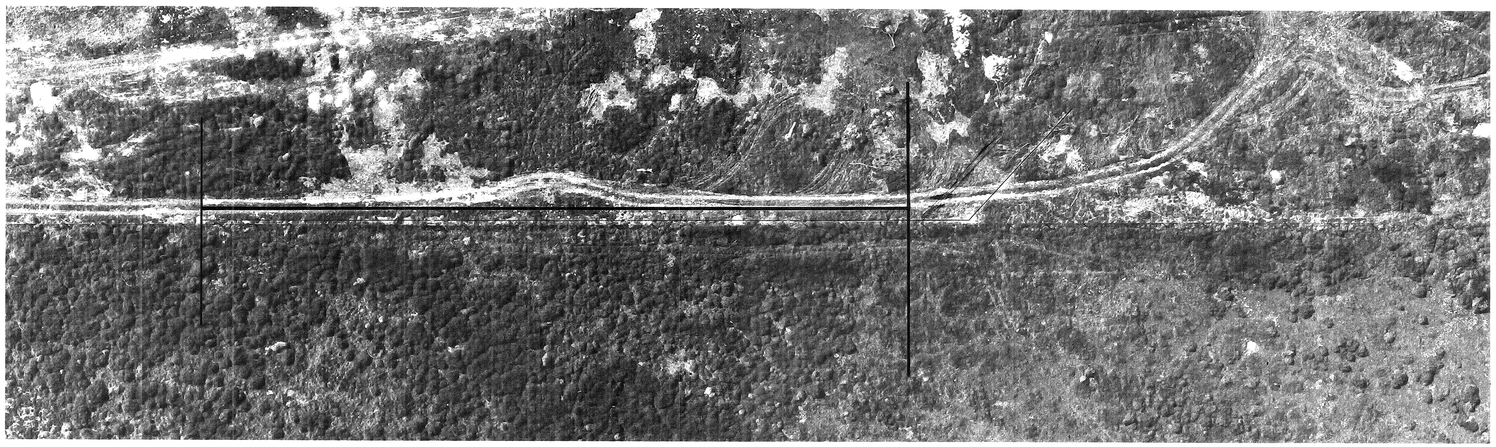

	1 AS-BUILT by B.Y.R.			NORTH ORANGE 30" Ø T.M. PHASE II	
APPRVD	REVISIONS	DATE		SCALE H — 1" = 40' V — 1" = 4'	DRAWN A. SAINT
				DATE OCT. 1981	CHECKED [illegible] 11/20/81
				JOB No 1269	APPROVED [illegible] 12/17/81
				F. B. No -	W DIV.

CITY OF RIVERSIDE
DEPARTMENT OF PUBLIC UTILITIES
DRAWING NO. 78-D5-1269-12

65—751—745—1269—XX843

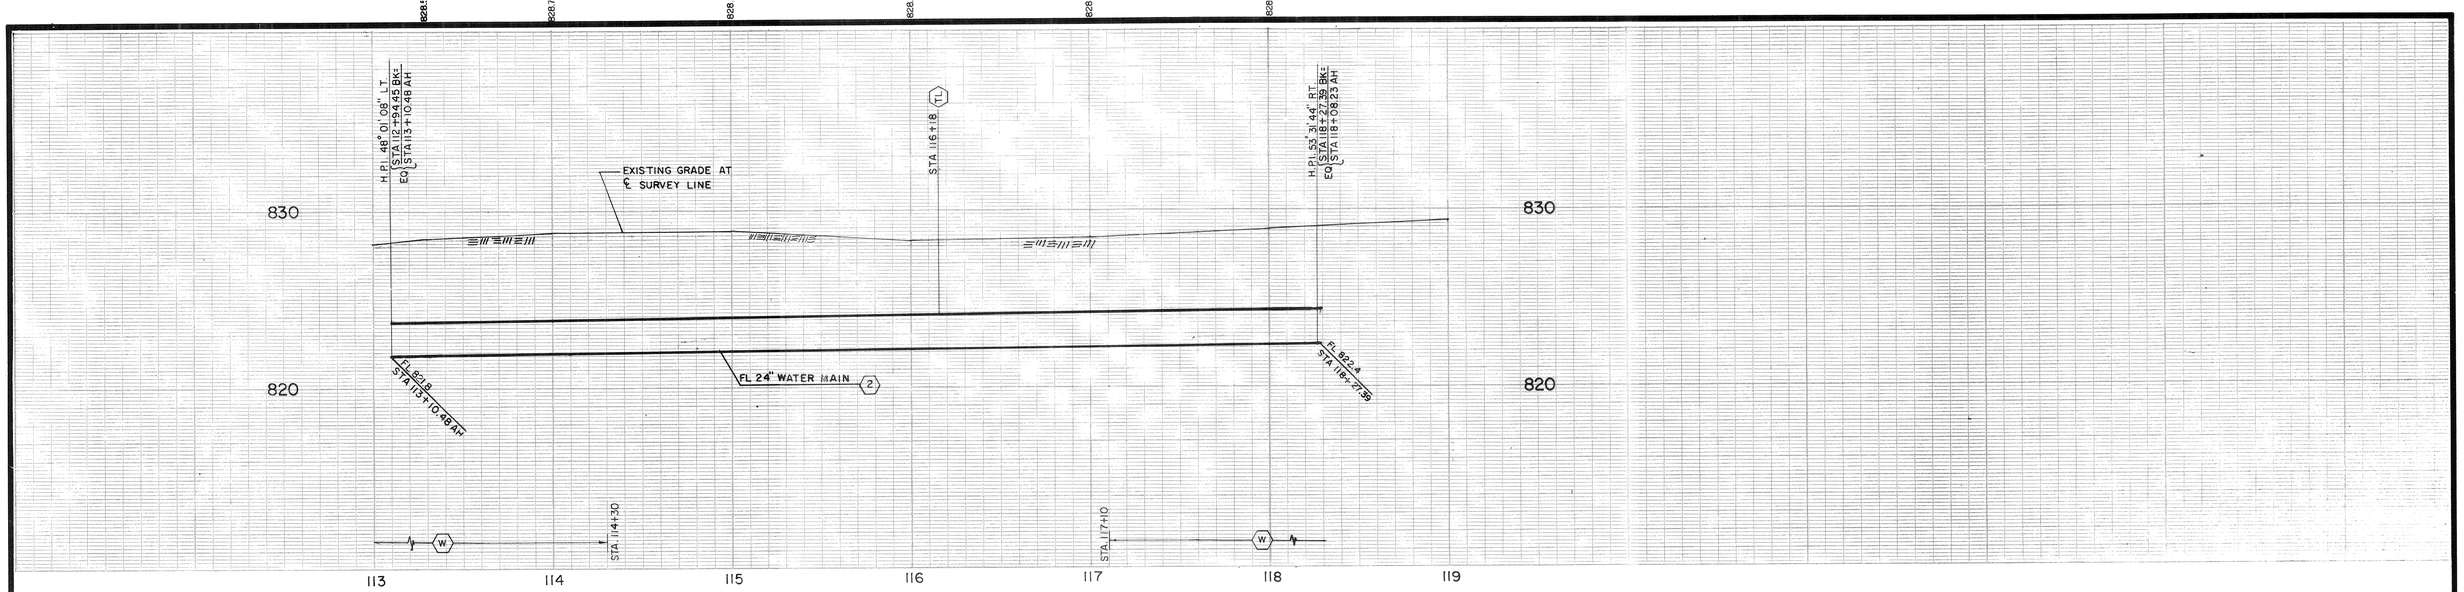

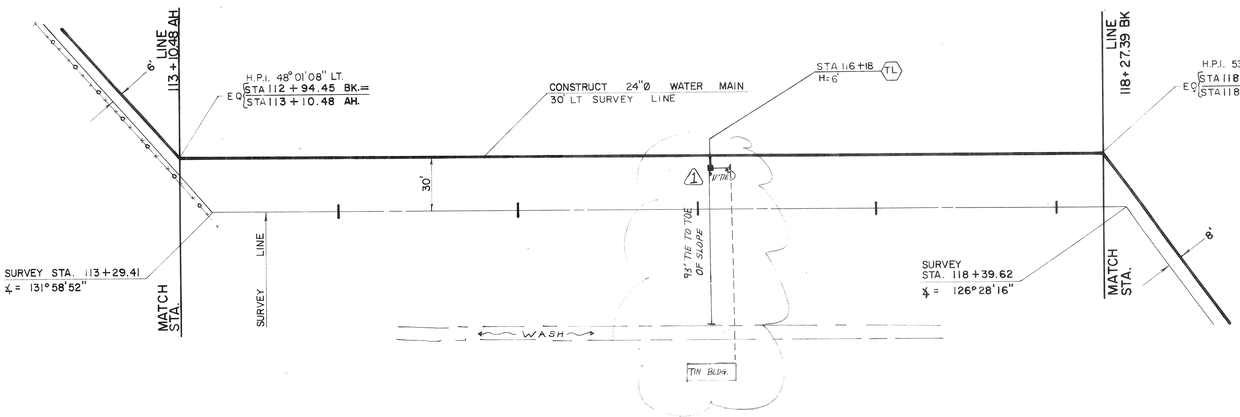

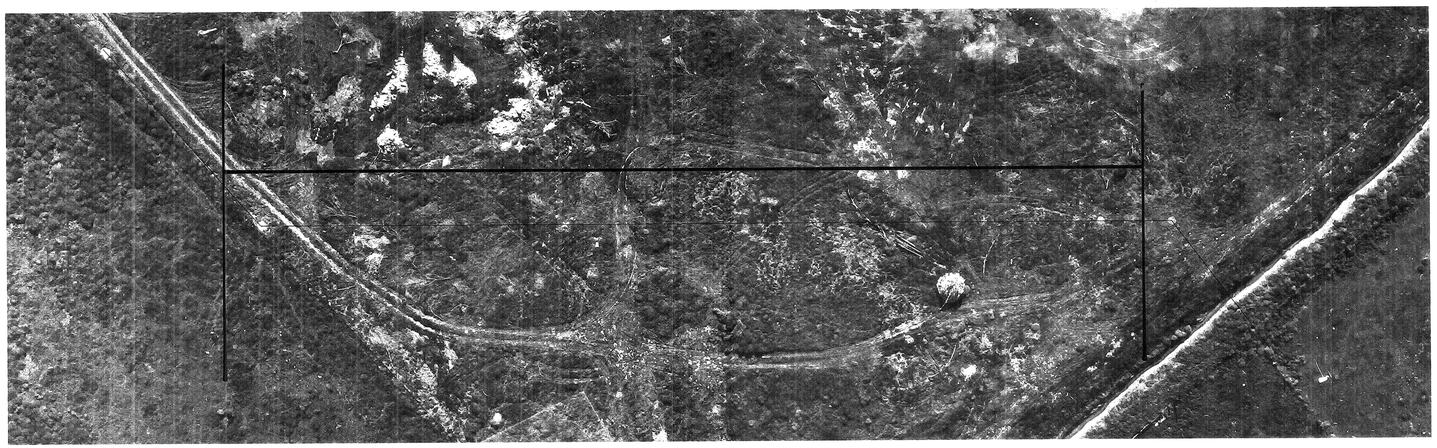

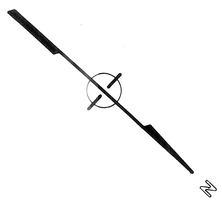

NORTH ORANGE 30" Ø T.M. PHASE II			
SCALE H— 1"= 40' V— 1"= 4'	DRAWN A. SAINT	CITY OF RIVERSIDE DEPARTMENT OF PUBLIC UTILITIES	
DATE OCT. 1981	CHECKED [illegible] 11/20/81		
1 AS-BUILT 6-4-82	JOB No 1269	APPROVED	DRAWING NO.
APPRVD REVISIONS DATE	P. B. No. -	Kaut 12/7/81	W DIV. 78-D5-1269-13

65-751-745-1269-XX843

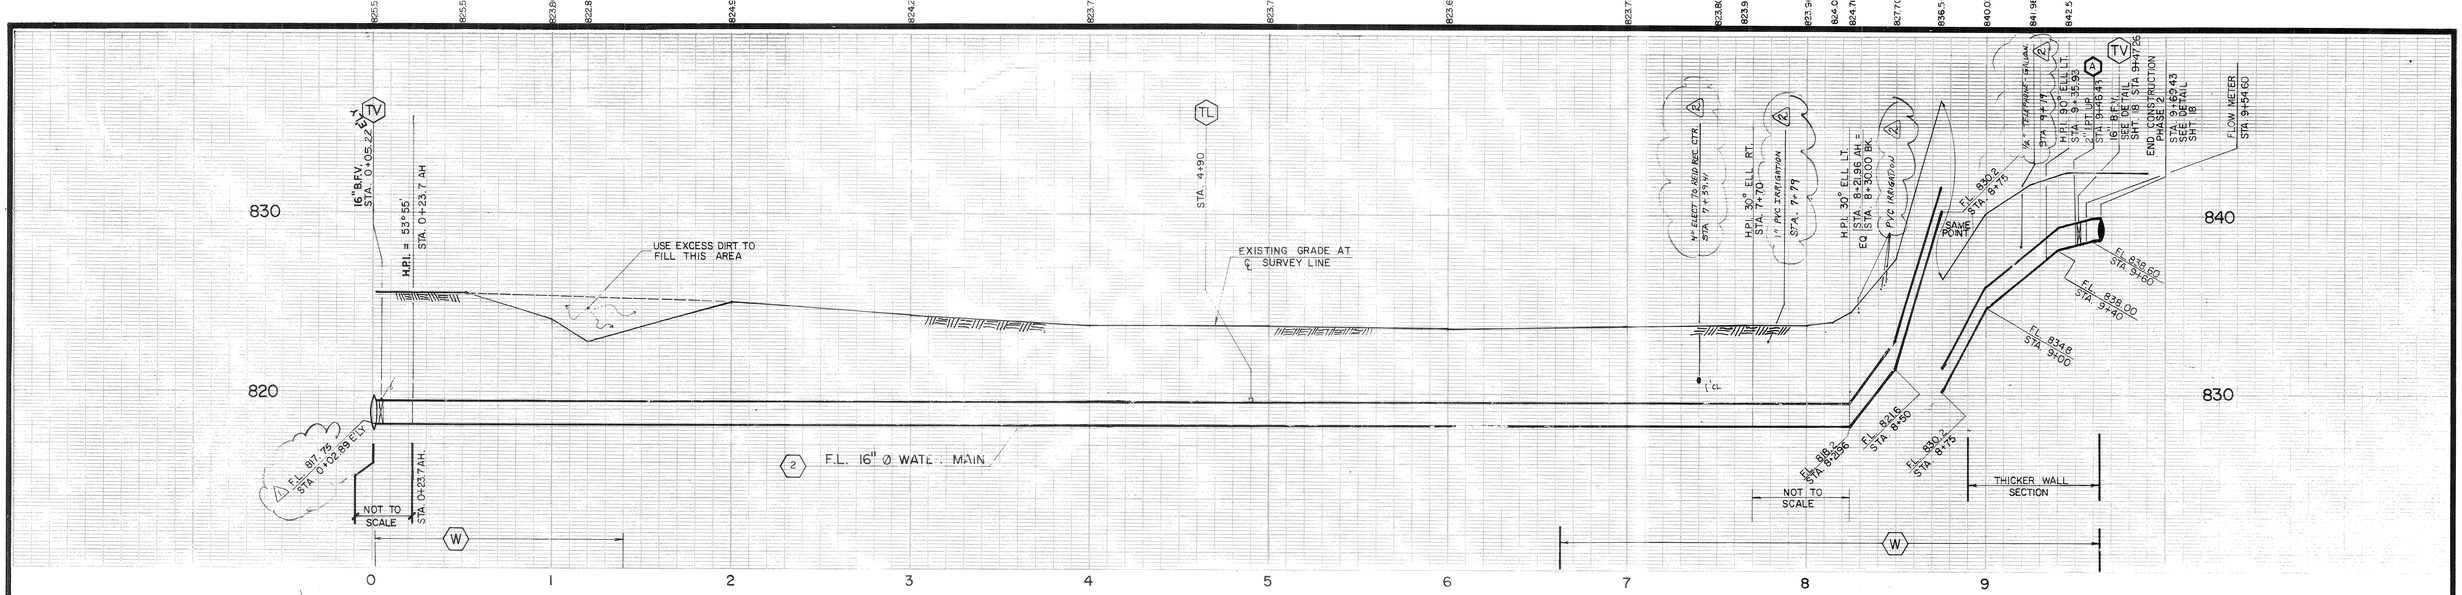

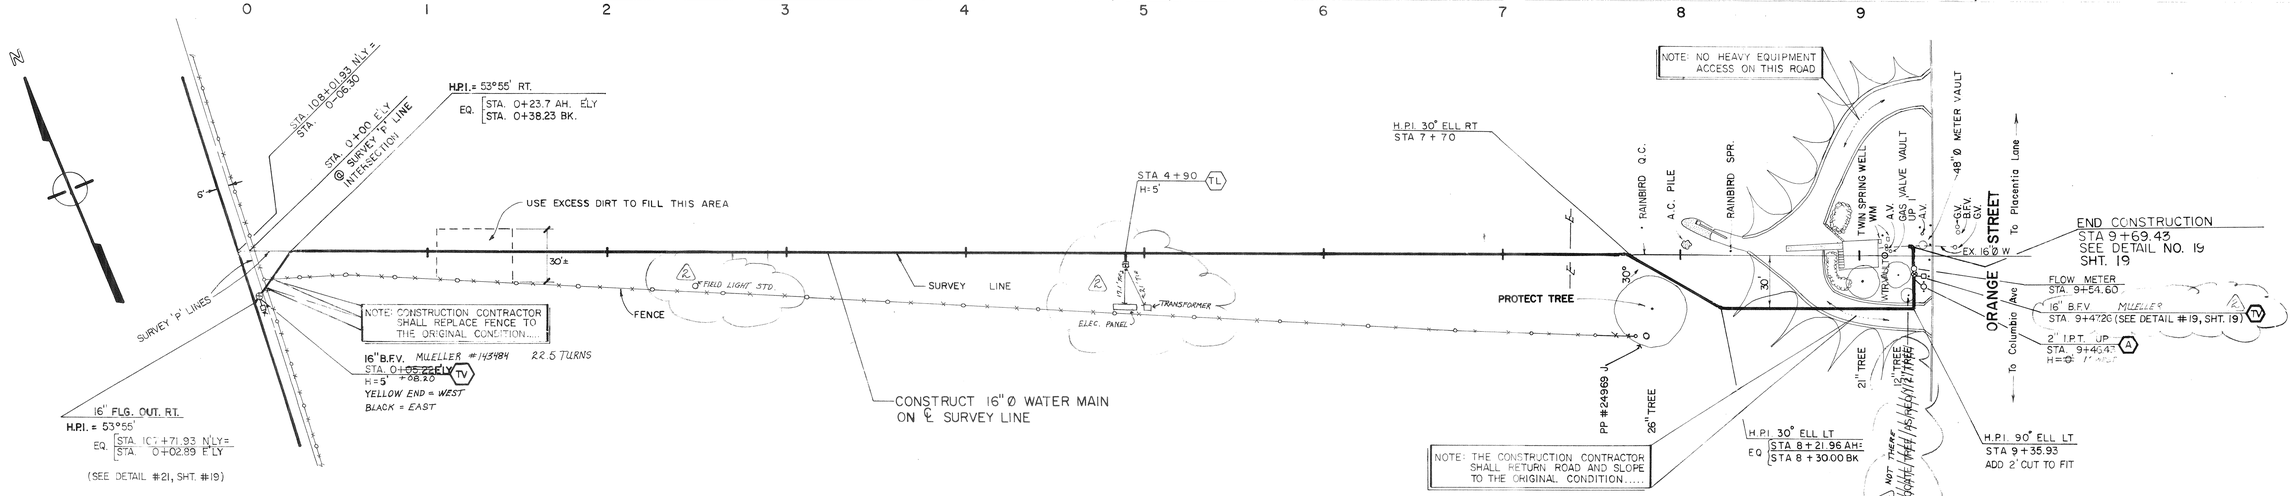

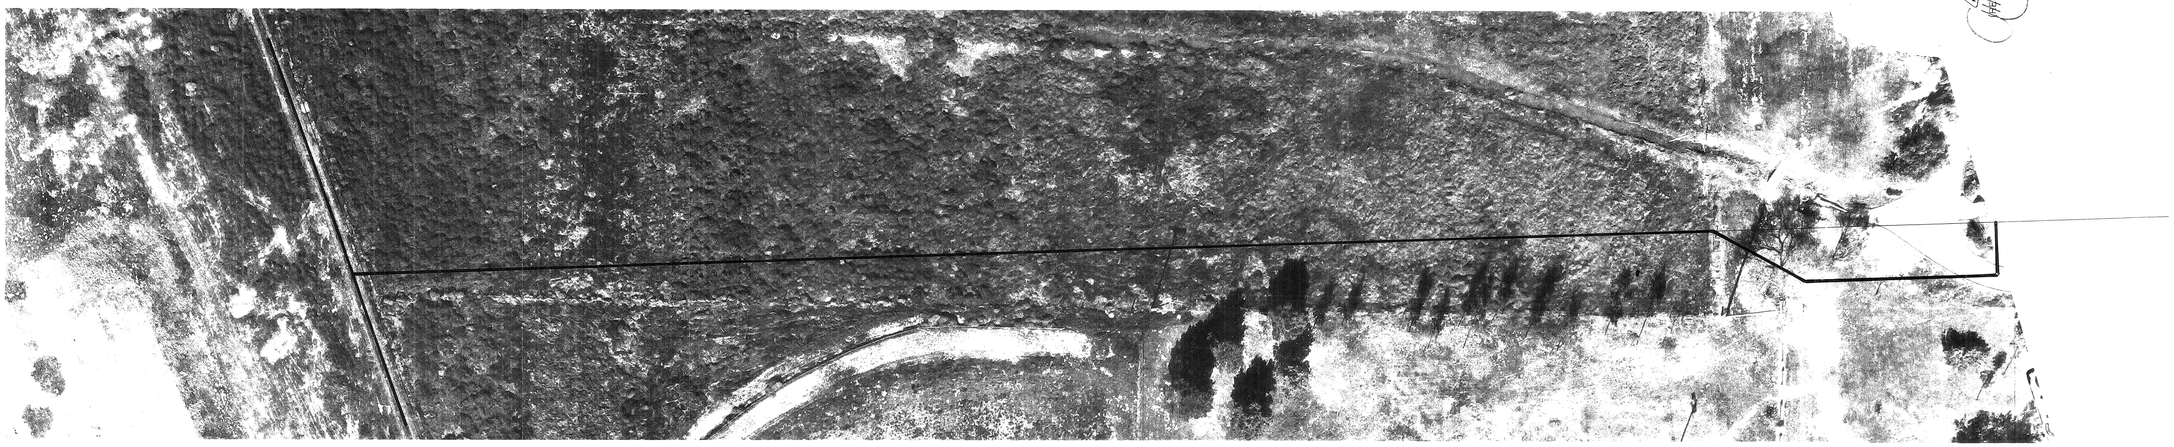

RECEIVED
DEC 07 1990
PARK & RECREATION DEPARTMENT

DEC 06 1990

NORTH ORANGE 30" Ø T.M.
PHASE II

SCALE	H--1"=40' V--1"=4'	DRAWN	A. SAINT
DATE	OCT 1981	CHECKED	[illegible] 11/20/81
JOB No	1269	APPROVED	[illegible] 12/17/81
F. U. No	-		

CITY OF RIVERSIDE
DEPARTMENT OF PUBLIC UTILITIES
DRAWING NO. W 78-D5-1269-17

2 AS-BUILT 8/82
1 CHANGE 7/29/82
APPRVD DIVISIONS DATE

65—751—745—1269—XX843