REID PARK
RECORD DRAWING
AS-BUILT TOPO

SCALE: 1"=60'

GRAPHIC SCALE

60 0 30 60 120 240

(IN FEET)
1 inch = 60 ft.

PROFESSIONAL LAND SURVEYOR
MICHAEL A. BAINE
LS 7326
EXP. 12/31/07
STATE OF CALIFORNIA

Oct. 31, 2007

MICHAEL A. BAINE, LS 7326 — DATE

LDKING
Engineers/Planners/Surveyors
2151 Convention Center Way
Suite 100
Ontario, California 91764-4464
Phone: (909) 937-0200
Fax: (909) 937-0202

CITY OF RIVERSIDE
RECORD DRAWING OF
REID PARK

Last Opened: Nov 02, 2007 – 11:06am E:\500-599\590-RiversideConst\0590-003\SHEET-01.dwg; By: Bob

GARNER ROAD

WIRE FENCE

WROUGHT IRON FENCE

CHAIN LINK FENCE

SHADE STRUCTURE

SHADE STRUCTURE

MATCHLINE - SEE SHEET 3

MATCHLINE - SEE SHEET 4

SCALE: 1"=20'

GRAPHIC SCALE

30 0 10 20 40 80

(IN FEET)
1 inch = 20 ft.

LEGEND

BFP	BACKFLOW PREVENTER
DI	DROP INLET
EPB	ELECTRIC PULLBOX
EV	ELECTRIC VAULT
FP	FOUL POLE
ICP	IRRIGATION CONTROL PANEL
ICV	IRRIGATION CONTROL VALVE
	SIGN
S	SEWER MANHOLE
S	SPRINKLER
SLPB	STREET LIGHT PULLBOX
TPB	TELEPHONE PULLBOX
WF	WATER FOUNTAIN
	WATER VALVE
	LIGHT
	LIGHT
	LIGHT
	LIGHT
	LIGHT

LDKING
Engineers/Planners/Surveyors
2151 Convention Center Way
Suite 100
Ontario, California 91764-4464
Phone: (909) 937-0200
Fax: (909) 937-0202

CITY OF RIVERSIDE
RECORD DRAWING OF
REID PARK

Last Opened: Nov 02, 2007 - 11:09am E:\500-599\590-RiversideConst\0590-003\SHEET-02.dwg: By: Bob

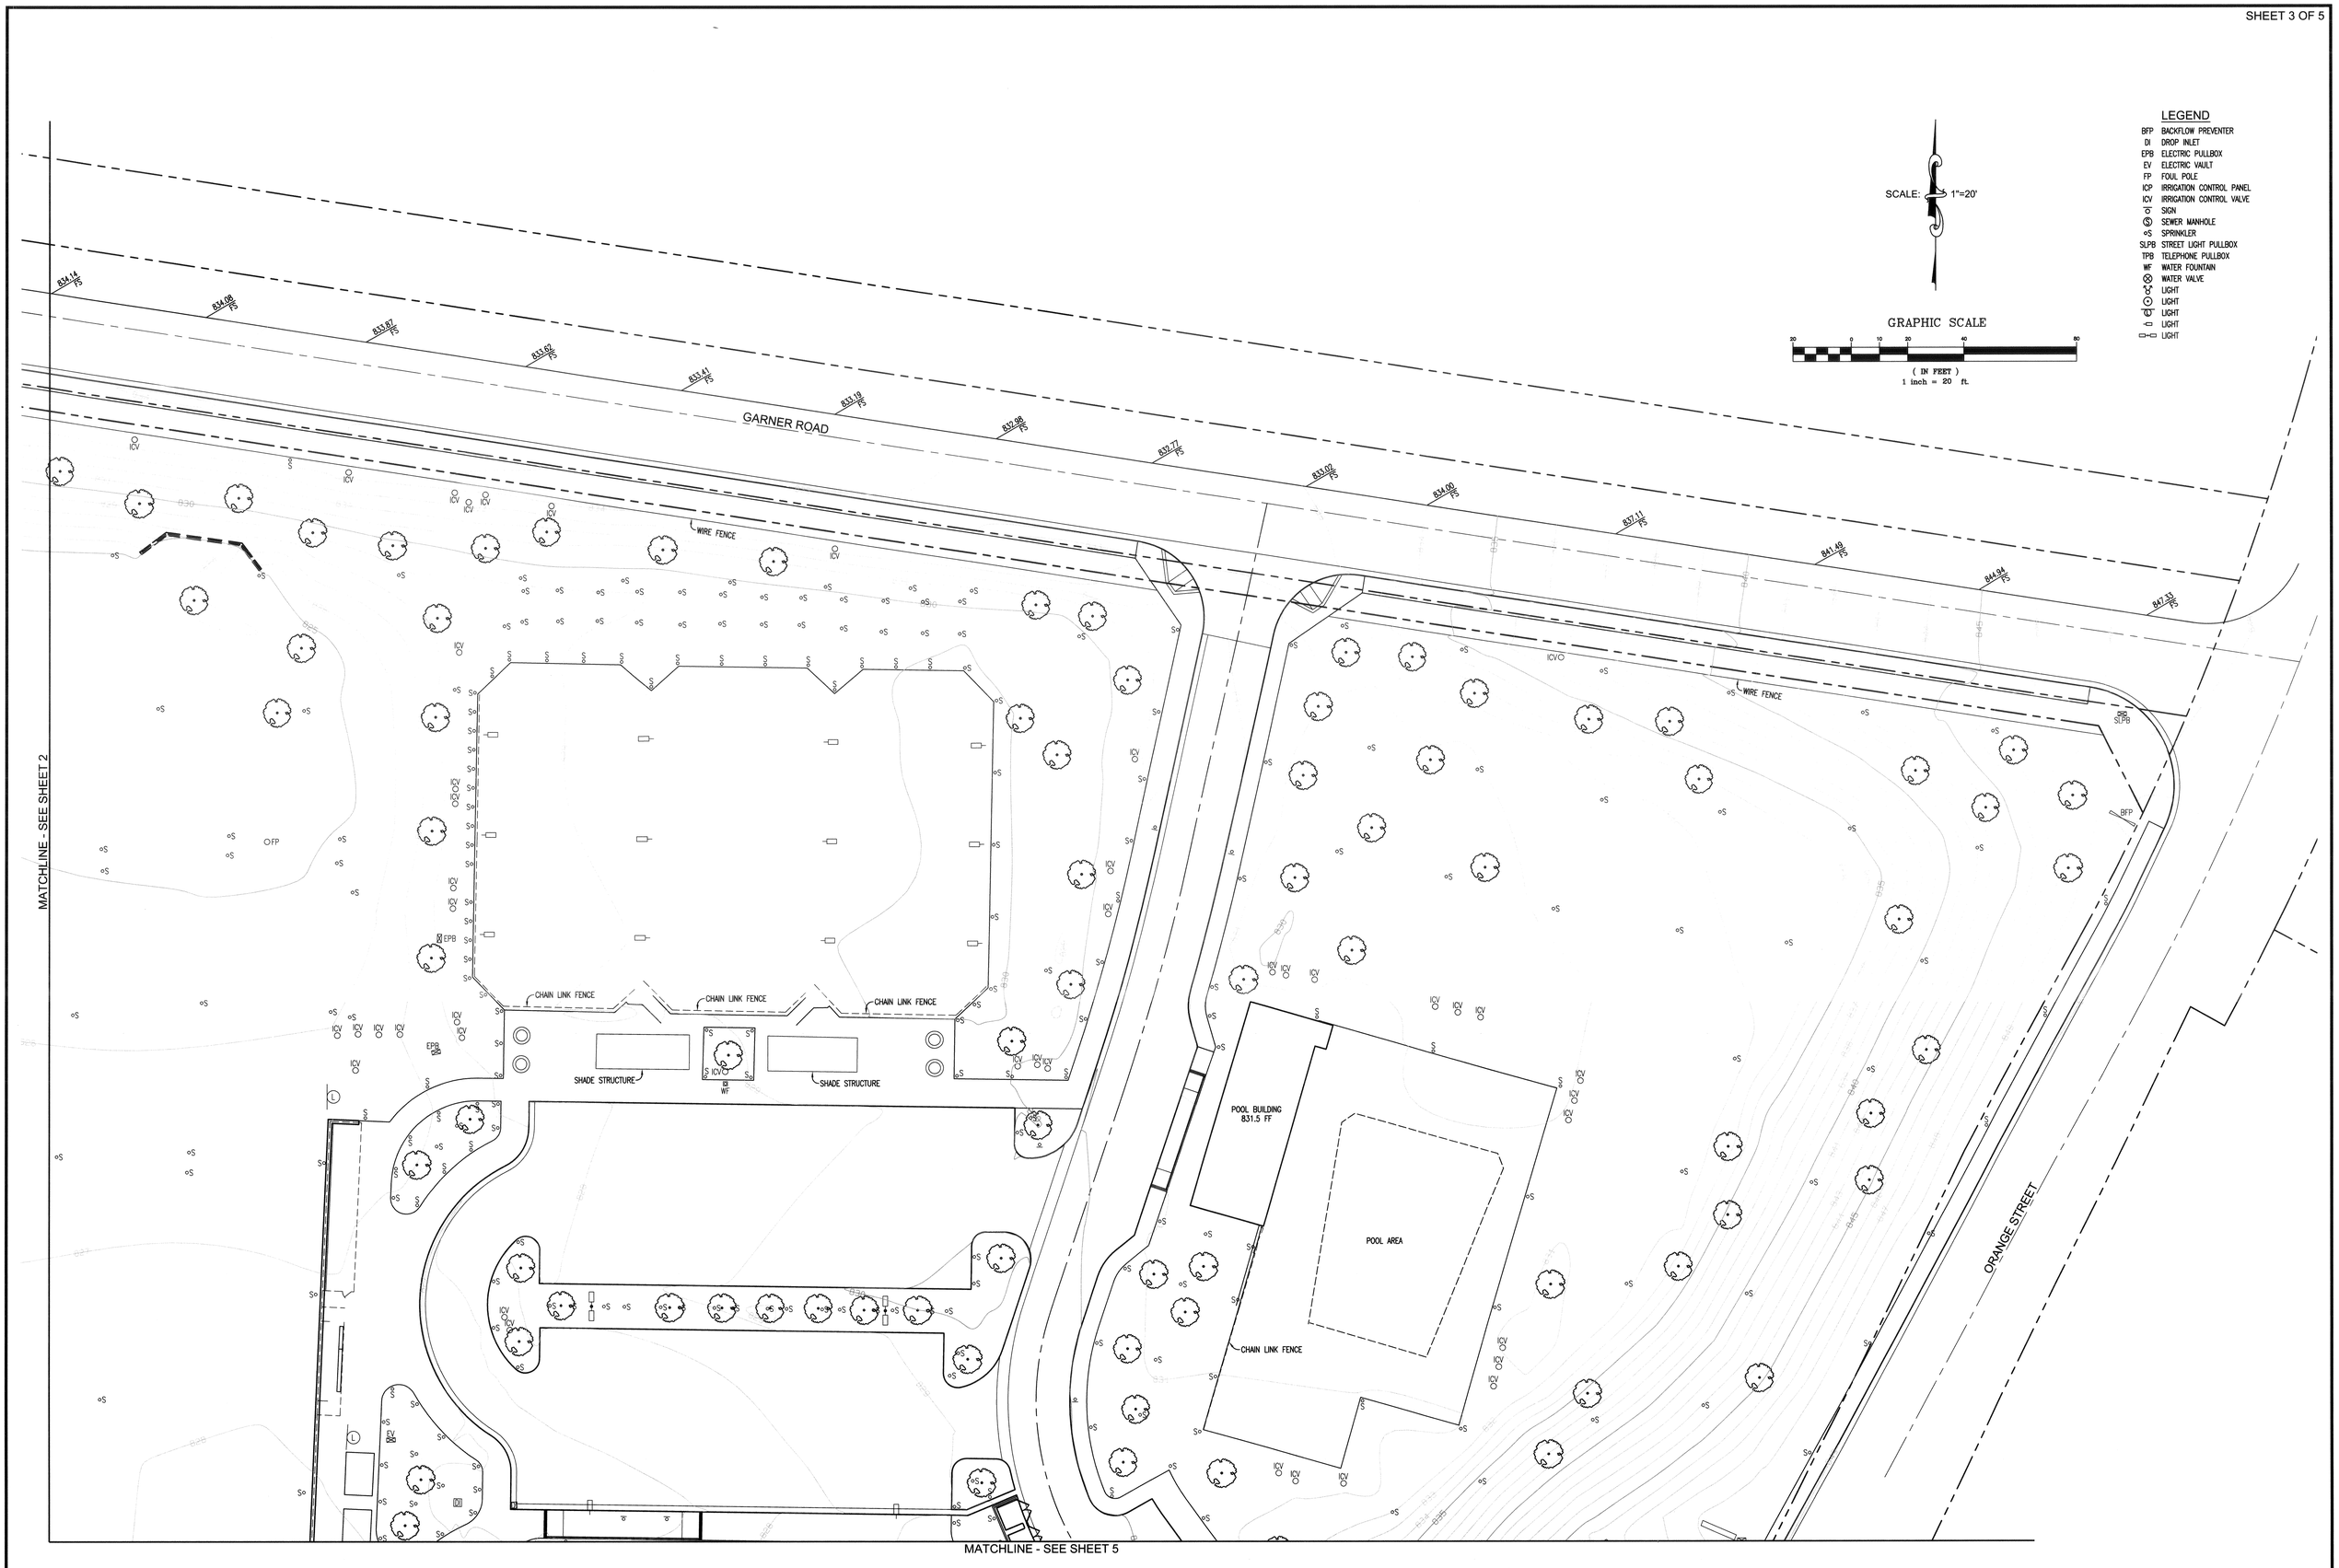

LDKING
Engineers/Planners/Surveyors
2151 Convention Center Way
Suite 100
Ontario, California 91764-4464
Phone: (909) 937-0200
Fax: (909) 937-0202

CITY OF RIVERSIDE
RECORD DRAWING OF
REID PARK

Last Opened: Nov 02, 2007 - 11:10am E:\500-599\590-RiversideConst\0590-003\SHEET-03.dwg: By: Bob

MATCHLINE - SEE SHEET 2

MATCHLINE - SEE SHEET 5

LEGEND

BFP	BACKFLOW PREVENTER
DI	DROP INLET
EPB	ELECTRIC PULLBOX
EV	ELECTRIC VAULT
FP	FOUL POLE
ICP	IRRIGATION CONTROL PANEL
ICV	IRRIGATION CONTROL VALVE
	SIGN
S	SEWER MANHOLE
S	SPRINKLER
SLPB	STREET LIGHT PULLBOX
TPB	TELEPHONE PULLBOX
WF	WATER FOUNTAIN
	WATER VALVE
	LIGHT
	LIGHT
	LIGHT
	LIGHT
	LIGHT

SCALE: 1"=20'

GRAPHIC SCALE

20 0 10 20 40 80

(IN FEET)
1 inch = 20 ft.

LDKING
Engineers/Planners/Surveyors
2151 Convention Center Way
Suite 100
Ontario, California 91764-4464
Phone: (909) 937-0200
Fax: (909) 937-0202

CITY OF RIVERSIDE
RECORD DRAWING OF
REID PARK

Last Opened: Nov 02, 2007 - 11:13am E:\500-599\590-RiversideConst\0590-003\SHEET-04.dwg: By: Bob

MATCHLINE - SEE SHEET 3

MATCHLINE - SEE SHEET 4

SHADE STRUCTURE

GREENSCREEN FENCE

ADMINISTRATION BUILDING
831.3 FF

ORANGE STREET

LEGEND

BFP	BACKFLOW PREVENTER
DI	DROP INLET
EPB	ELECTRIC PULLBOX
EV	ELECTRIC VAULT
FP	FOUL POLE
ICP	IRRIGATION CONTROL PANEL
ICV	IRRIGATION CONTROL VALVE
	SIGN
	SEWER MANHOLE
	SPRINKLER
SLPB	STREET LIGHT PULLBOX
TPB	TELEPHONE PULLBOX
WF	WATER FOUNTAIN
	WATER VALVE
	LIGHT
	LIGHT
	LIGHT
	LIGHT
	LIGHT

SCALE: 1"=20'

GRAPHIC SCALE

30 0 10 20 40 80

(IN FEET)
1 inch = 20 ft.

LDKING
Engineers/Planners/Surveyors
2151 Convention Center Way
Suite 100
Ontario, California 91764-4464
Phone: (909) 937-0200
Fax: (909) 937-0202

CITY OF RIVERSIDE
RECORD DRAWING OF
REID PARK

Last Opened: Nov 02, 2007 – 11:14am E:\500-599\590-RiversideConst\0590-003\SHEET-05.dwg: By: Bob