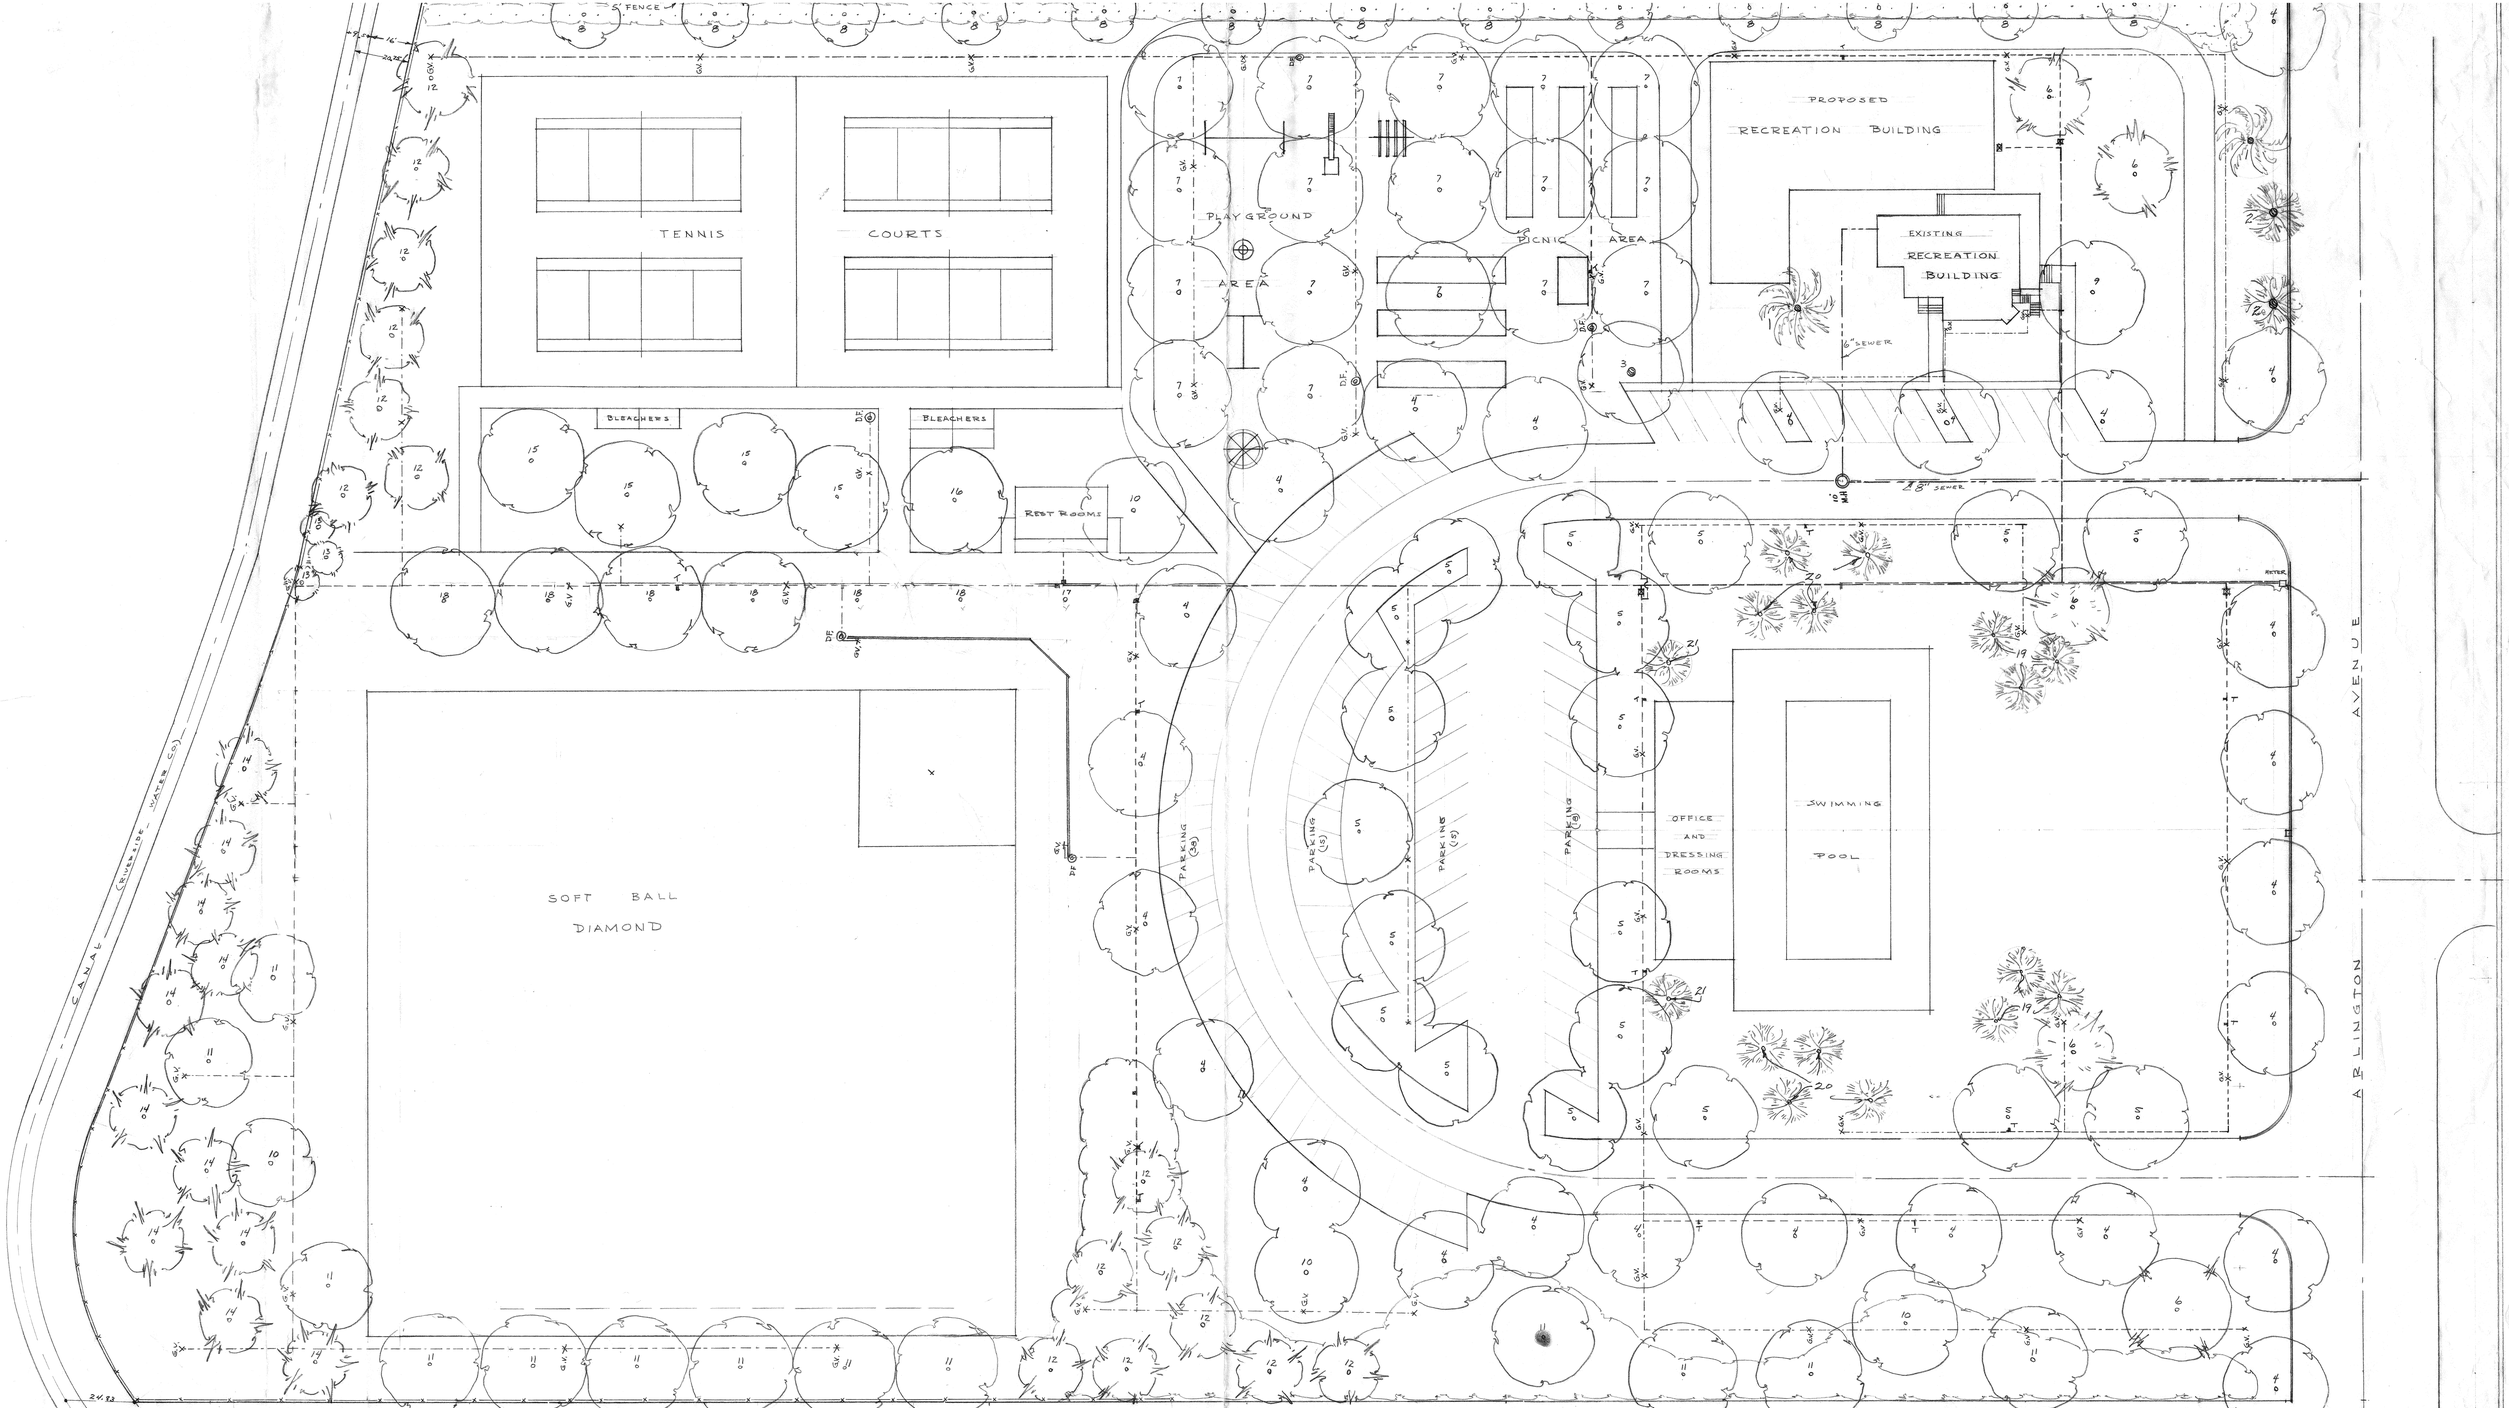

TREE PLANTING KEY

#		#		#		#	
1	2 EXIST. DATE PALM	7	17 AMERICAN ELM	13	3 ITALIAN CYPRESS	19	6 CALIF. FAN PALM
2	2 EXIST. CALIF. FAN PALM	8	13 BOTTLE TREE	14	11 ITALIAN STONE PINE	20	8 MEXICAN FAN PALM
3	1 EXIST. BOTTLE TREE	9	1 SILVER MAPLE	15	4 MAGNOLIA	21	2 GUADALUPE PALM
4	25 SHAMEL ASH	10	4 JACARANDA	16	1 TULIP TREE		
5	19 CAROB	11	13 HOLLY OAK	17	1 CAPE CHESTNUT		
6	5 DEODAR CEDAR	12	15 COAST REDWOOD	18	4 LIQUIDAMBAR		

LEGEND

- 4" WATER LINE
- 3" WATER LINE
- 2" WATER LINE
- 1" WATER LINE
- CUT OFF VALVE
- PLUGGED TEE
- X G.V. GARDEN VALVE
- D.F. DRINKING FOUNTAIN

SHAMEL PARK

RIVERSIDE CALIFORNIA

PLAN BY ELLIS L. KINDIG DECEMBER 1952 SCALE 1" = 20'

P-155-2

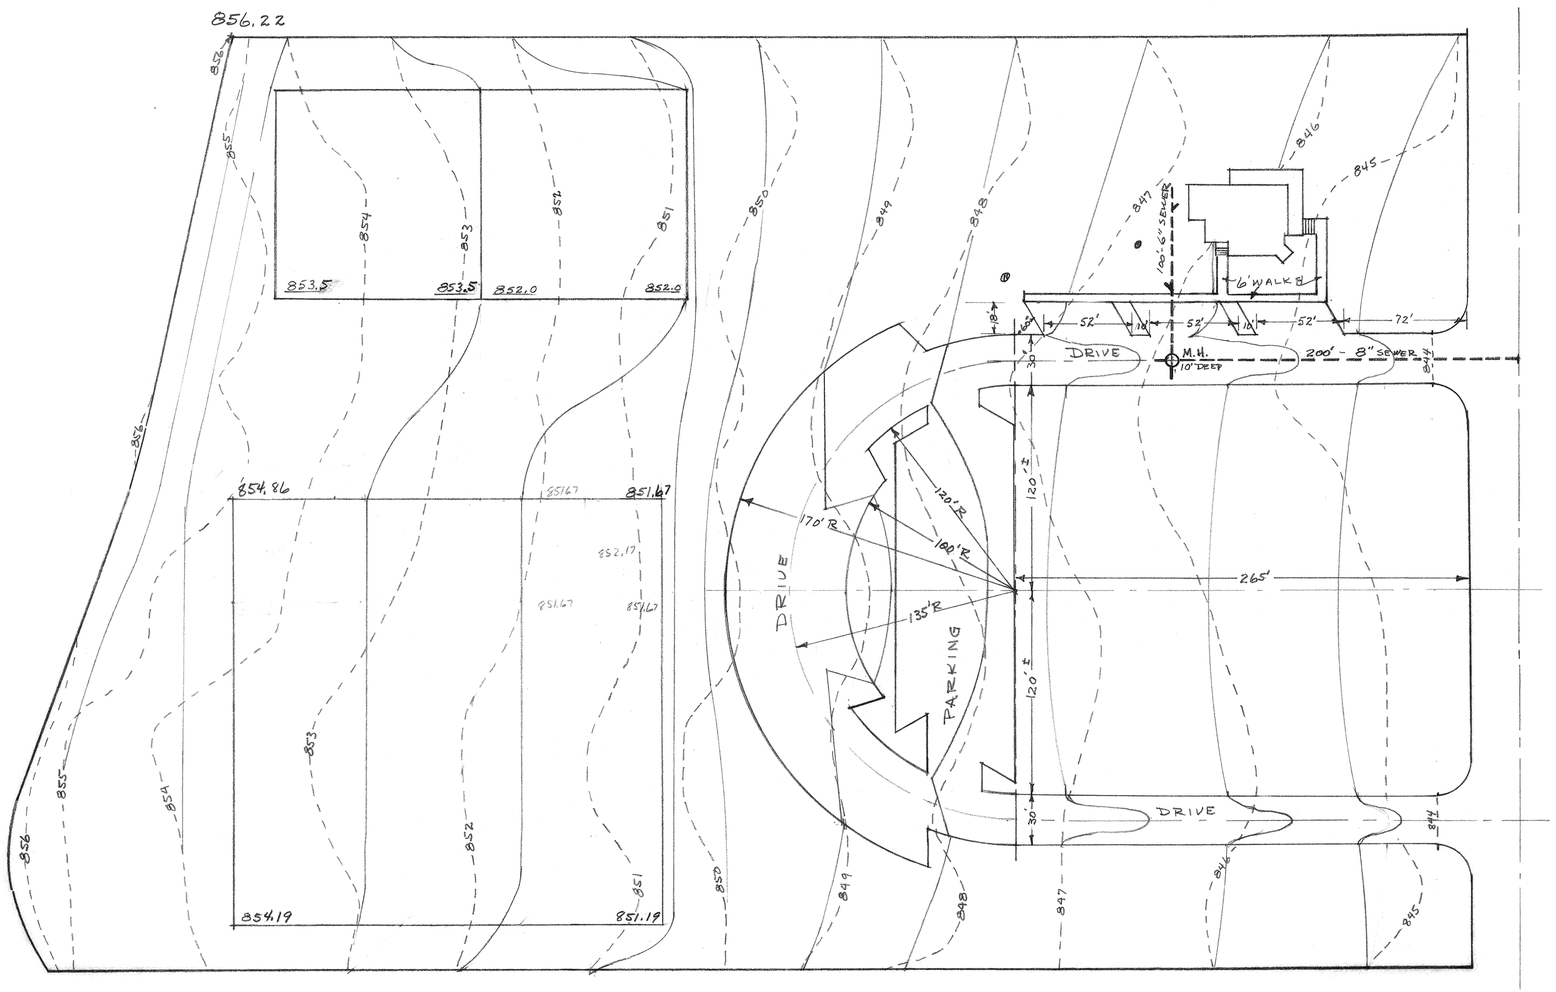

GRADING & PAVING PLAN

SHAMEL PARK

RIVERSIDE, CALIF

SCALE 1" = 50' DATE 1-30-53

DRAWING NUMBER SH4

PLAN HOLD CORPORATION • IRVINE, CALIFORNIA

REORDER BY NUMBER 07548

DRAWING NUMBER

PLAN HOLD CORPORATION • IRVINE, CALIFORNIA

REORDER BY NUMBER 07548

DRAWING NUMBER SH-06C

PLAN HOLD CORPORATION • IRVINE, CALIFORNIA

REORDER BY NUMBER 07548

P-155-3

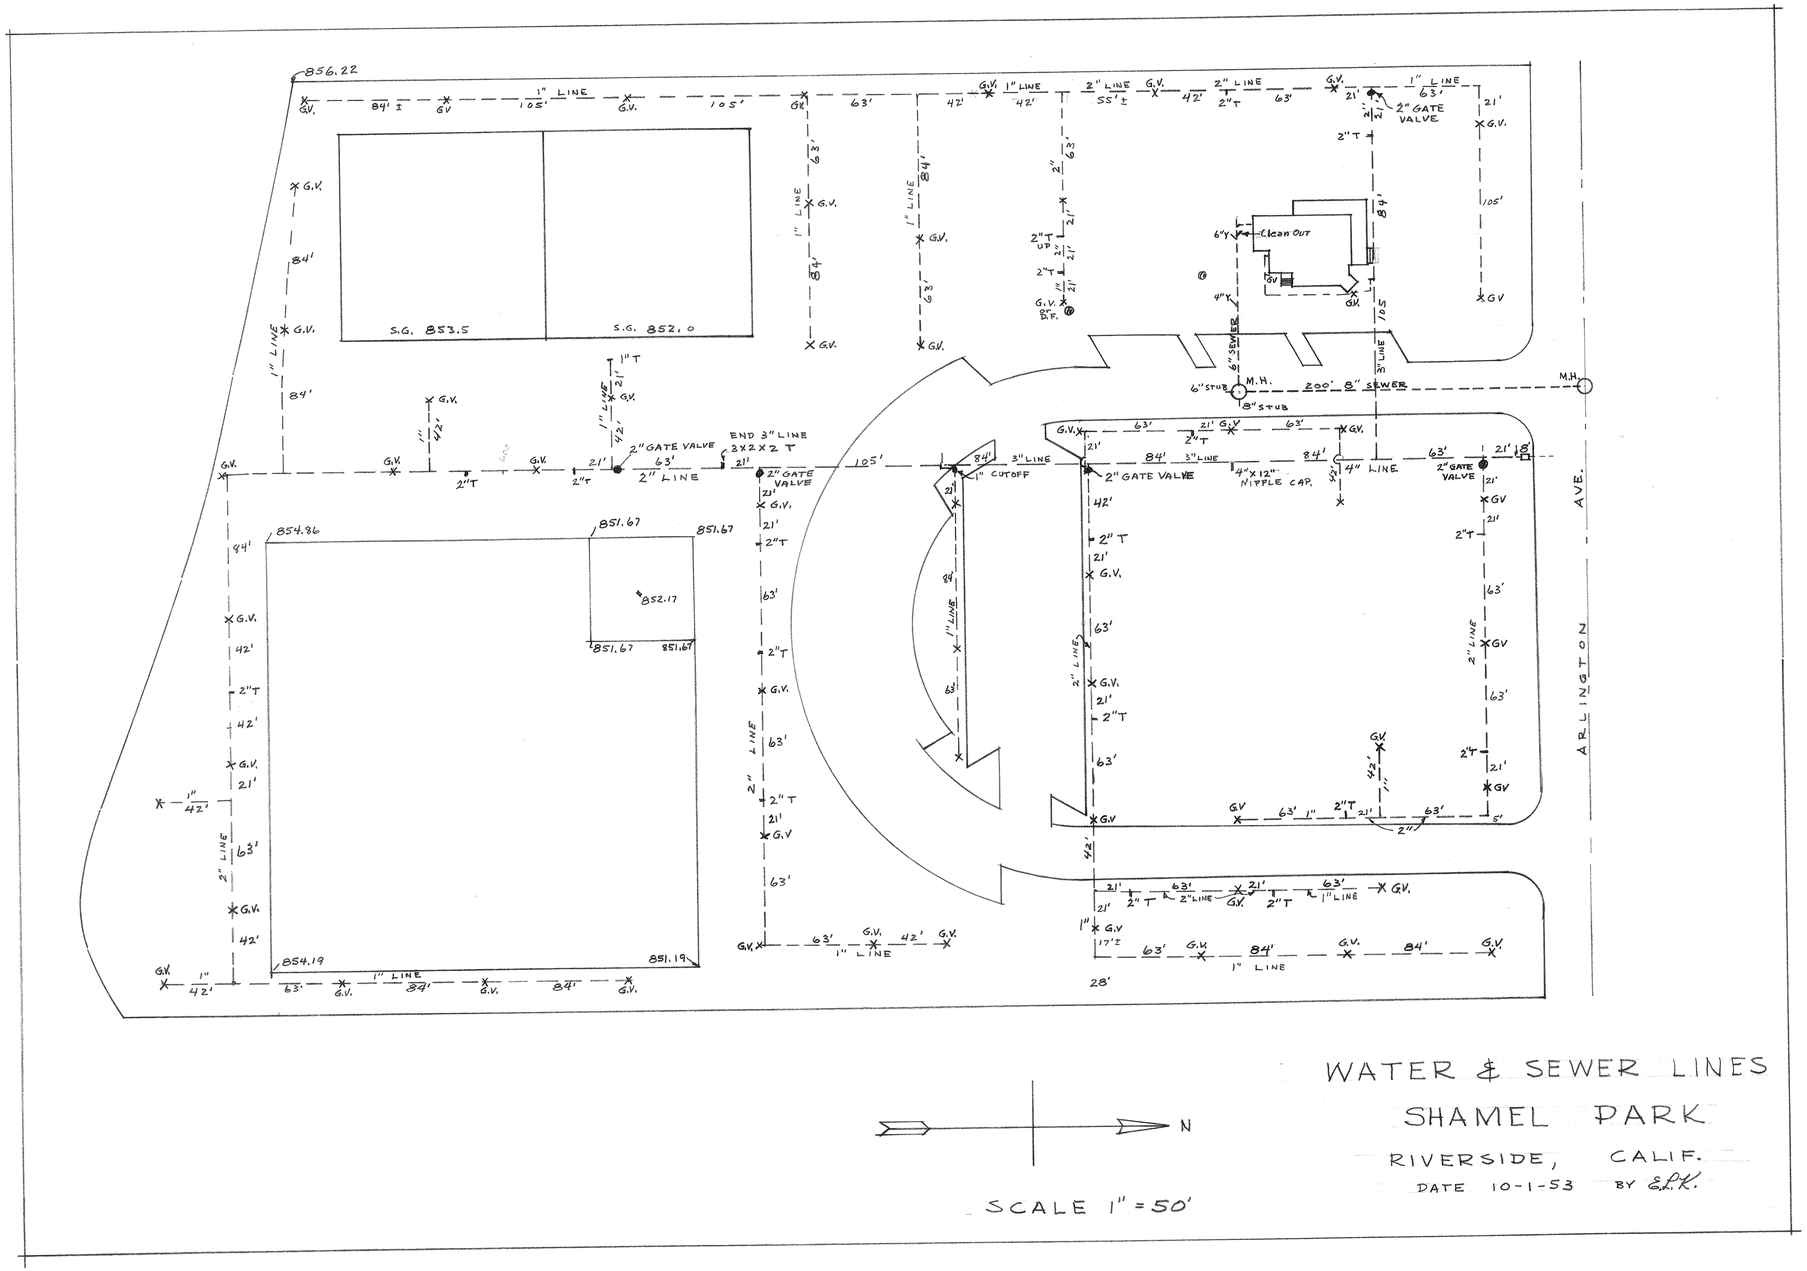

WATER & SEWER LINES

SHAMEL PARK

RIVERSIDE, CALIF.

DATE 10-1-53 BY E.P.K.

DRAWING NUMBER SHA

PLAN HOLD CORPORATION • IRVINE, CALIFORNIA

REORDER BY NUMBER 07S4R

DRAWING NUMBER

PLAN HOLD CORPORATION • IRVINE, CALIFORNIA

REORDER BY NUMBER 07S4R

DRAWING NUMBER SH-06D

PLAN HOLD CORPORATION • IRVINE, CALIFORNIA

REORDER BY NUMBER 07S4R

P-155-5

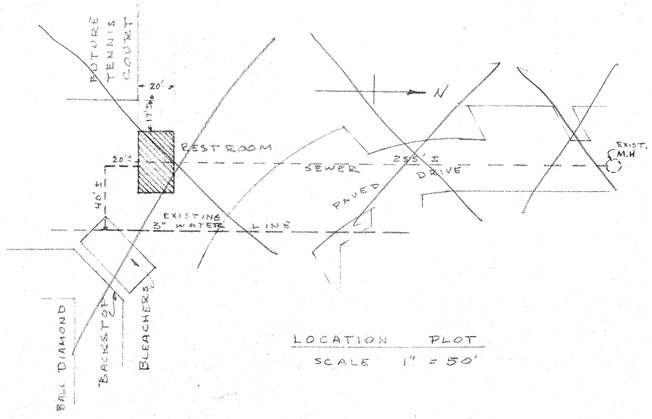

LOCATION PLOT
SCALE 1" = 50'

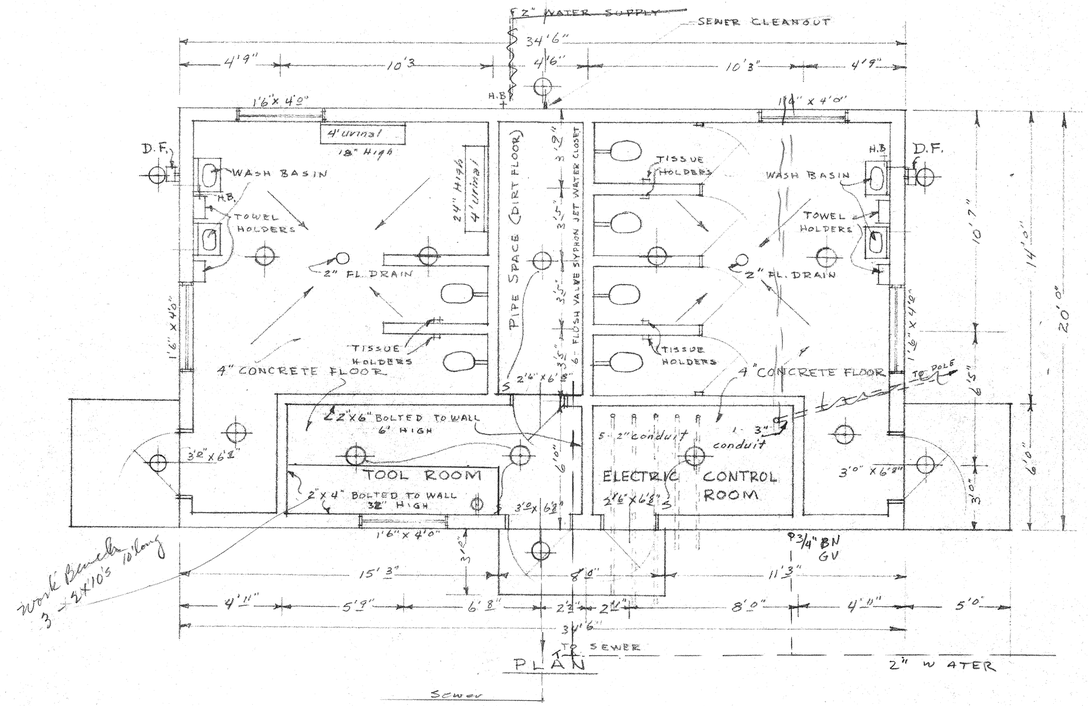

PLAN

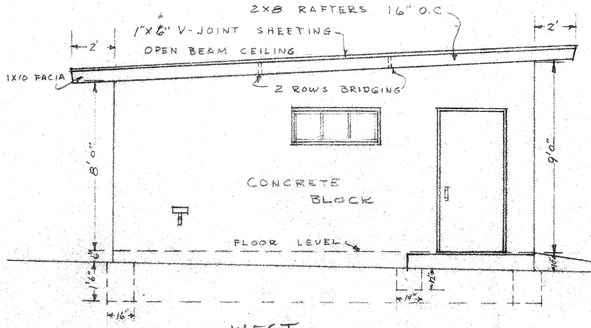

WEST ~~EAST~~ ELEVATION

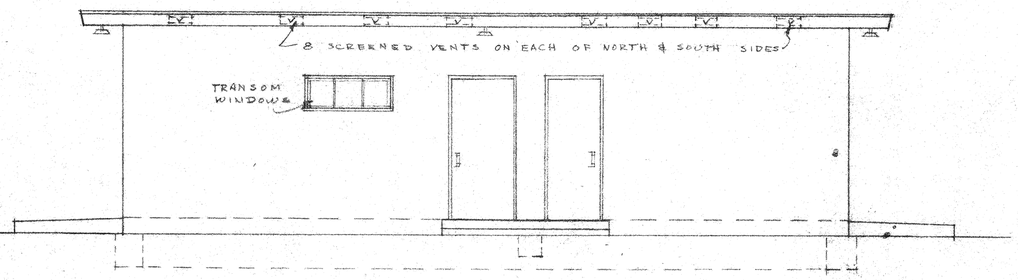

SOUTH ~~NORTH~~ ELEVATION

$7,860.00

Revised for Patterson Park

RESTROOMS & TOOLHOUSE SHAMEL PARK
SCALE 1/4" = 1'
CITY OF RIVERSIDE PARK DEPT DRAWN BY ELK MAR. 31, 1954

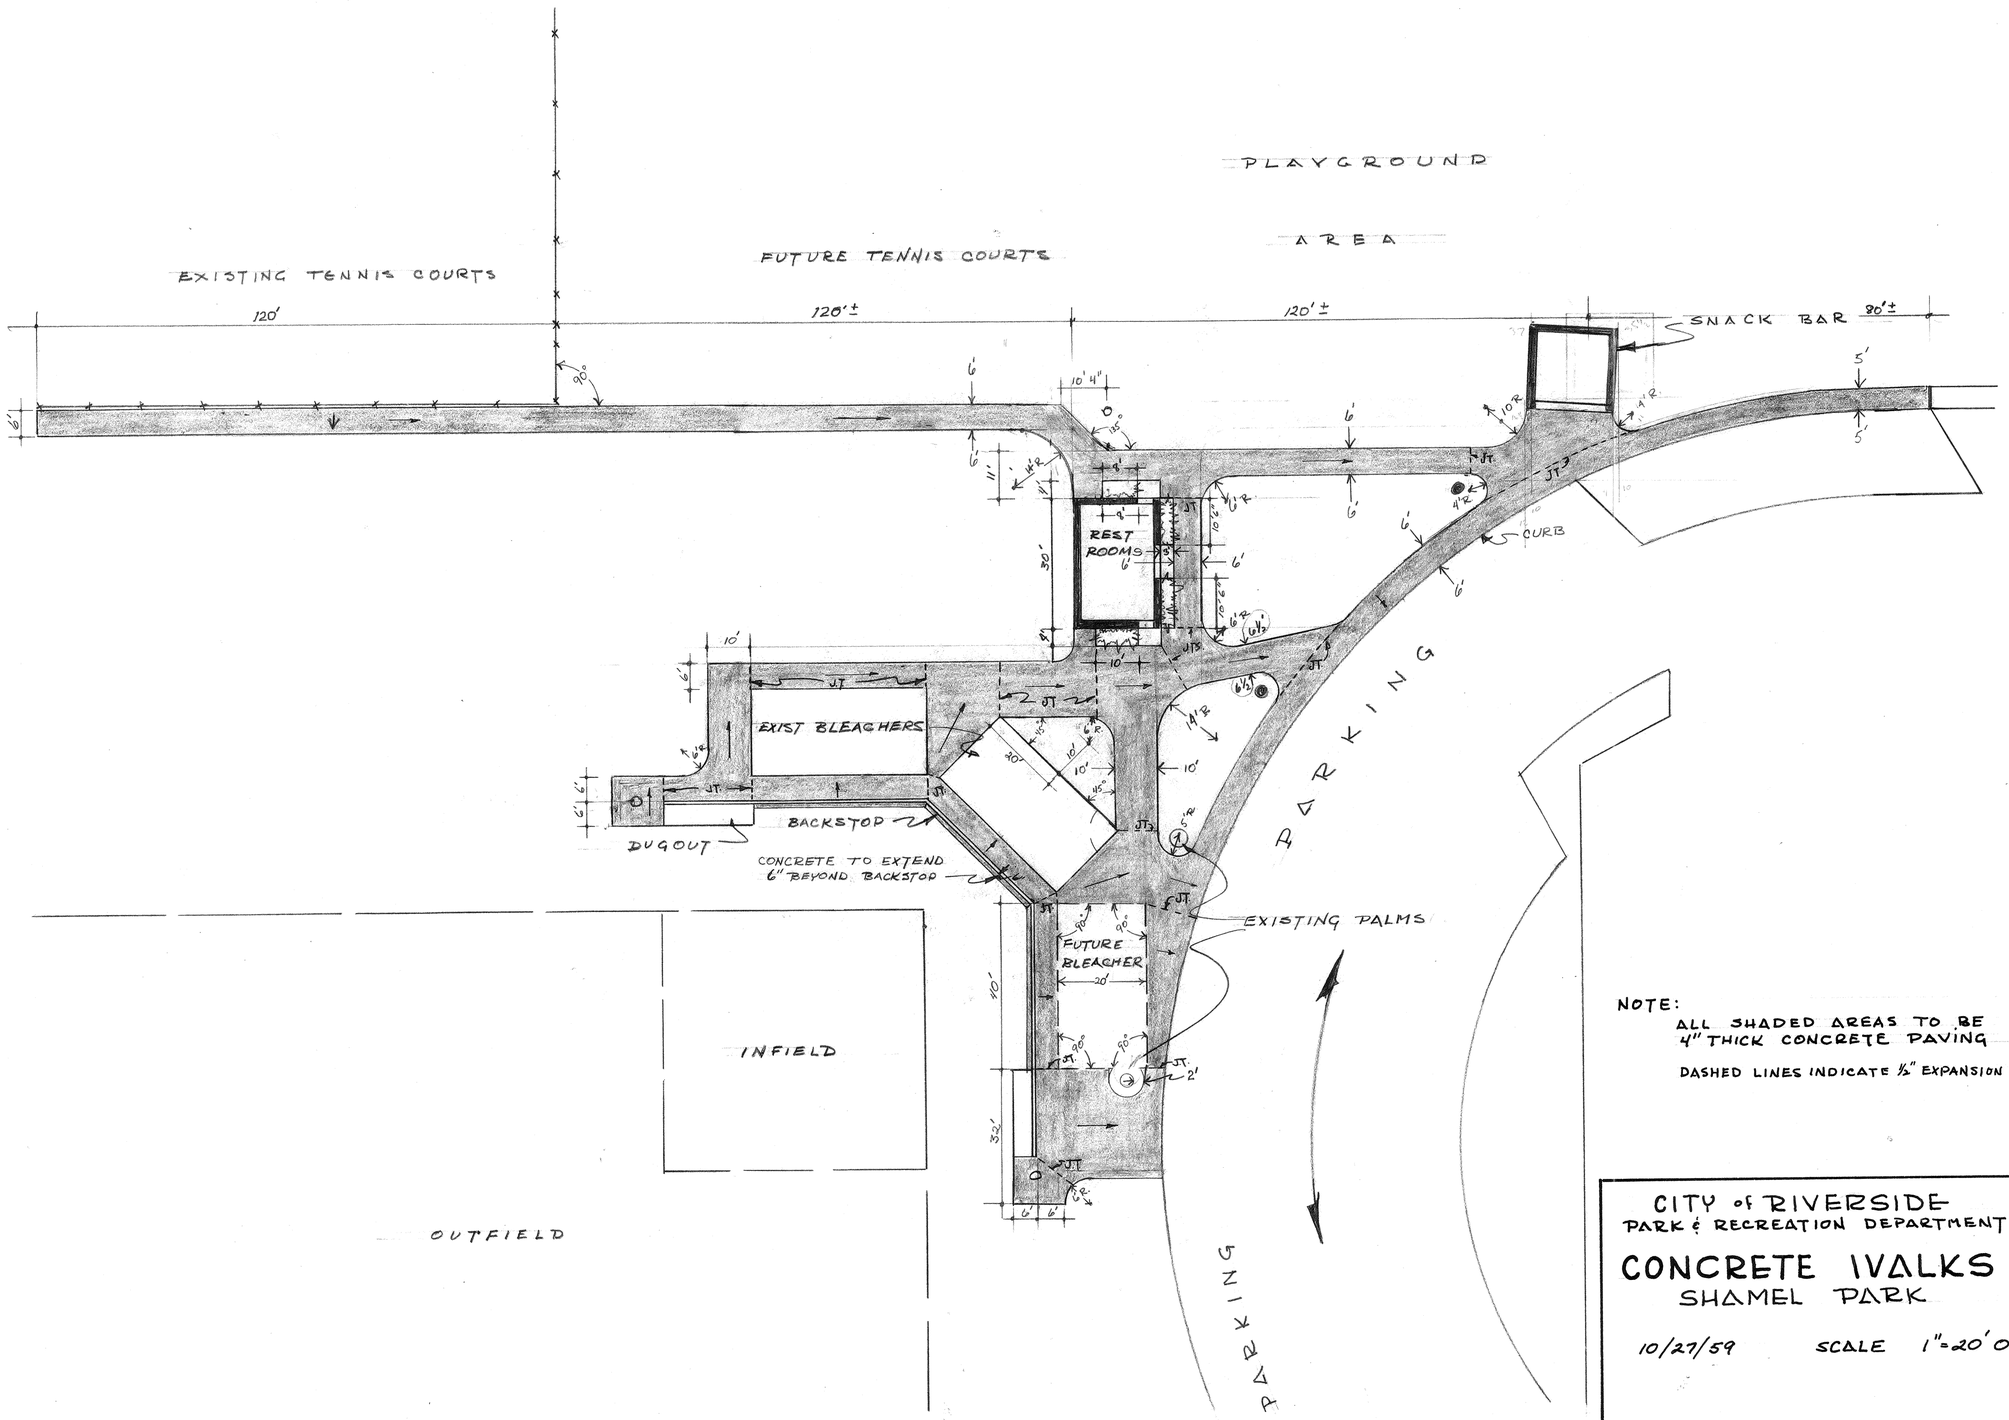

NOTE:
ALL SHADED AREAS TO BE 4" THICK CONCRETE PAVING

DASHED LINES INDICATE ½" EXPANSION JTS.

CITY of RIVERSIDE
PARK & RECREATION DEPARTMENT

CONCRETE WALKS
SHAMEL PARK

10/27/59 SCALE 1"=20'0"

DRAWING NUMBER
SHA
PLAN HOLD CORPORATION • IRVINE, CALIFORNIA
REORDER BY NUMBER 07SAR

DRAWING NUMBER
PLAN HOLD CORPORATION • IRVINE, CALIFORNIA
REORDER BY NUMBER 07SAR

DRAWING NUMBER
SH-18
PLAN HOLD CORPORATION • IRVINE, CALIFORNIA
REORDER BY NUMBER 07SAR

P-155-11

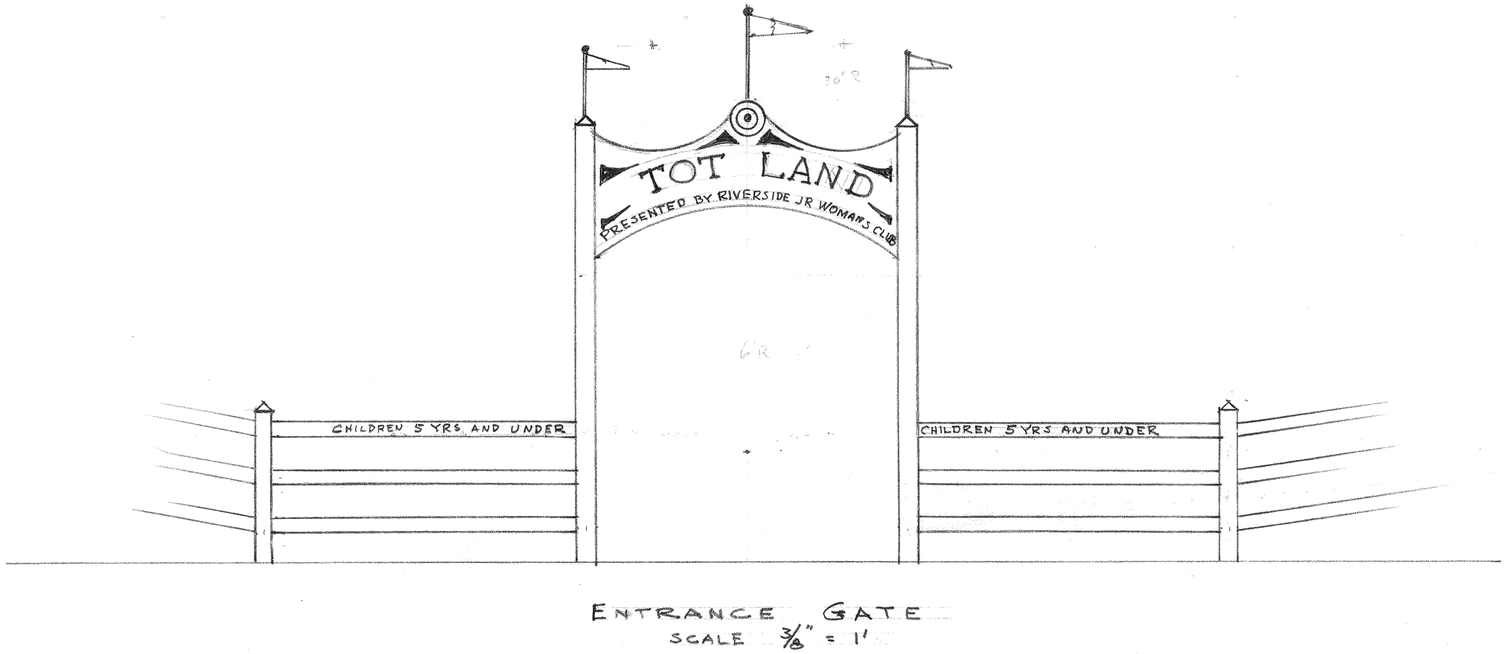

ENTRANCE GATE
SCALE 3/8" = 1'

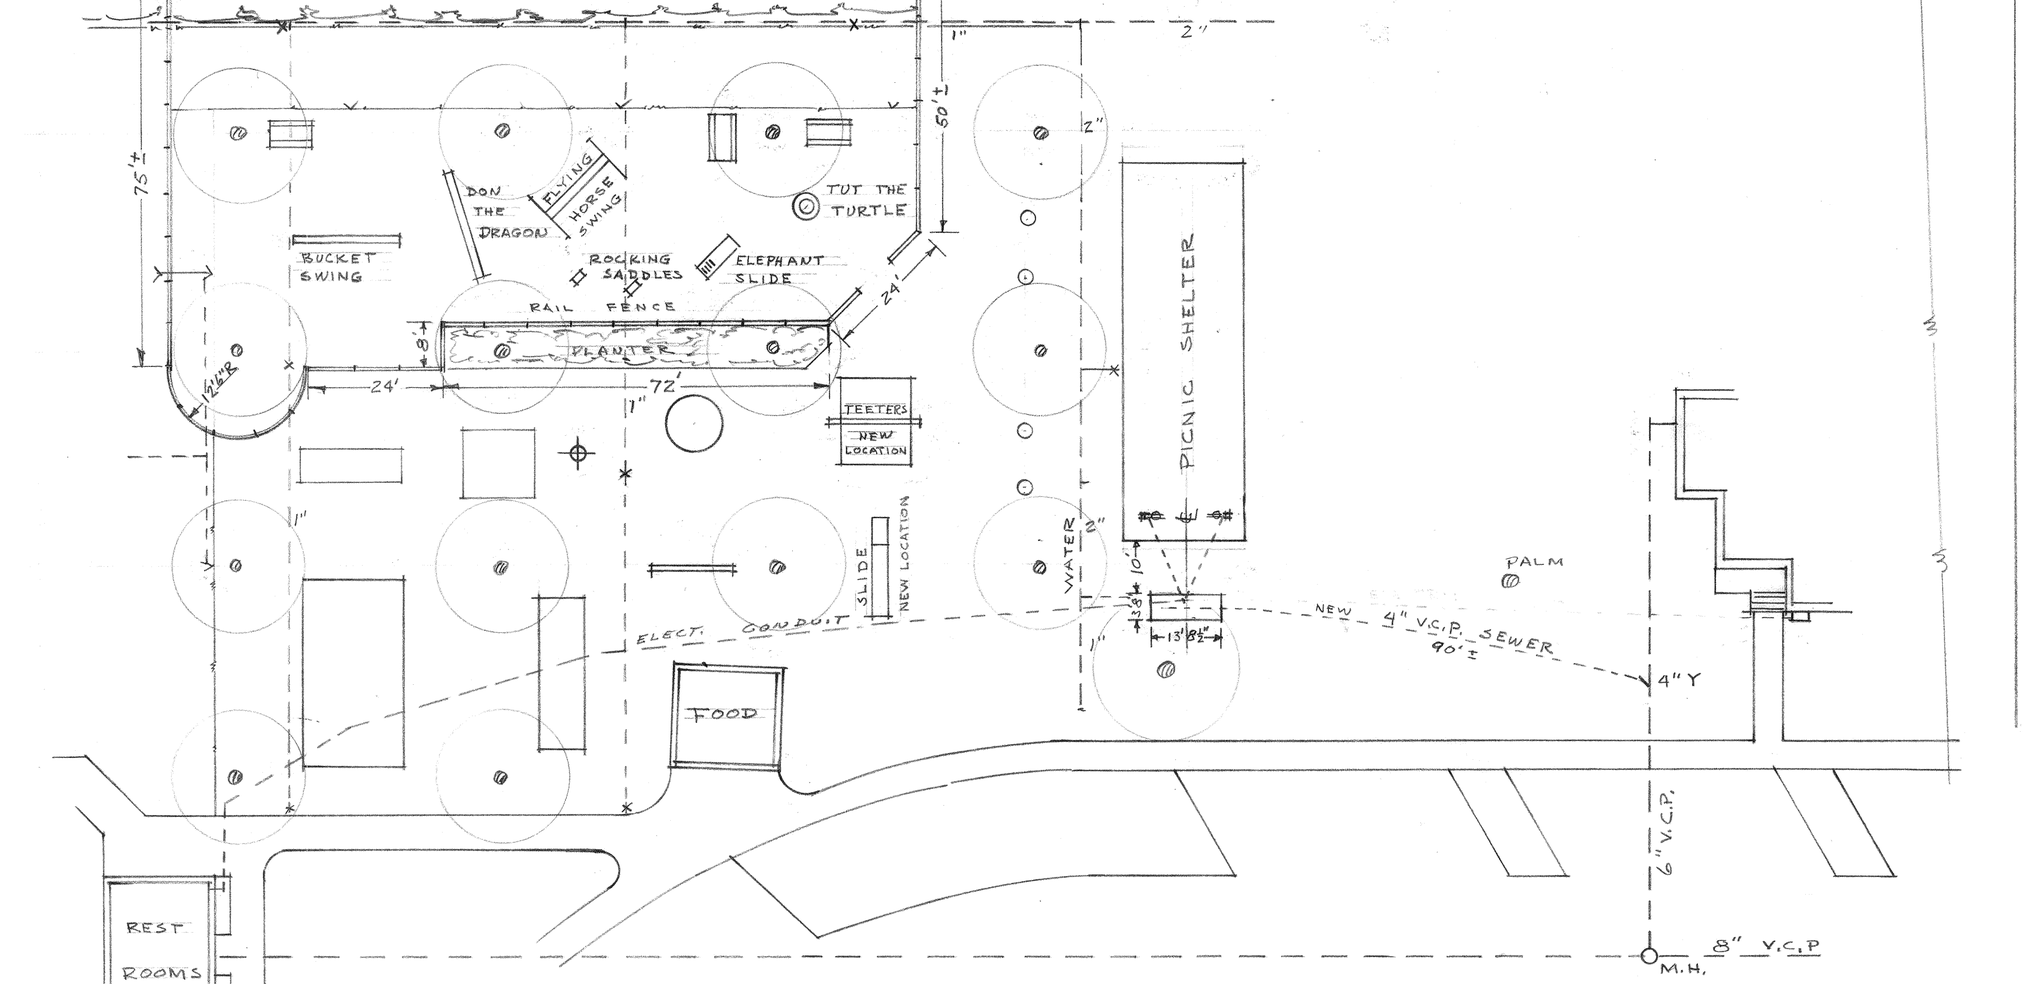

TOT LAND
SHAMEL PARK
RIVERSIDE, CALIFORNIA
1-18-63

P-155-14