NOTE

IRRIGATION SLEEVES TO BE INSTALLED @ 24" BELOW SUBGRADE ELEVATION UNDER PAVING. ELECTRICAL CONDUIT @ 36" BELOW SUBGRADE. PROVIDE A MIN. OF 12" HORIZONTAL SEPERATION BETWEEN IRRIGATION AND ELECTRICAL CONDUITS.

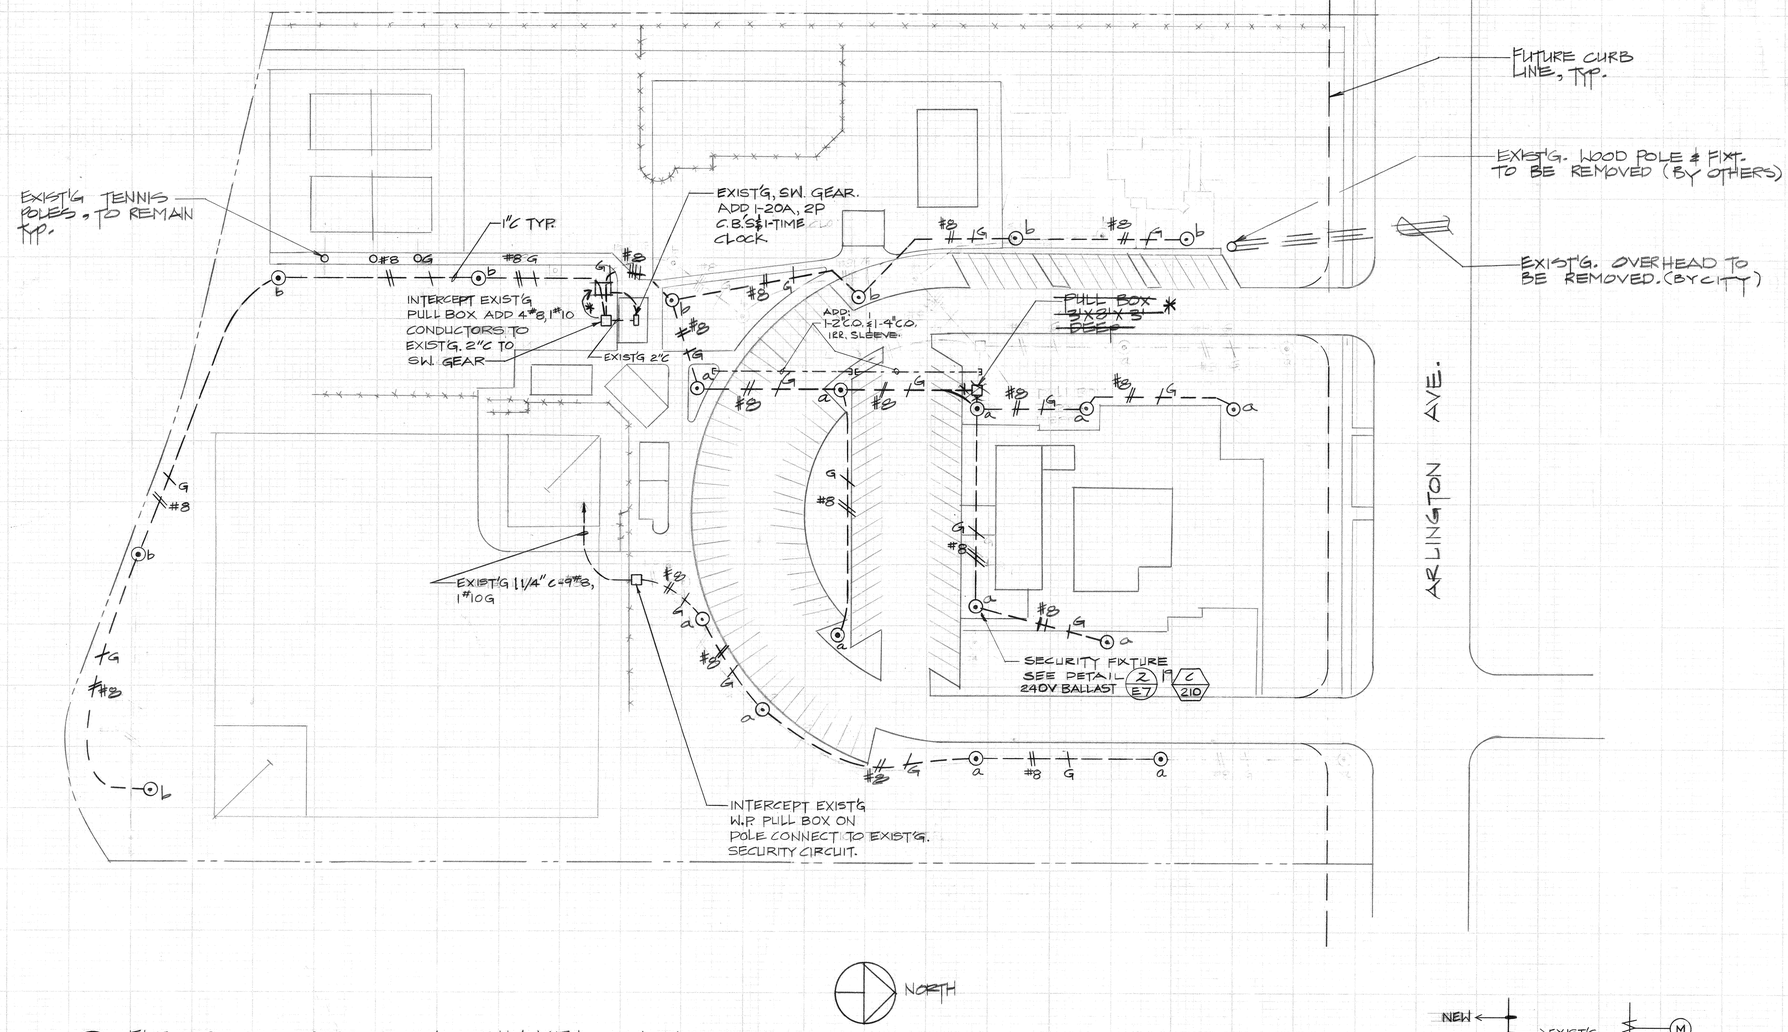

A/— ELECTRICAL SITE PLAN, SHAMEL PARK

SCALE: 1" = 40'-0"

NOTES:

1. FINAL LIGHT STANDARD LOCATIONS TO BE VERIFIED AND APPROVED IN THE FIELD BY THE PARKS DEPT. REPRESENTATIVE PRIOR TO INSTALLATION/DIGGING FOR FOOTINGS.
2. CONDUIT ROUTING IN PROXIMITY TO EXISTING TREES SHALL BE AS APPROVED BY THE CITY.

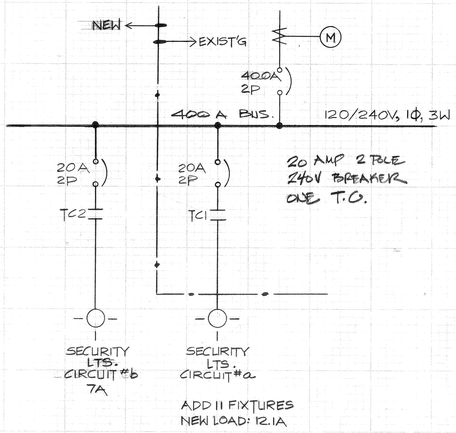

1/E5 SINGLE-LINE DIAGRAM

* "AS-BUILT"

MULLEN & ASSOCIATES INC.
CONSULTING ENGINEERS
1940 N. TUSTIN AVE., SUITE 113
ORANGE, CALIFORNIA 92665/714-637-6621

REGISTERED PROFESSIONAL ENGINEER 5-25-8 LARRY D. MULLEN E 8279 ELECTRICAL STATE OF CALIFORNIA

RIVERSIDE PARK LIGHTING
CITY OF RIVERSIDE

SHAMEL PARK
ELECTRICAL PLAN

JOB # 8072

REVISIONS

DATE: 1980

SHEET E1 OF 2

PLAN # P1010