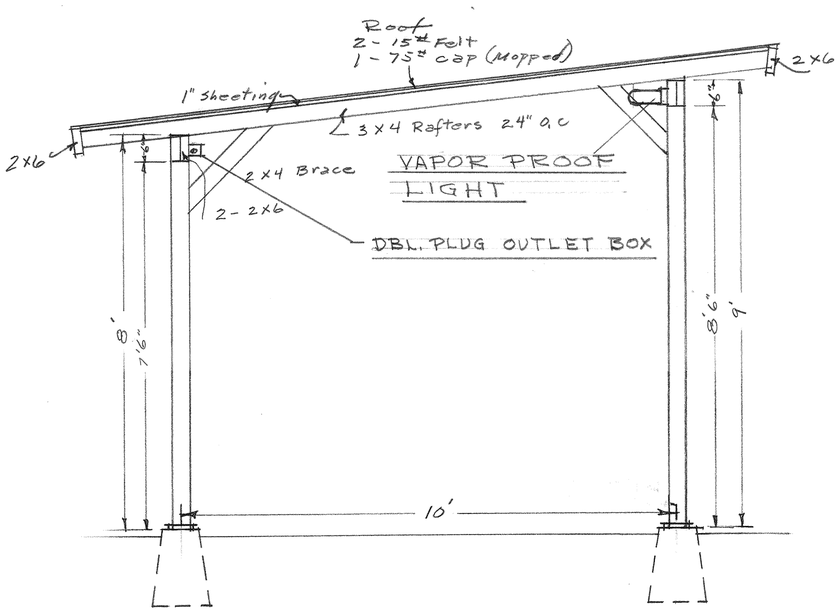

SECTION
SCALE 1/2" = 1'

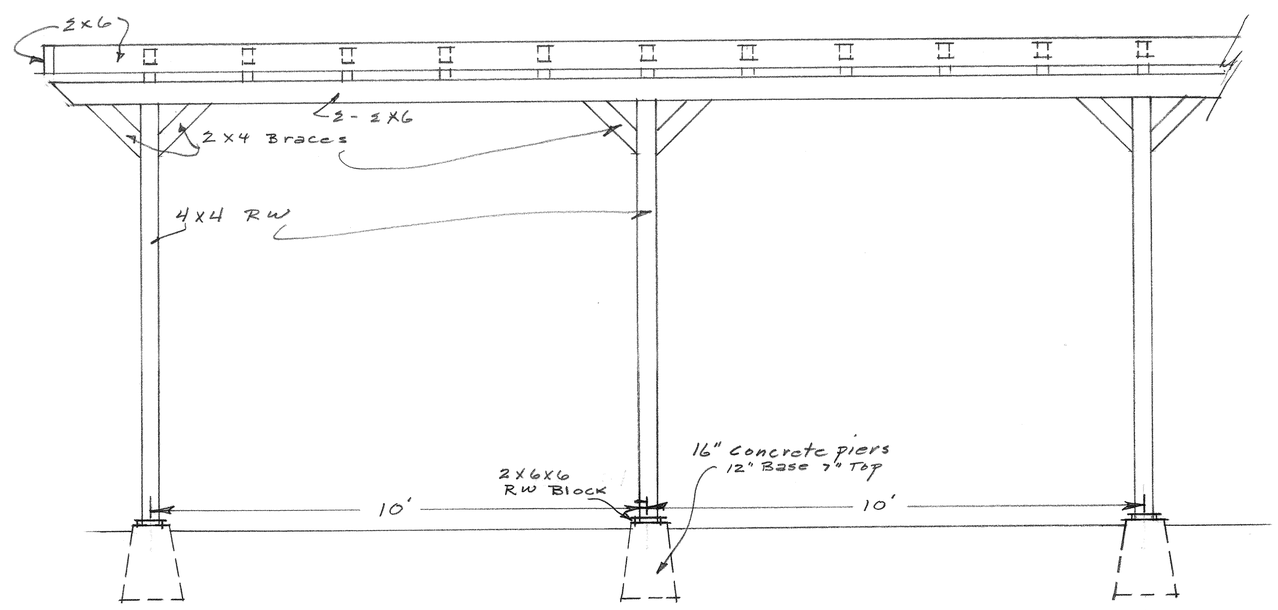

ELEVATION
SCALE 1/2" = 1'

LEGEND

VAPOR PROOF LIGHT, WITH GUARD COMPLETE W/60W. LAMP

DBL. OUTLET - WATERPROOF - (11) - 4 CIRCUITS

P.C# PLUG CIRCUIT NO - (4 CIRCUITS)

NOTE: ALL CONDUIT TO BE RIGID GALVANIZED.

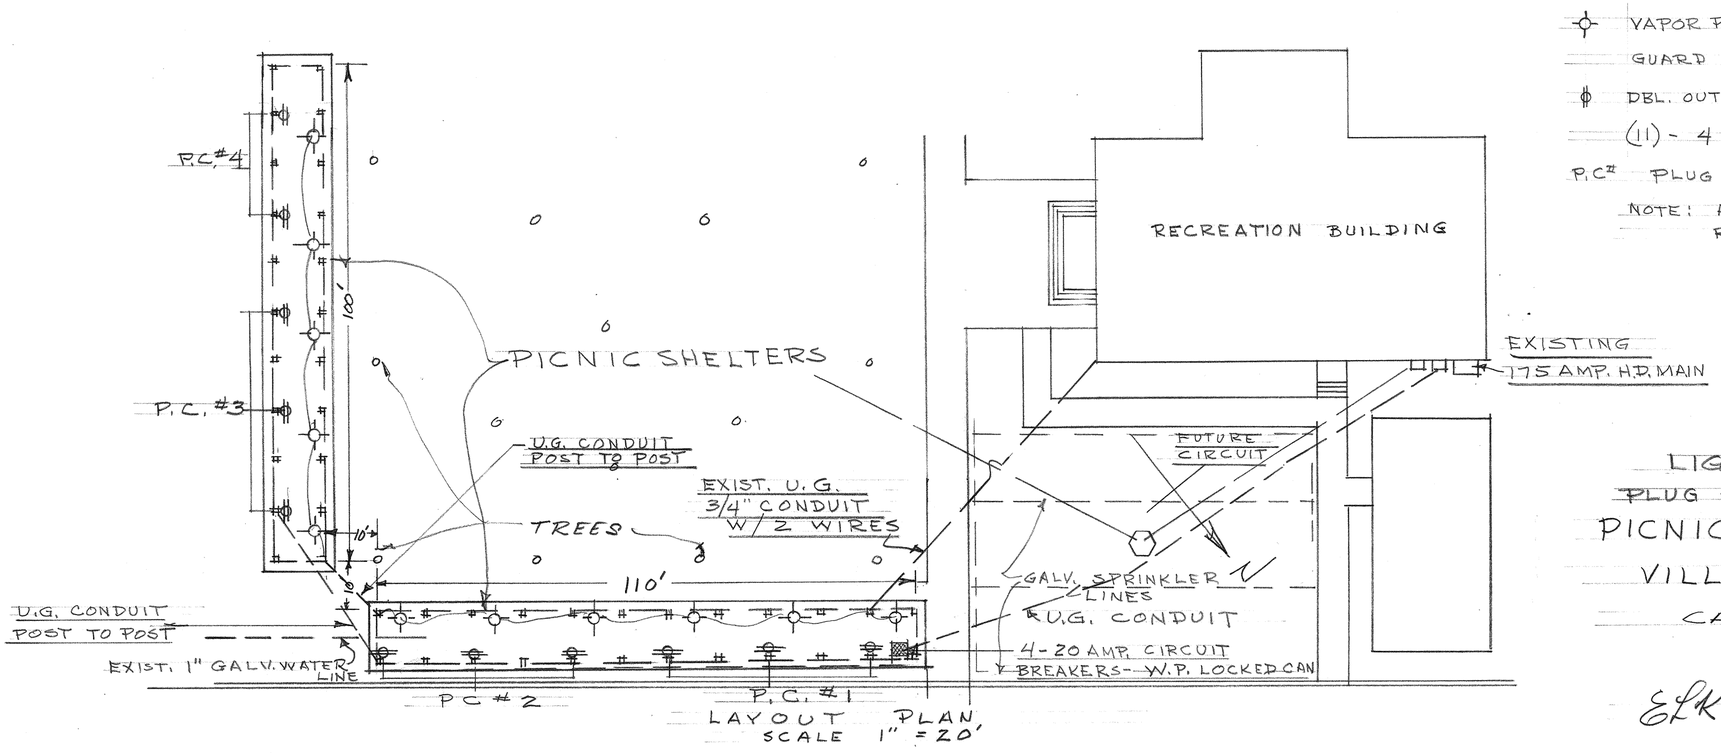

LAYOUT PLAN
SCALE 1" = 20'

LIGHTING & PLUG OUTLETS FOR
PICNIC SHELTERS
VILLEGAS PARK
CASA BLANCA

ELK

~~AUG. 6, 1954~~
APRIL 1, 1966

DRAWING NUMBER
VI-10

PLAN HOLD CORPORATION • IRVINE, CALIFORNIA
REORDER BY NUMBER 075AR

P-159-13