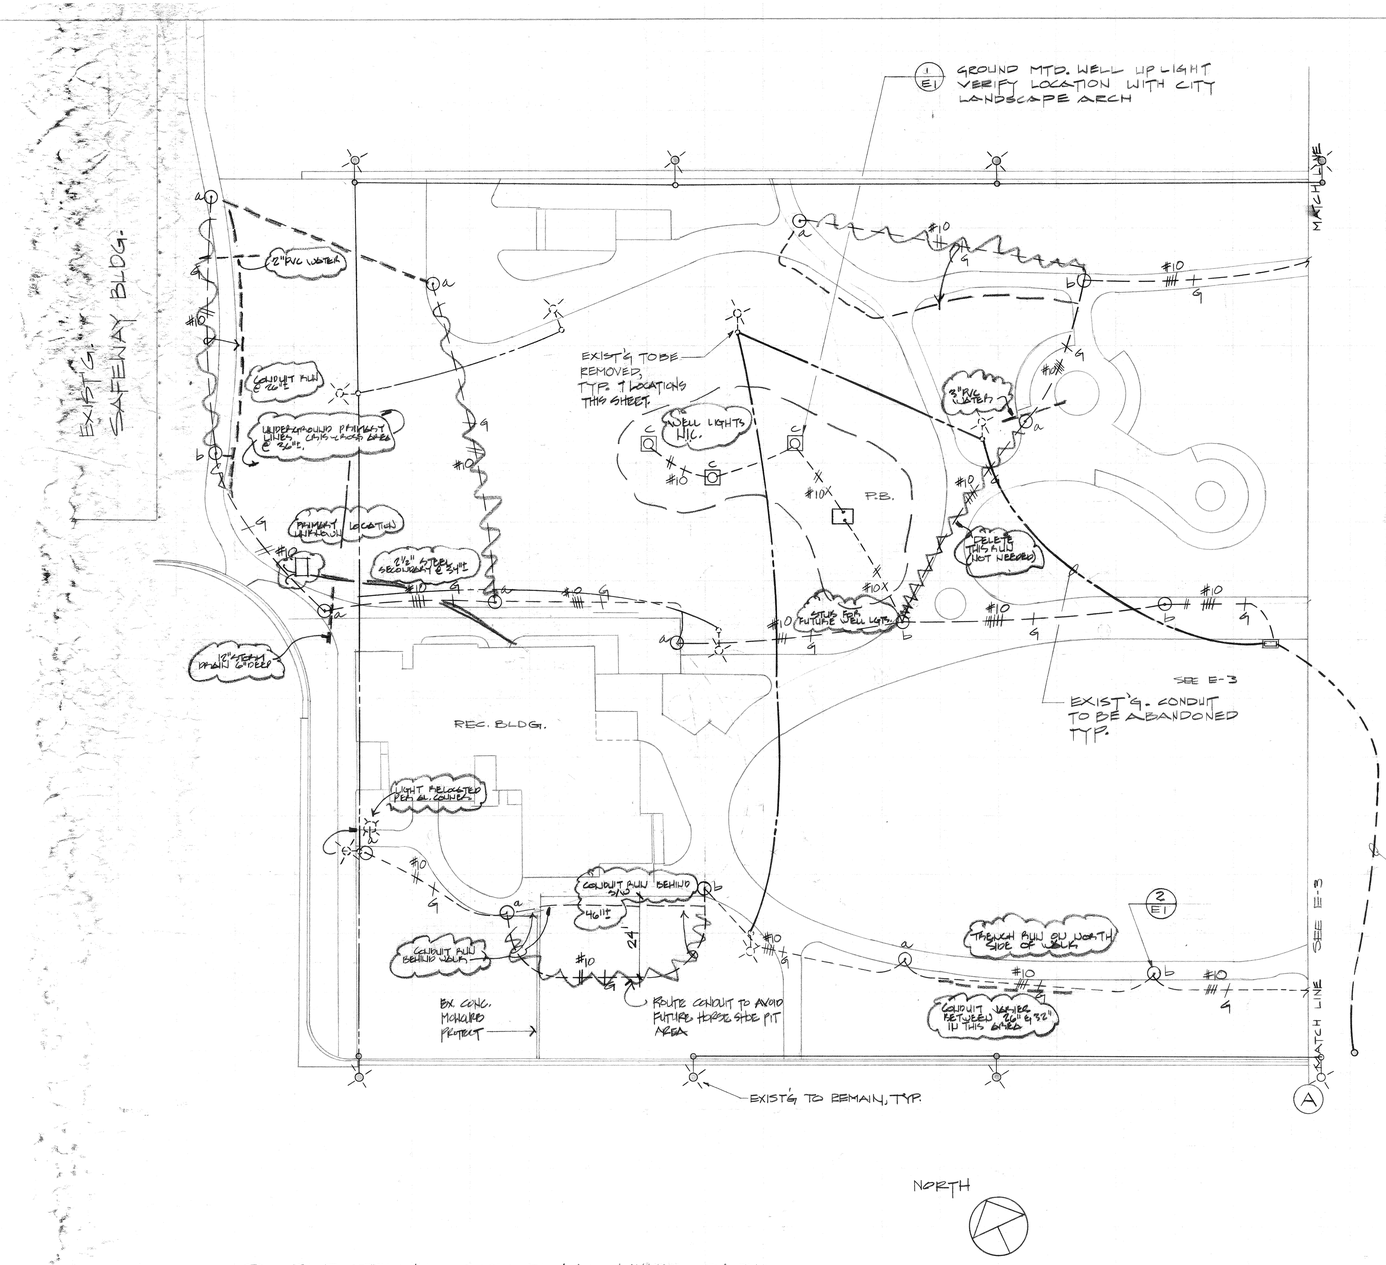

A ELECTRICAL SITE PLAN, WHITE PARK
SCALE: 1" = 20'-0"

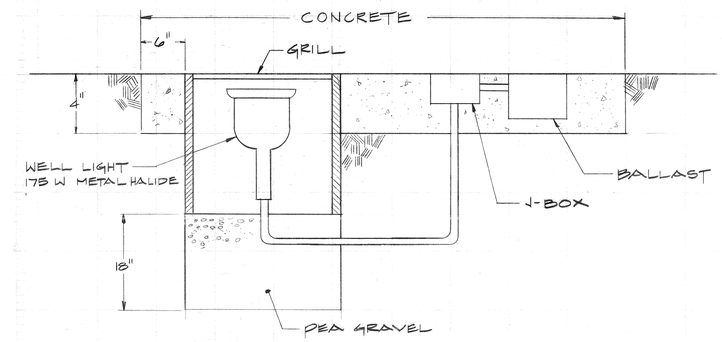

1/E1 WELL LIGHT DETAIL
IMPERIAL - BRONZELITE # G-5175-MV-CB OR EQUAL, 120V BALLAST

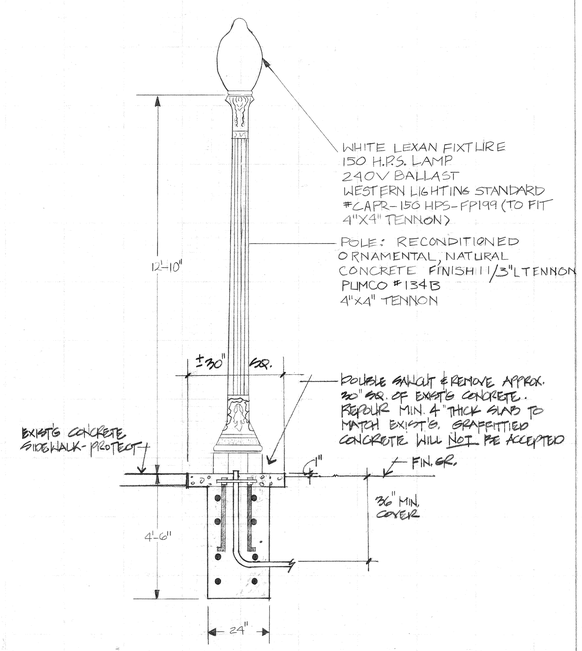

2/E1 SECURITY LIGHT DETAIL
N.T.S.

NOTES:

1. FINAL LIGHT STANDARD LOCATIONS TO BE VERIFIED AND APPROVED IN THE FIELD BY THE PARKS DEPT. REPRESENTATIVE PRIOR TO INSTALLATION/DIGGING FOR FOOTINGS.
2. CONDUIT ROUTING IN PROXIMITY TO EXISTING TREES SHALL BE AS APPROVED BY THE CITY.

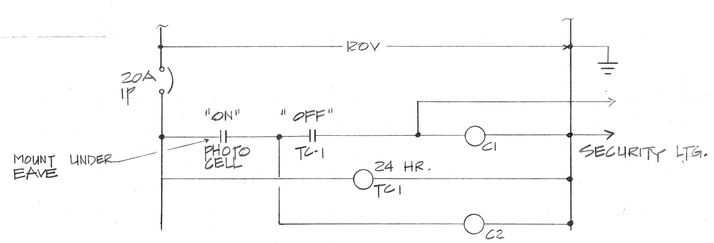

3/E1 CONTROL DIAGRAM

DENOTES AS-BUILT CONDITIONS.

AS-BUILT

MULLEN & ASSOCIATES INC.
CONSULTING ENGINEERS
1940 N. TUSTIN AVE., SUITE 113
ORANGE, CALIFORNIA 92665/714-637-6621

REGISTERED PROFESSIONAL ENGINEER LARRY D. MULLEN E 8279 ELECTRICAL STATE OF CALIFORNIA

RIVERSIDE PARK LIGHTING
CITY OF RIVERSIDE

WHITE PARK ELECTRICAL PLAN JOB # 8072A

REVISIONS

DATE:

SHEET E1 of 3

PLAN # P1010-A

DRAWING NUMBER

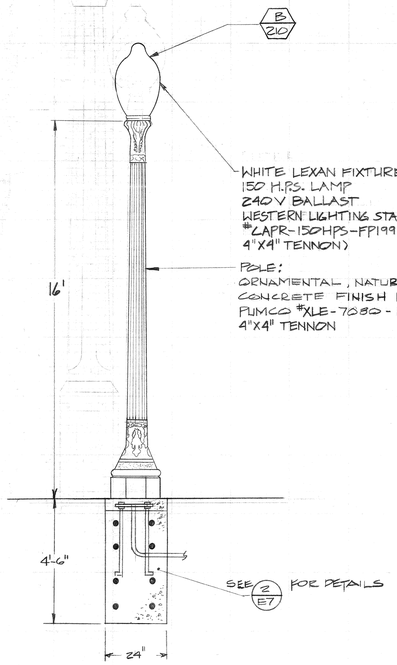

1/E7 SECURITY LIGHT DETAIL
N.T.S.

NOTES:

1. FINAL LIGHT STANDARD LOCATIONS TO BE VERIFIED AND APPROVED IN THE FIELD BY THE PARKS DEPT. REPRESENTATIVE PRIOR TO INSTALLATION/DIGGING FOR FOOTINGS.
2. CONDUIT ROUTING IN PROXIMITY TO EXISTING TREES SHALL BE AS APPROVED BY THE CITY.

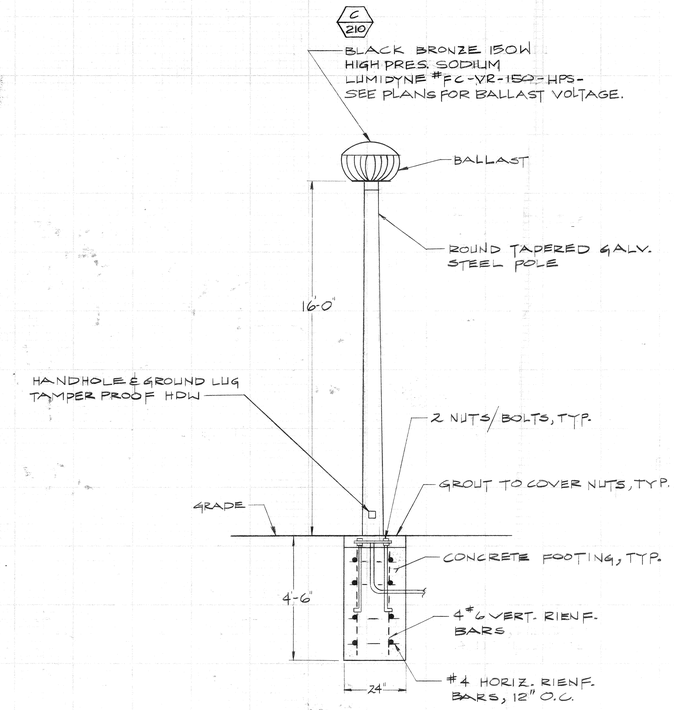

2/E7 PARKING/WALKWAY LIGHT DETAIL
N.T.S.

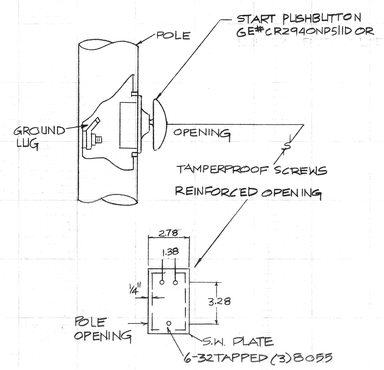

1/E5 HARD COURT PUSHBUTTON DETAIL
N.T.S.

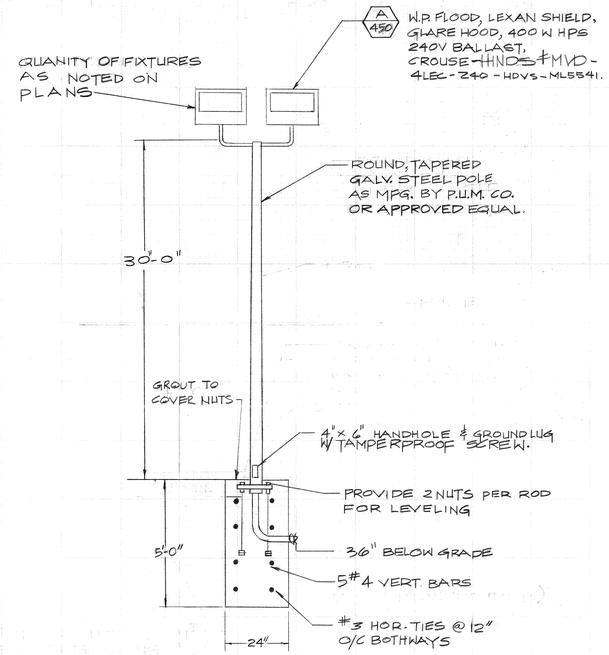

2/B4 FLOODLIGHT/HARD COURT LIGHTING DETAIL
NTS

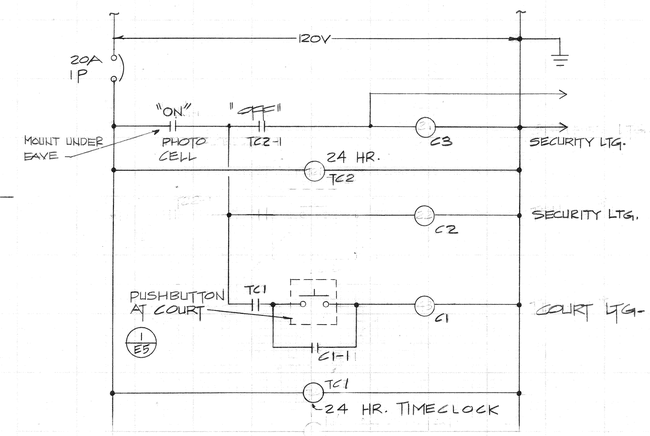

3/E4 LIGHT CONTROL DIAGRAM (BORDWELL PARK)
NO SCALE (TYP FOR WHITE, REID, SHAMEL)

MULLEN & ASSOCIATES INC.
CONSULTING ENGINEERS
1940 N. TUSTIN AVE., SUITE 113
ORANGE, CALIFORNIA 92665/714-637-6621

REGISTERED PROFESSIONAL ENGINEER
LARRY D. MULLEN
E 8029
ELECTRICAL
STATE OF CALIFORNIA

RIVERSIDE PARK LIGHTING
CITY OF RIVERSIDE

ELECTRICAL PLAN JOB# 8072

REVISIONS

DATE:

SHEET
E3
OF 3

PLAN# P-1010

DRAWING NUMBER
PLAN-REDI CORPORATION • RIVERSIDE, CALIFORNIA
REORDER BY NUMBER 1-800-421-7526